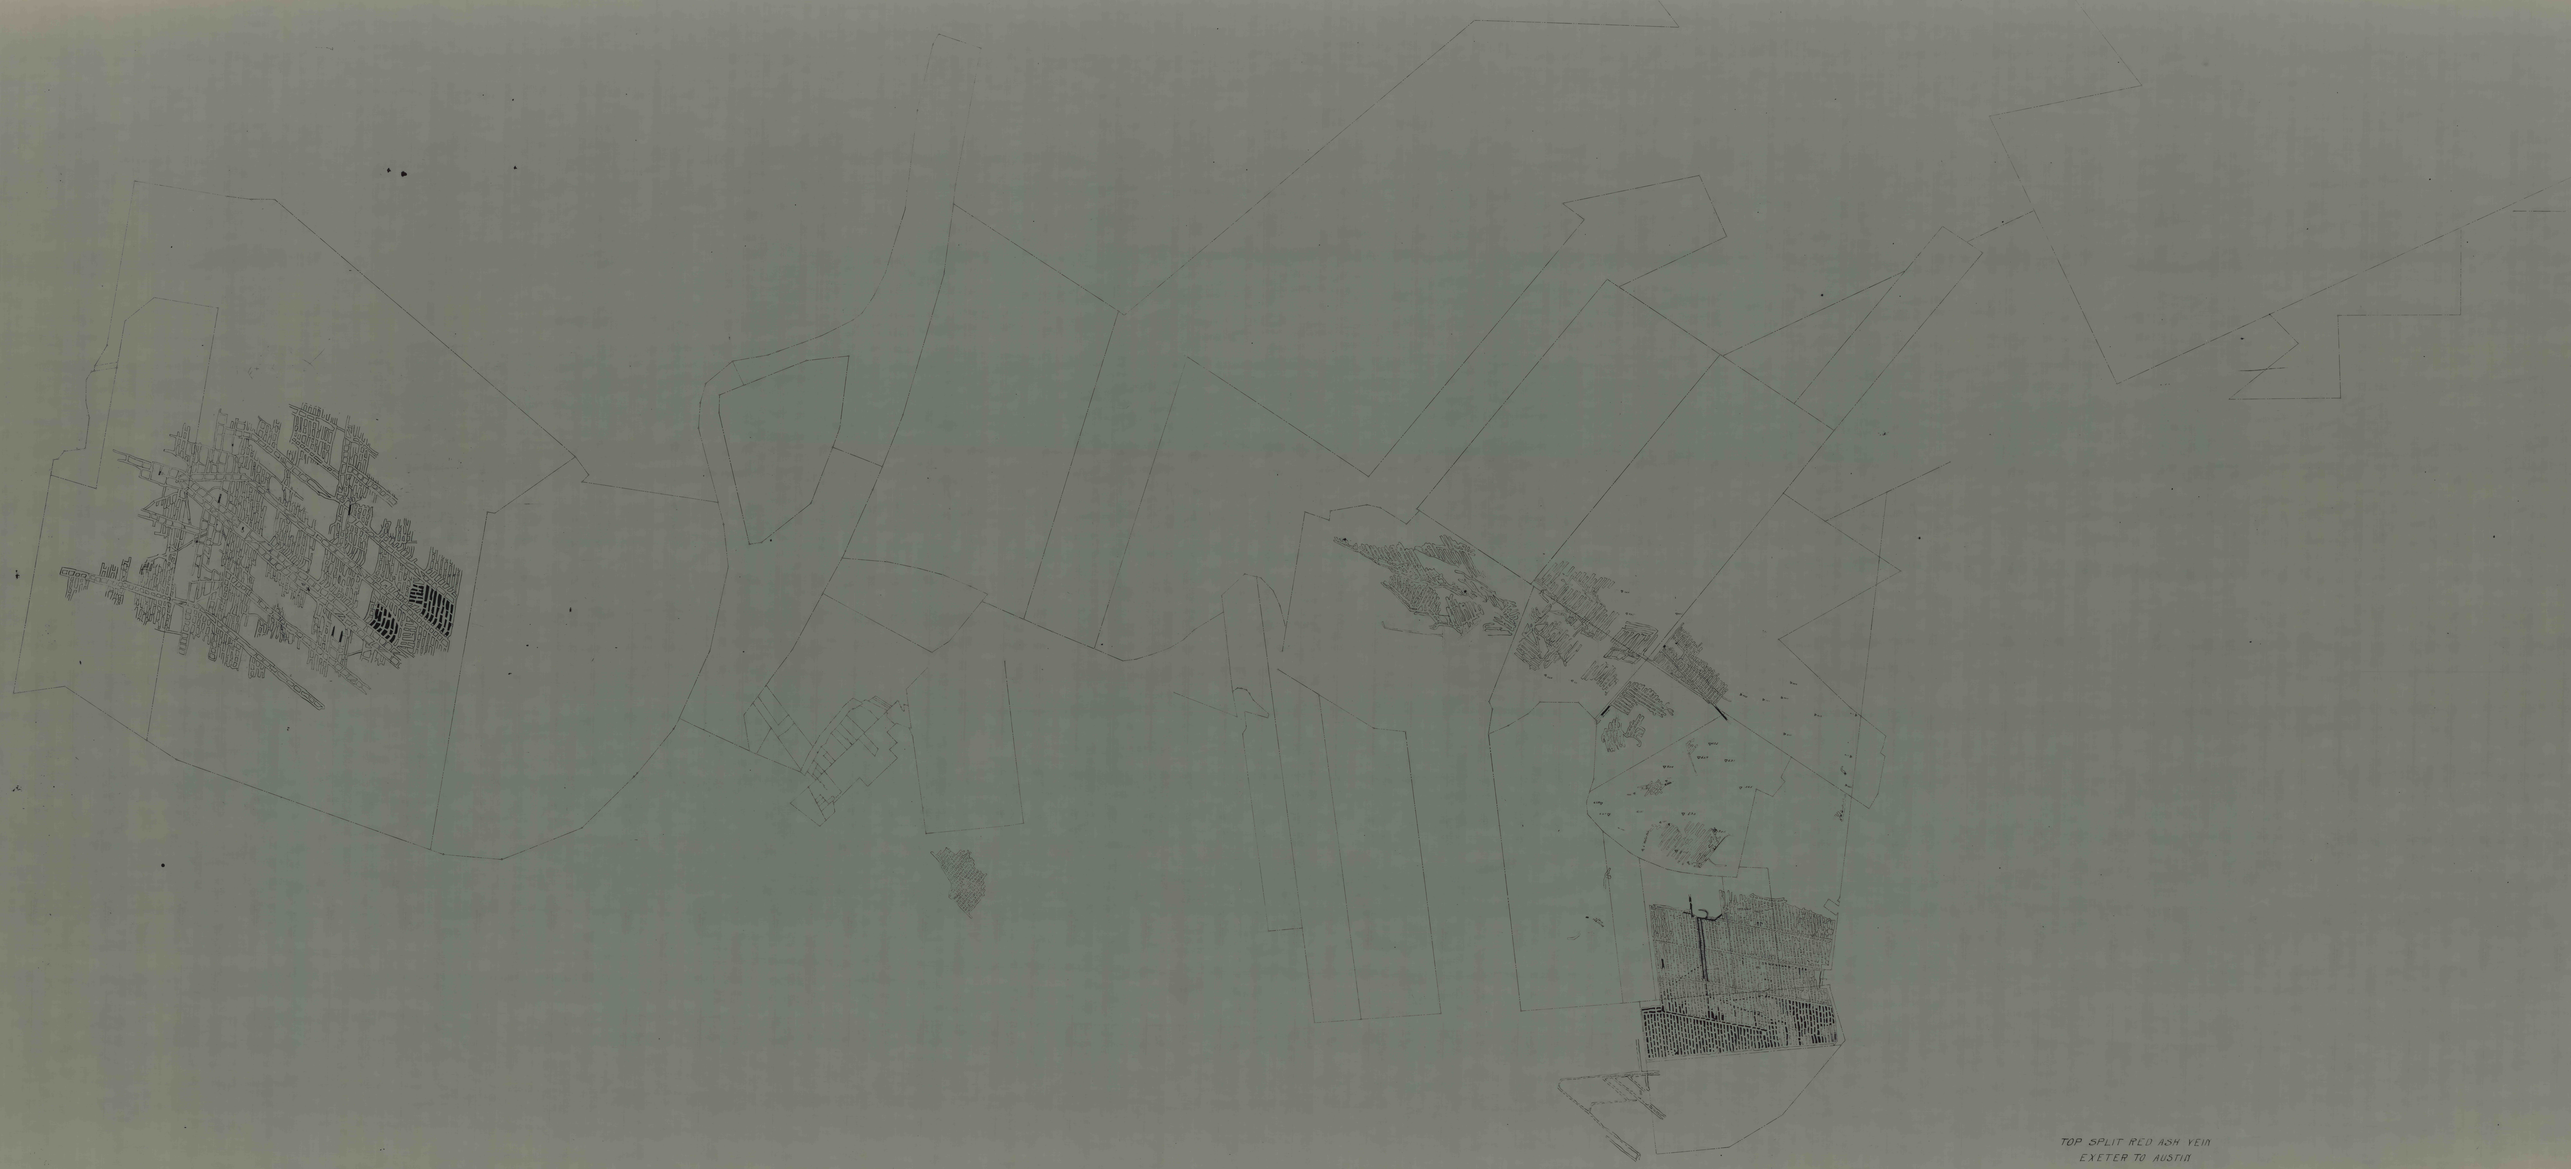

TOP SPLIT RED ASH VEIN
EXETER TO AUSTIN