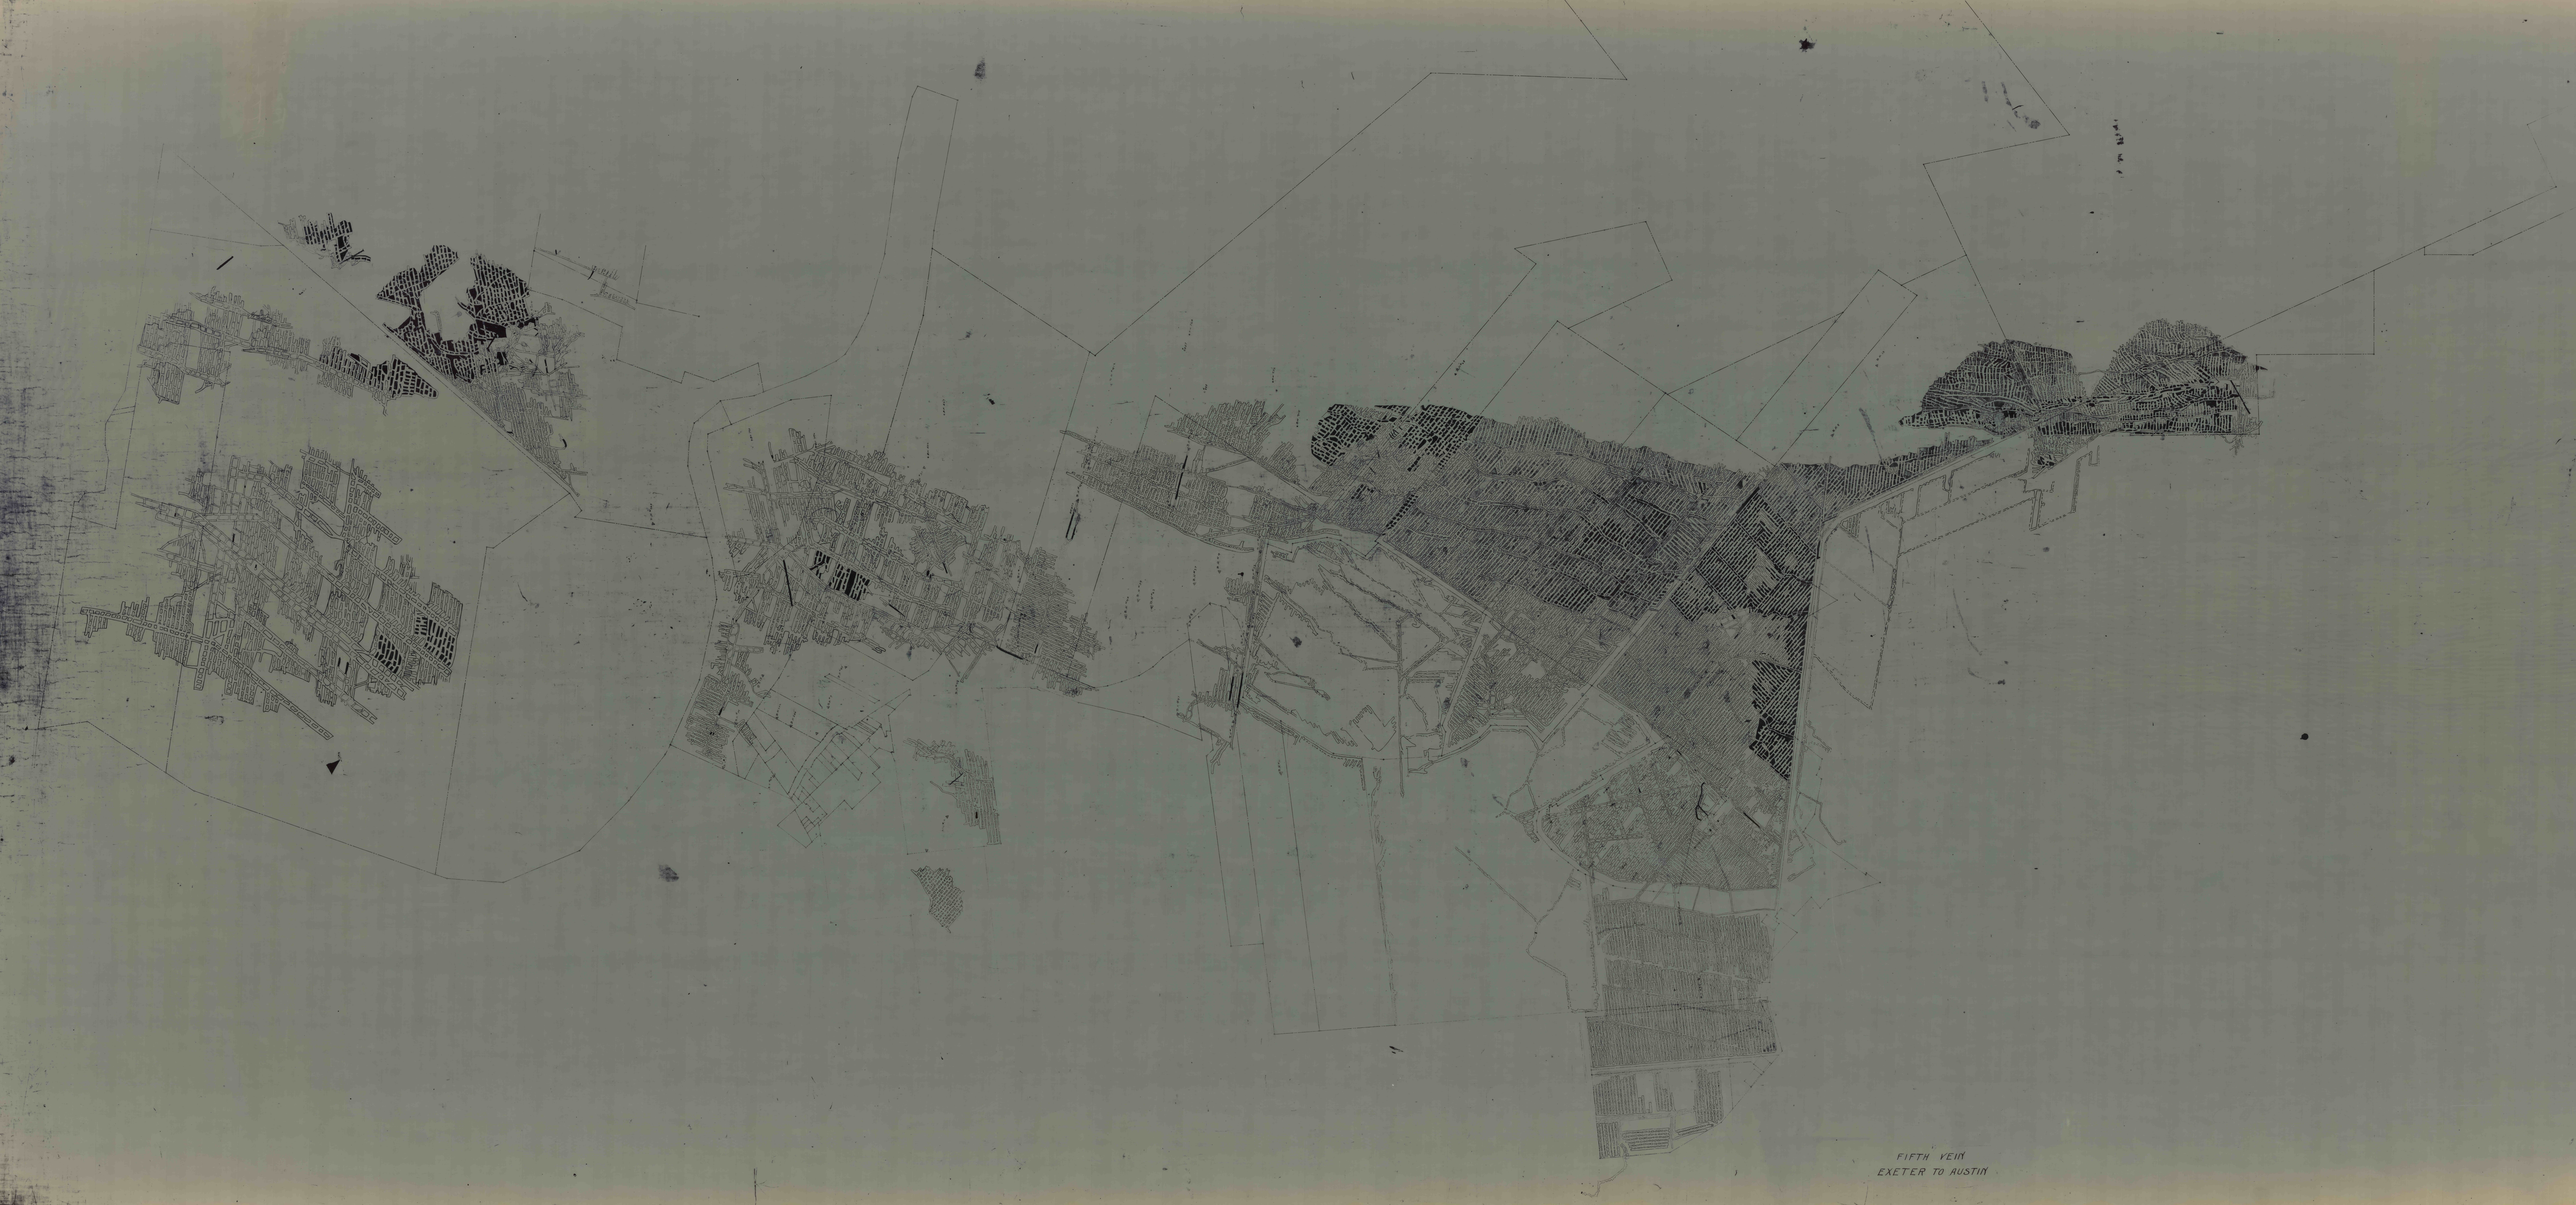
FIFTH VEIN
EXETER TO AUSTIN