


SIBBLEY

MARCY VEIN

ON

AUSTIN LEASE

DATUM = TIDE

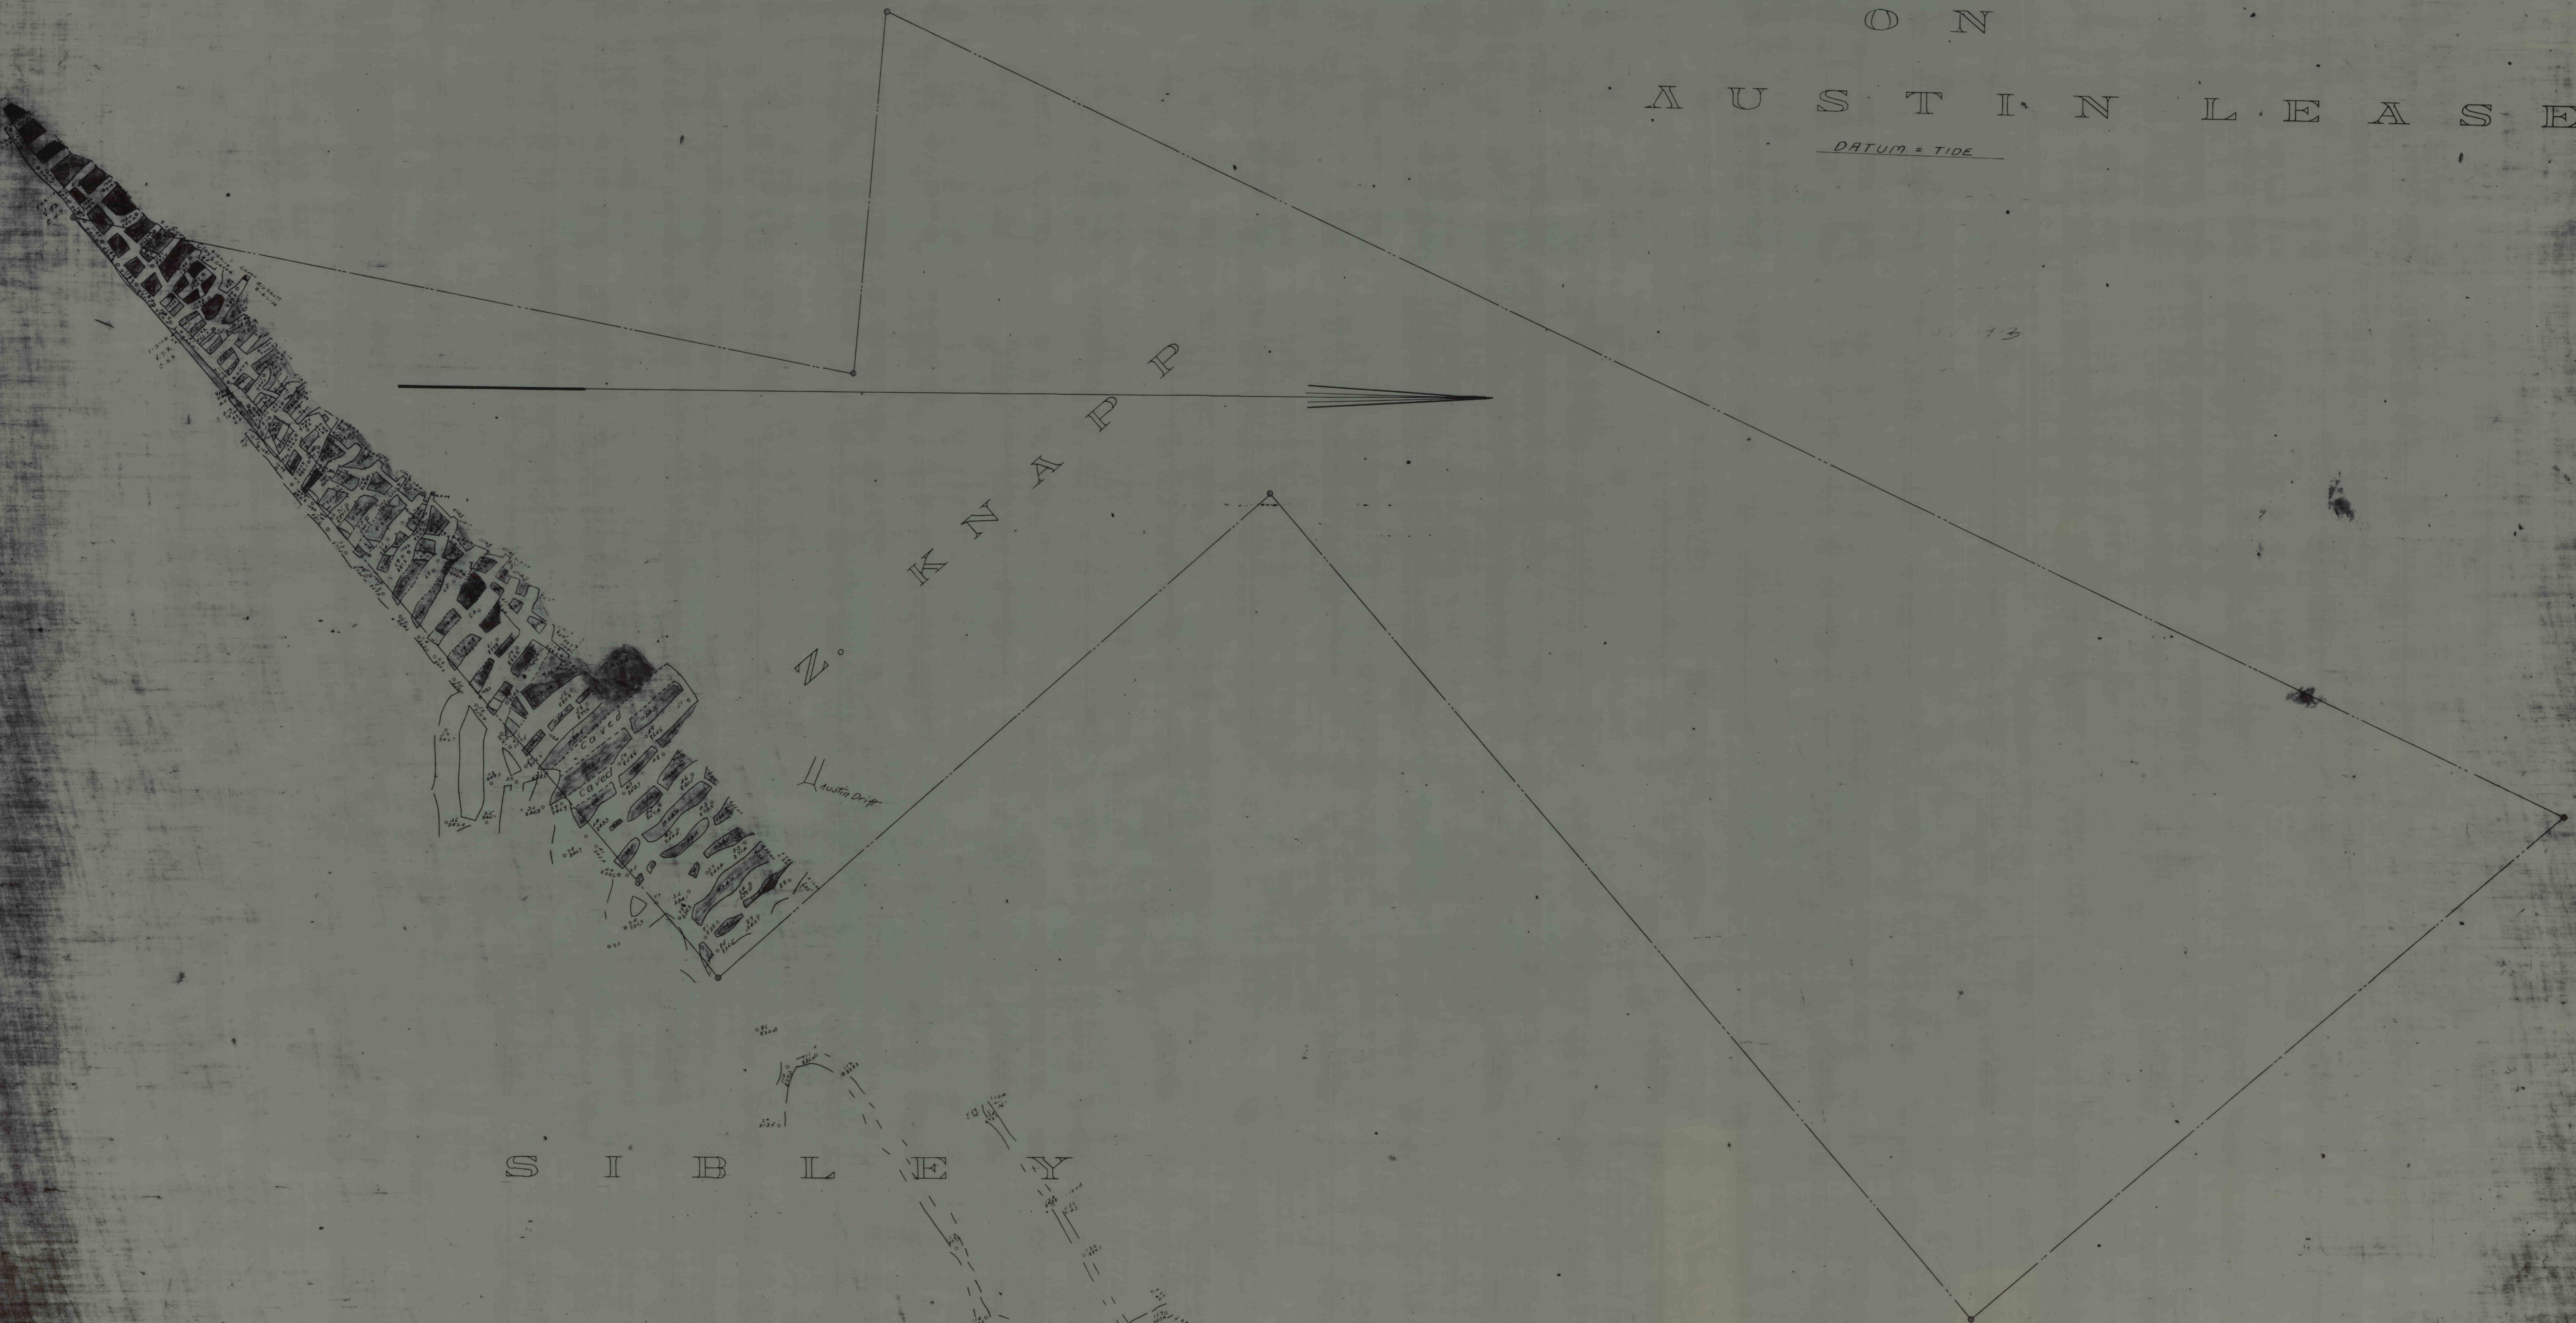

SIBBLEY