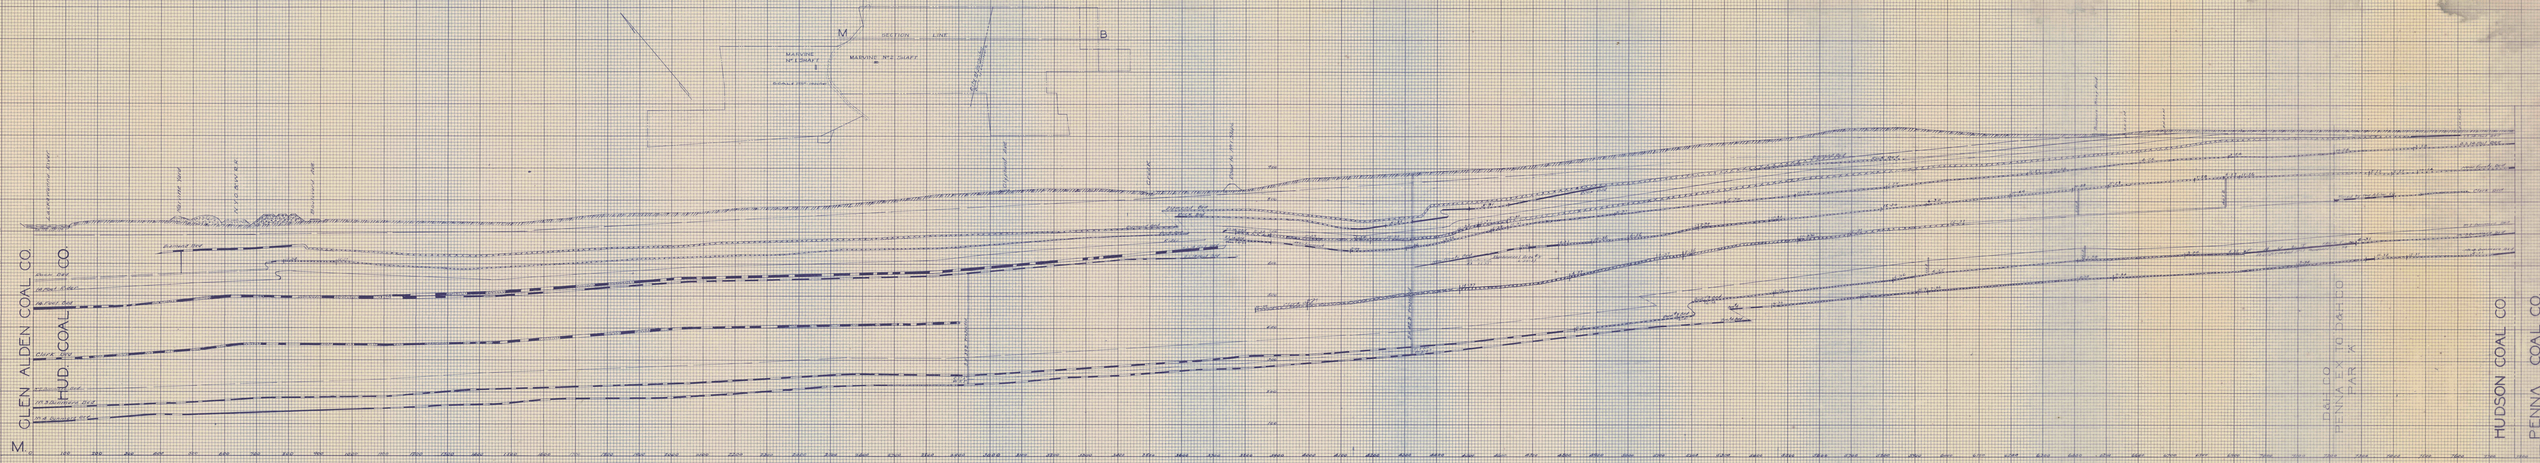

MARVINE COLLIERY
CROSS SECTION THROUGH COAL MEASURES
LOOKING N. E.
SCALE 1 INCH = 100 FEET
LINE M-B