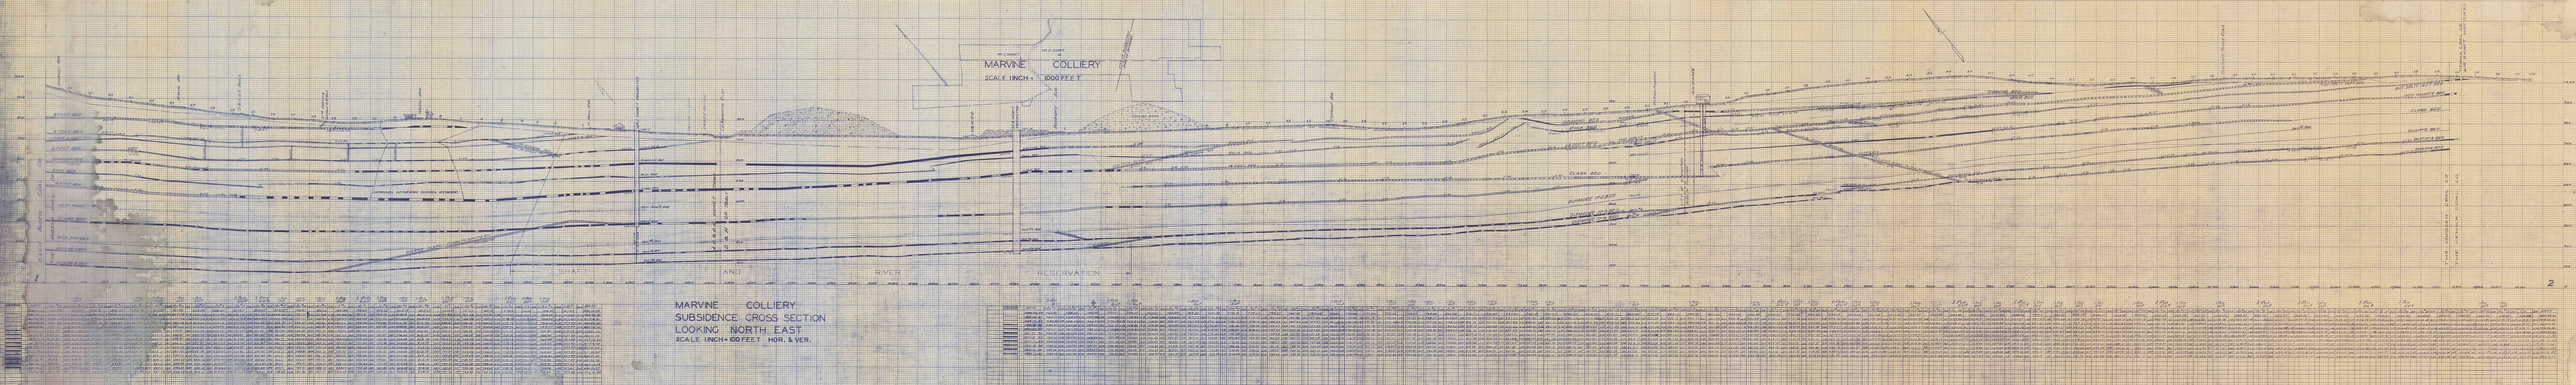

MARVINE COLLIERY
SUBSIDENCE CROSS SECTION
LOOKING NORTH EAST
SCALE 1 INCH = 100 FEET HOR. & VER.