


LUZERNE COAL CO. D.L. & W. LESSEE
 LACKAWANNA VALLEY D.L. & W. FEE
 CAYUGA & SUSQUEHANNA D.L. & W. FEE

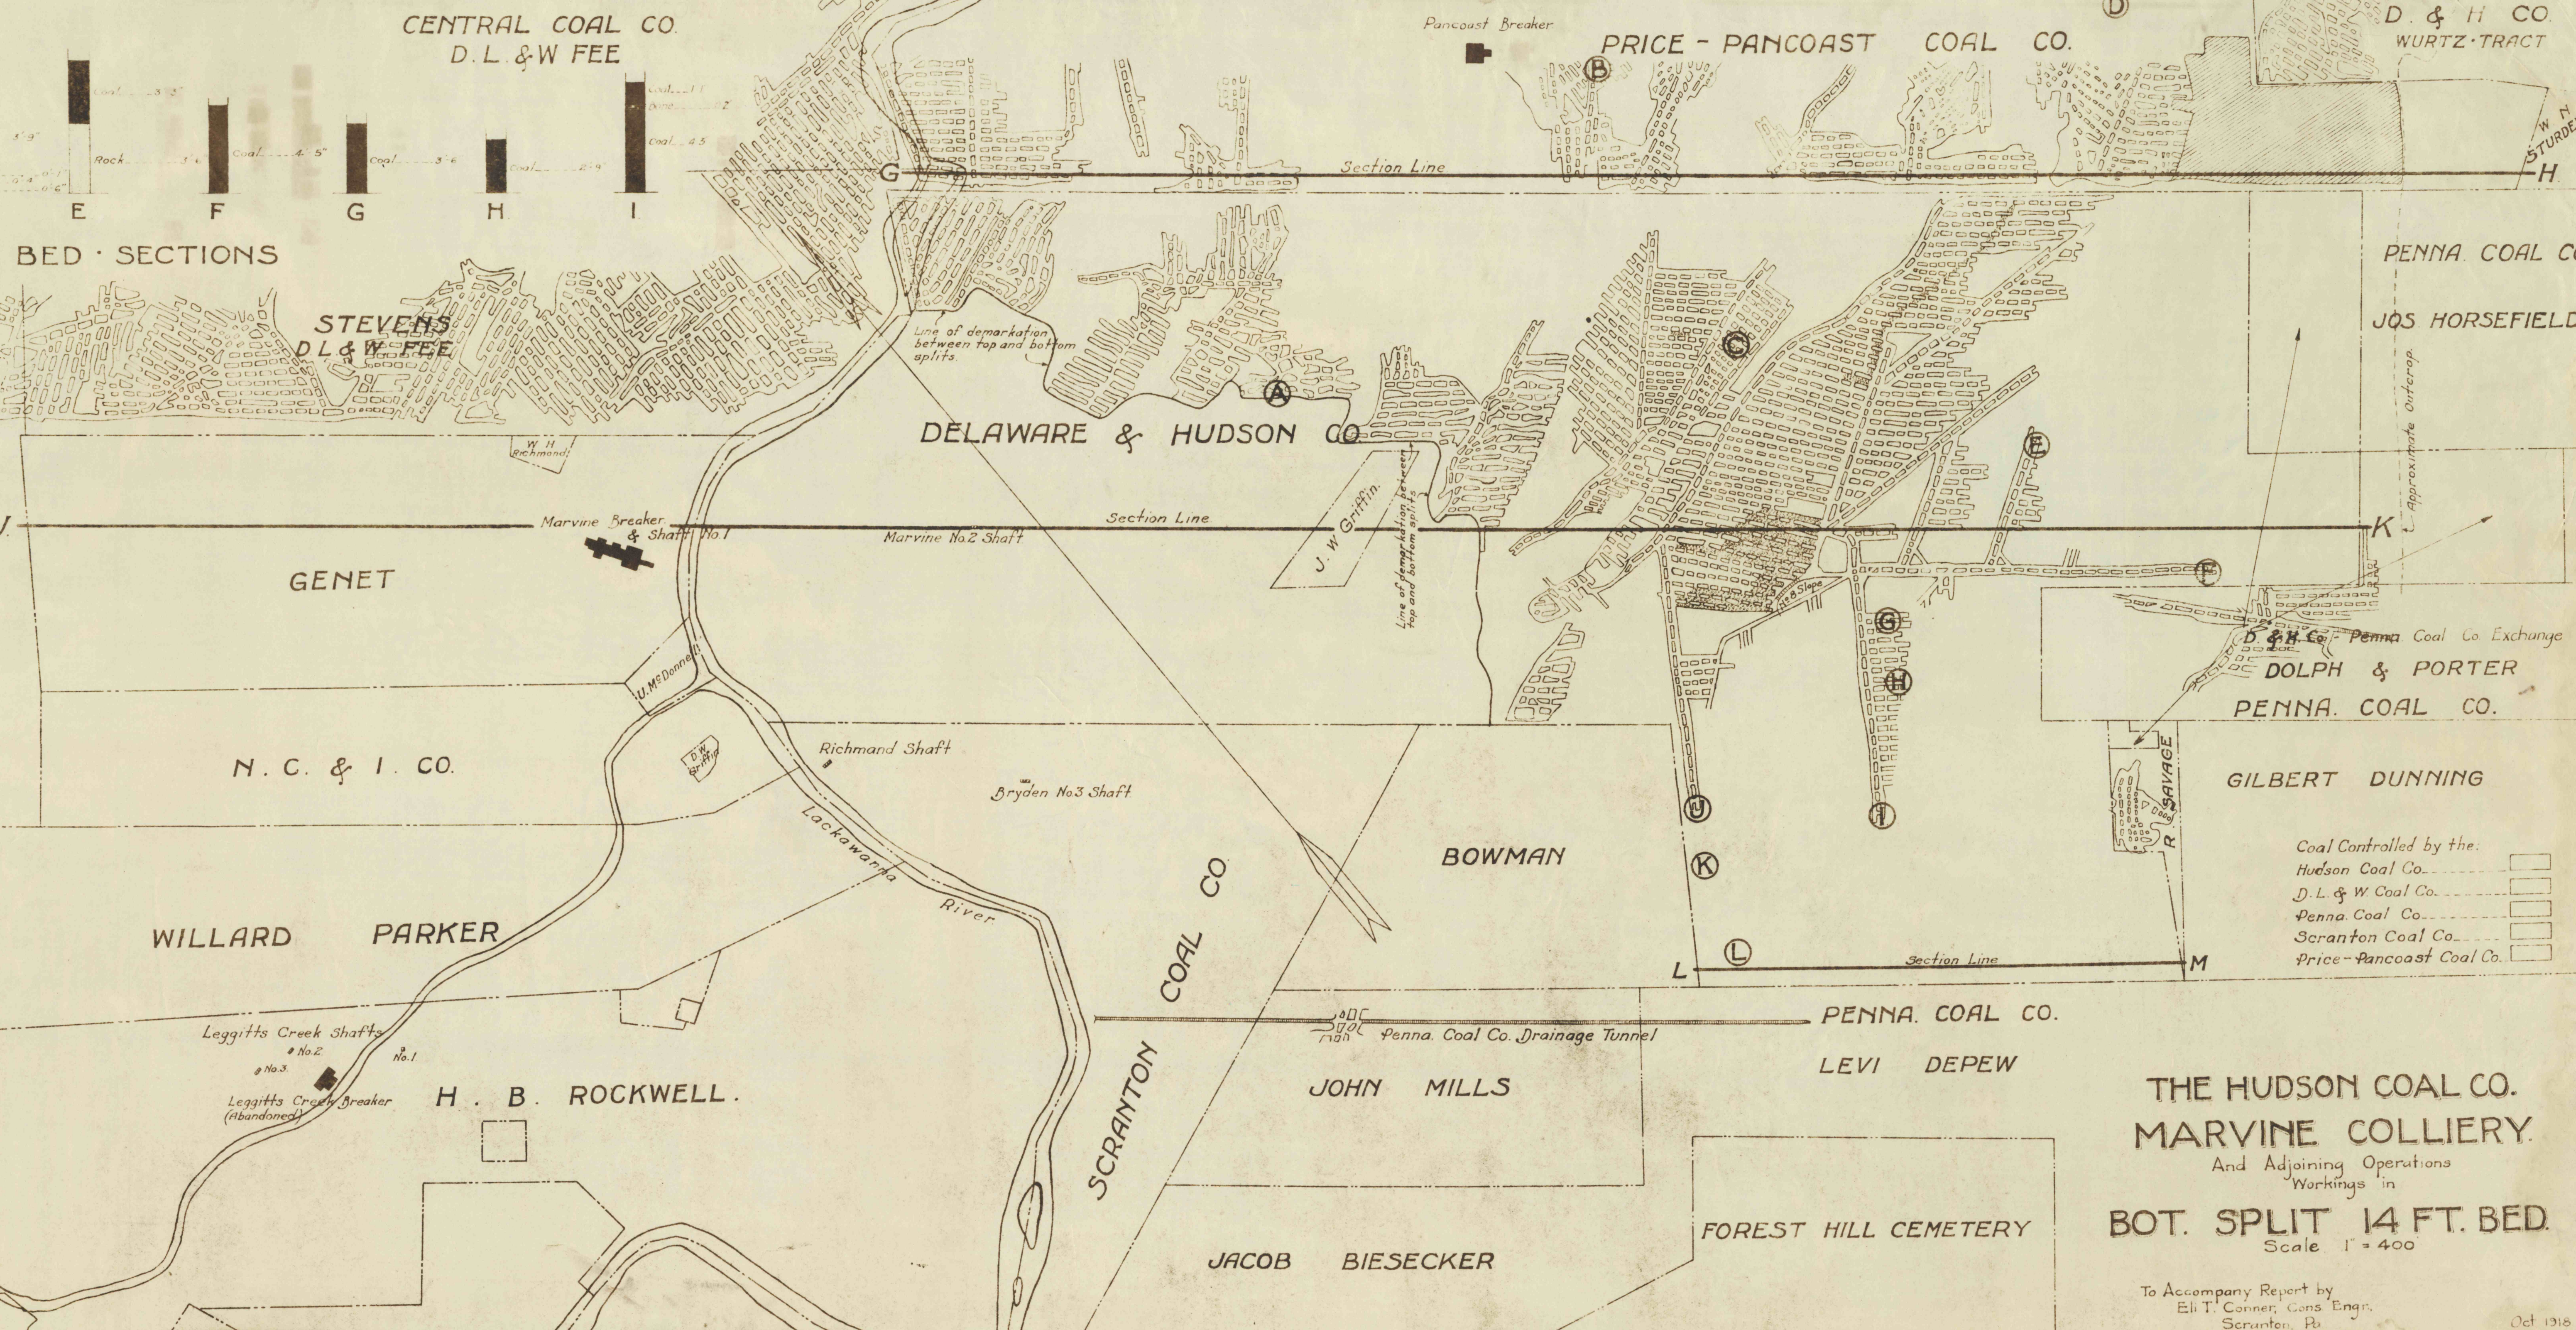

Coal Controlled by the:

Hudson Coal Co.	<input type="checkbox"/>
D. L. & W. Coal Co.	<input type="checkbox"/>
Penna. Coal Co.	<input type="checkbox"/>
Scranton Coal Co.	<input type="checkbox"/>
Price-Pancoast Coal Co.	<input type="checkbox"/>

BOT. SPLIT 14 FT. BED.
 Scale 1" = 400'