



CENTRAL COAL CO.  
D. L & W FEE.

PRICE - PANCOAST COAL CO.  
Section Line

D & H CO.  
WURTZ TRACT.

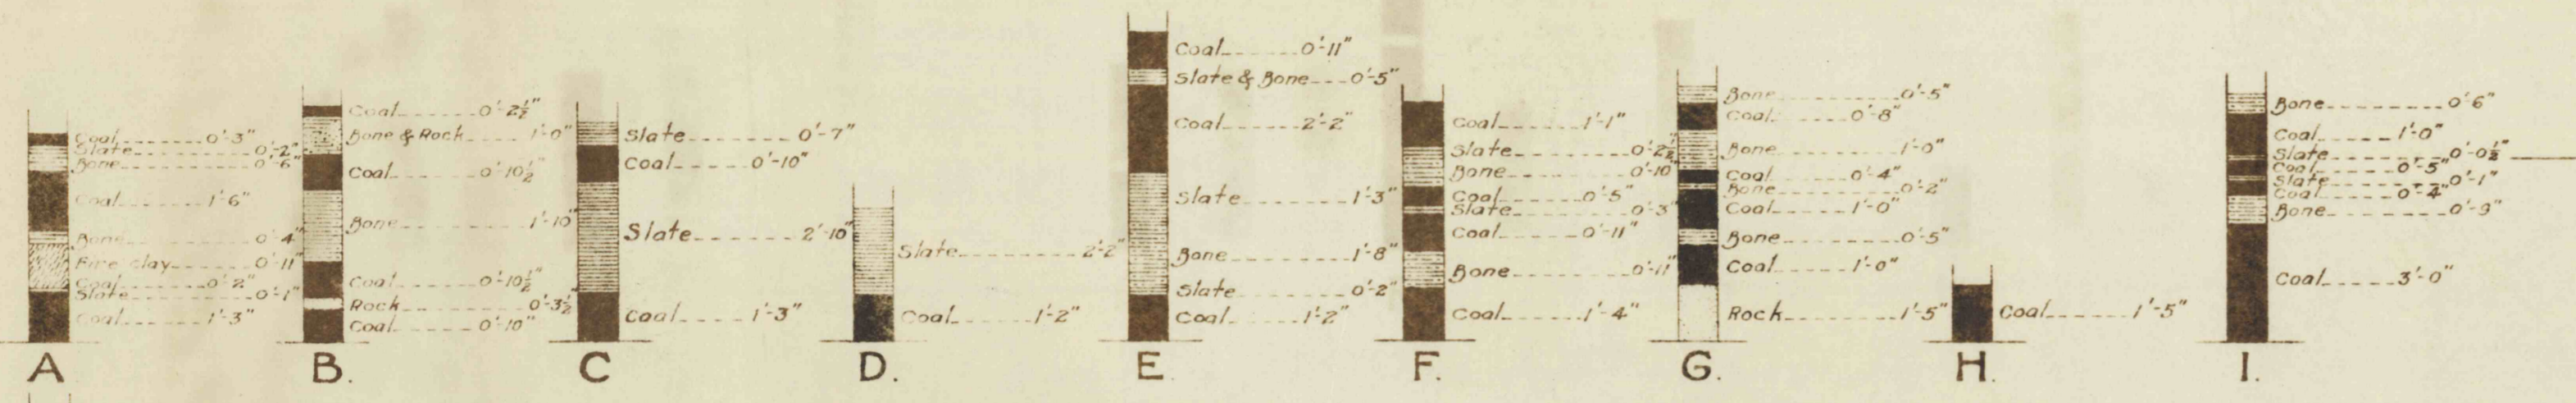

LUZERNE COAL CO.  
D. L & W LESSEE

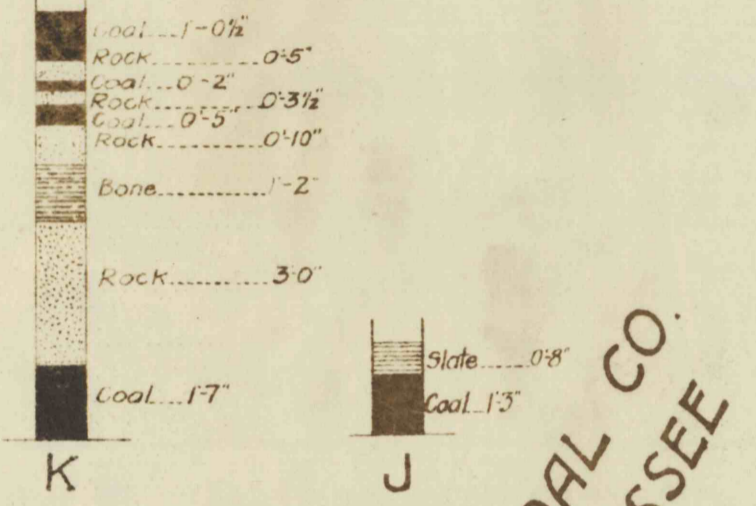

LACKAWANNA VALLEY  
D. L & W FEE  
COAL CO.

CAYUGA & SUSQUEHANNA  
D. L & W FEE

Storrs No. 3 Shaft

W. H. Richmond

Marvine Breaker & Shaft No. 1

Marvine No. 2 Shaft

J. W. Griffin

U. Medoigne

Richmond Shaft

GENET

N. C. & I CO.

WILLARD

PARKER

Leggitts Creek

Leggitts Creek Shafts

No. 1, No. 2, No. 3

Leggitts Creek Breaker (Abandoned)

H. B. ROCKWELL

Plane No. 9

Approximate Workable Limit

Approximate Workable Limit

Scranton River

Scranton Coal Co.

BOWMAN

JOHN MILLS

SCRANTON COAL CO.

BRYDEN No. 3 Shaft

Section Line






































THE HUDSON COAL CO.

MARVINE COLLIERY.

And Adjoining Operations

Workings in

NEW COUNTY BED.

Scale 1" = 400'

LEGEND

Rock Fill

FOREST HILL CEMETERY

JACOB BIESECKER















To Accompany Report by

Eli T. Conner, Cons. Engr.

Scranton, Pa.

Oct 1918

Section Line

Section Line

