


**CENTRAL COAL CO.
D. L. & W. FEE**

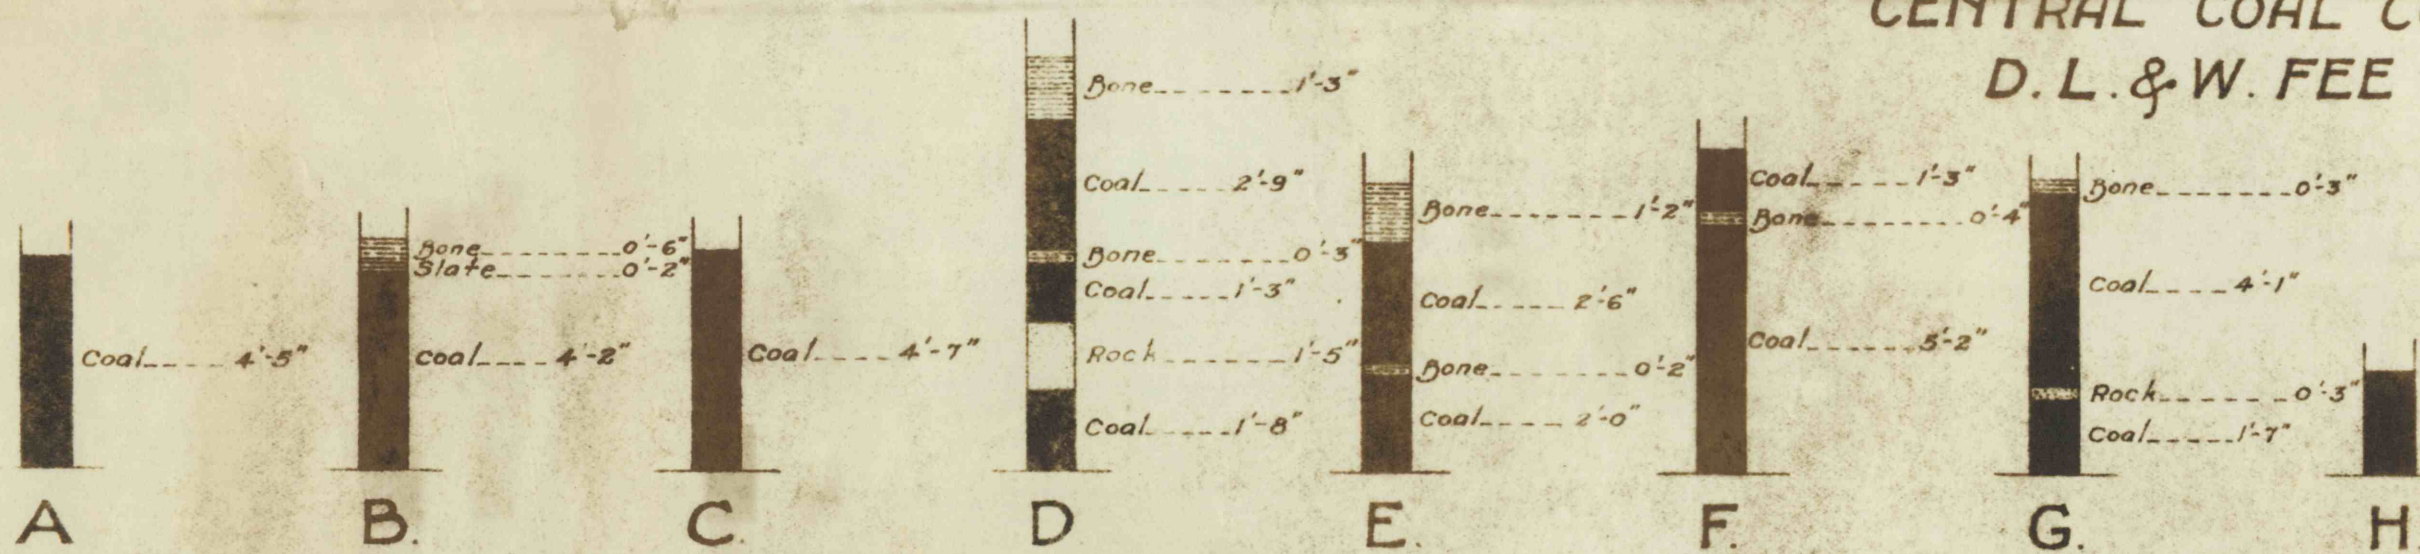

BED SECTIONS.



**LUZERNE COAL CO.
D. L. & W. LESSEE**

**LACKAWANNA VALLEY
D. L. & W. FEE
COAL CO.**

**CAYUGA & SUSQUEHANNA
D. L. & W. FEE**

**STEVENS
D. L. & W. FEE**

N. C. & L. CO.

WILLARD PARKER

H. B. ROCKWELL

**STEVENS
D. L. & W. FEE**

N. C. & L. CO.

WILLARD PARKER

H. B. ROCKWELL

PRICE - PANCOAST COAL CO.

DELAWARE & HUDSON CO.

BOWMAN

JOHN MILLS

JACOB BIESECKER

PRICE - PANCOAST COAL CO.

DELAWARE & HUDSON CO.

BOWMAN

JOHN MILLS

JACOB BIESECKER

**D. & H. CO.
WURTZ TRACT.**

**PENNA. COAL CO.
JOS. HORSEFIELD**

**DOLPH & PORTER
PENNA. COAL CO.**

GILBERT DUNNING

**THE HUDSON COAL CO
MARVINE COLLIERY**

CLARK BED

Scale 1"=400'

To Accompany Report by
Eli T. Conner, Cons. Engr.,
Scranton, Pa. Oct. 1918.

LEGEND

- Rock Fill
- Culm Fill

D. & H. Co. - Penna. Coal Co. Exchange

DOLPH & PORTER
PENNA. COAL CO.

GILBERT DUNNING

Coal controlled by the
Hudson Coal Co
D. L. & W. Coal Co
Penna. Coal Co
Scranton Coal Co
Price-Pancoast Coal Co




