

D. & H. CO.
WURTZ TRACT.

CENTRAL COAL CO.
D.L. & W. FEE.

PRICE - PANCOAST COAL CO.

PENNA. COAL CO.

DELAWARE & HUDSON CO.

PENNA. COAL CO. Exchange
DOLPH & PORTER


GILBERT DUNNING

THE HUDSON COAL CO
MARVINE COLLIERY

And Adjoining Operations
Workings in
No. 3 DUNMORE BED
Scale 1"=400'

To Accompany Report by
Eli T. Conner, Cons. Engr.,
Scranton, Pa.

Oct. 1918


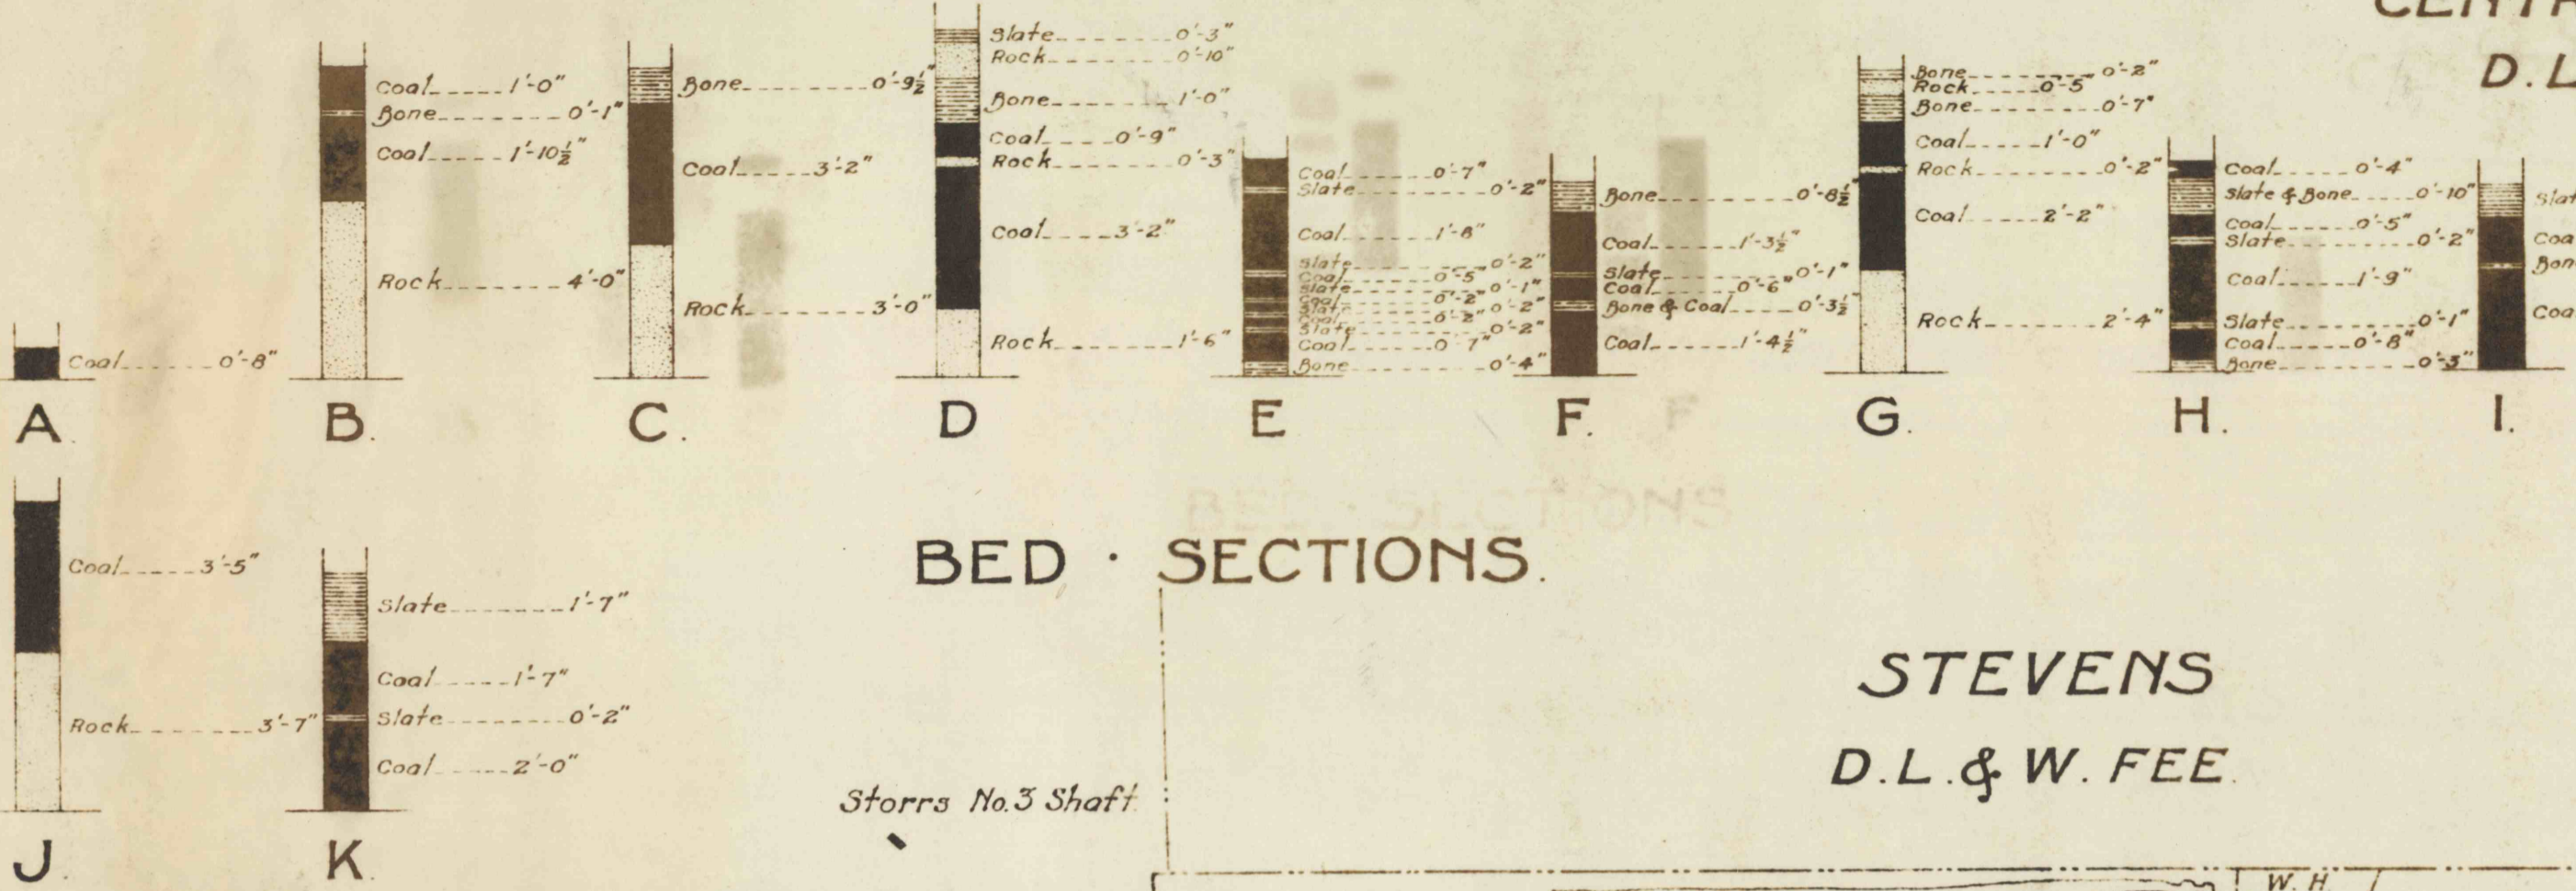


BED SECTIONS.

STEVENS
D.L. & W. FEE

Storrs No. 3 Shaft

LUZERNE COAL CO.
D.L. & W. LESSEE

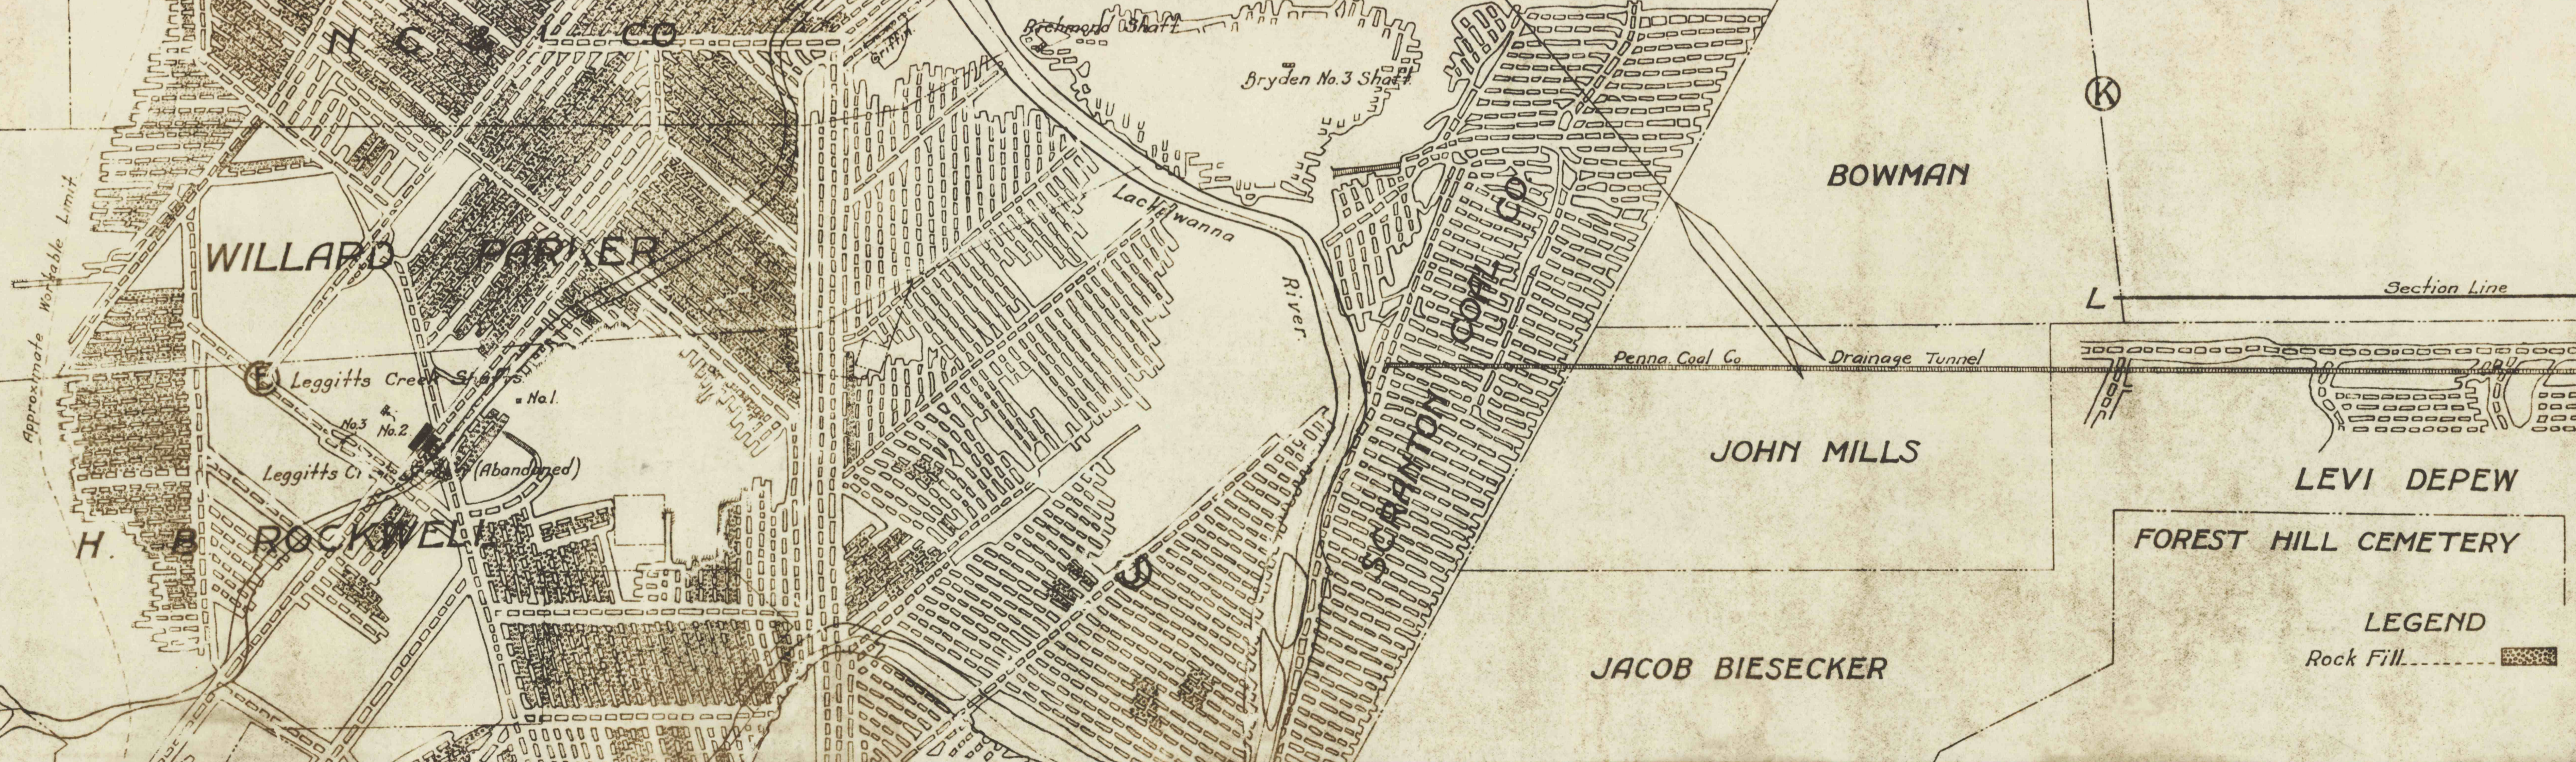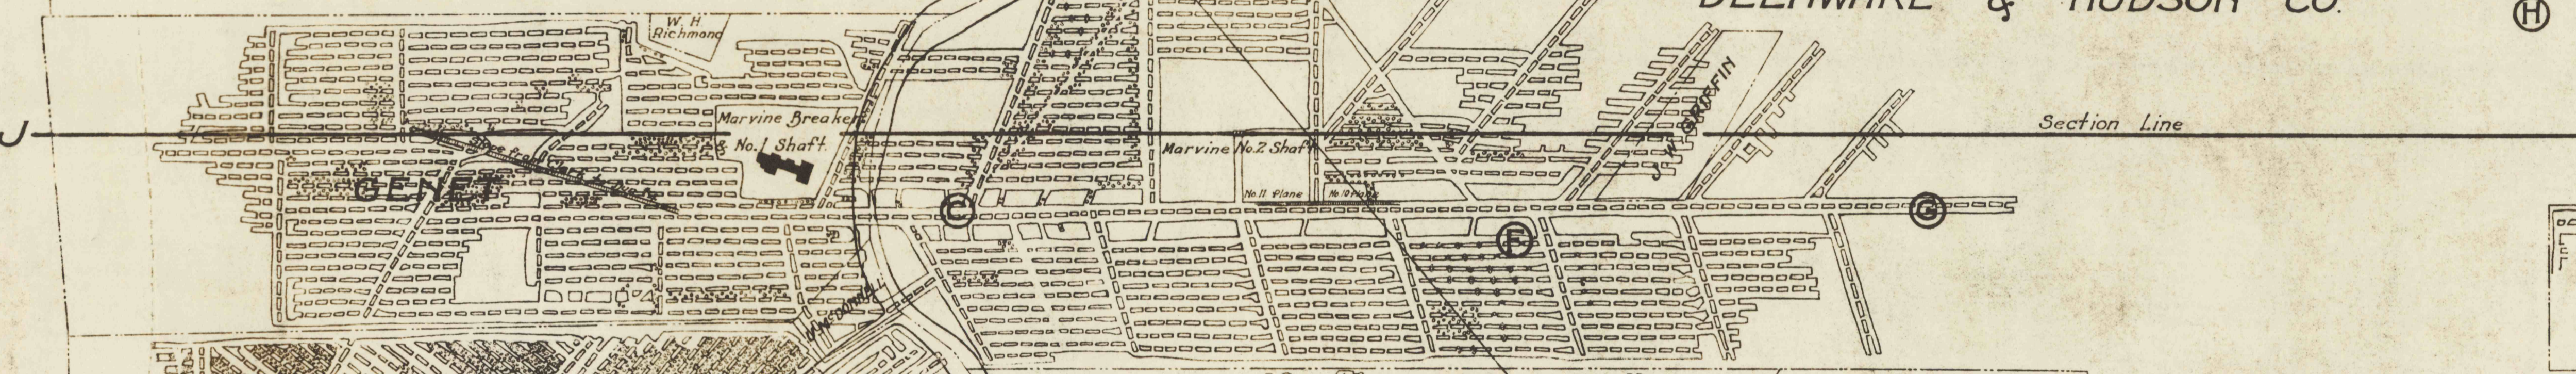

LEGEND
Rock Fill

FOREST HILL CEMETERY

JACOB BIESECKER

JOHN MILLS

BOWMAN

WILLARD PARKER

ROCKWELL

VALLEY COAL CO.

CAYUGA & SUSQUEHANNA
D.L. & W. FEE

LACKAWANNA








