


CENTRAL COAL CO.
D. L. & W. FEE

PRICE - PANCOAST COAL CO.

D. & H. CO.
WURTZ TRACT

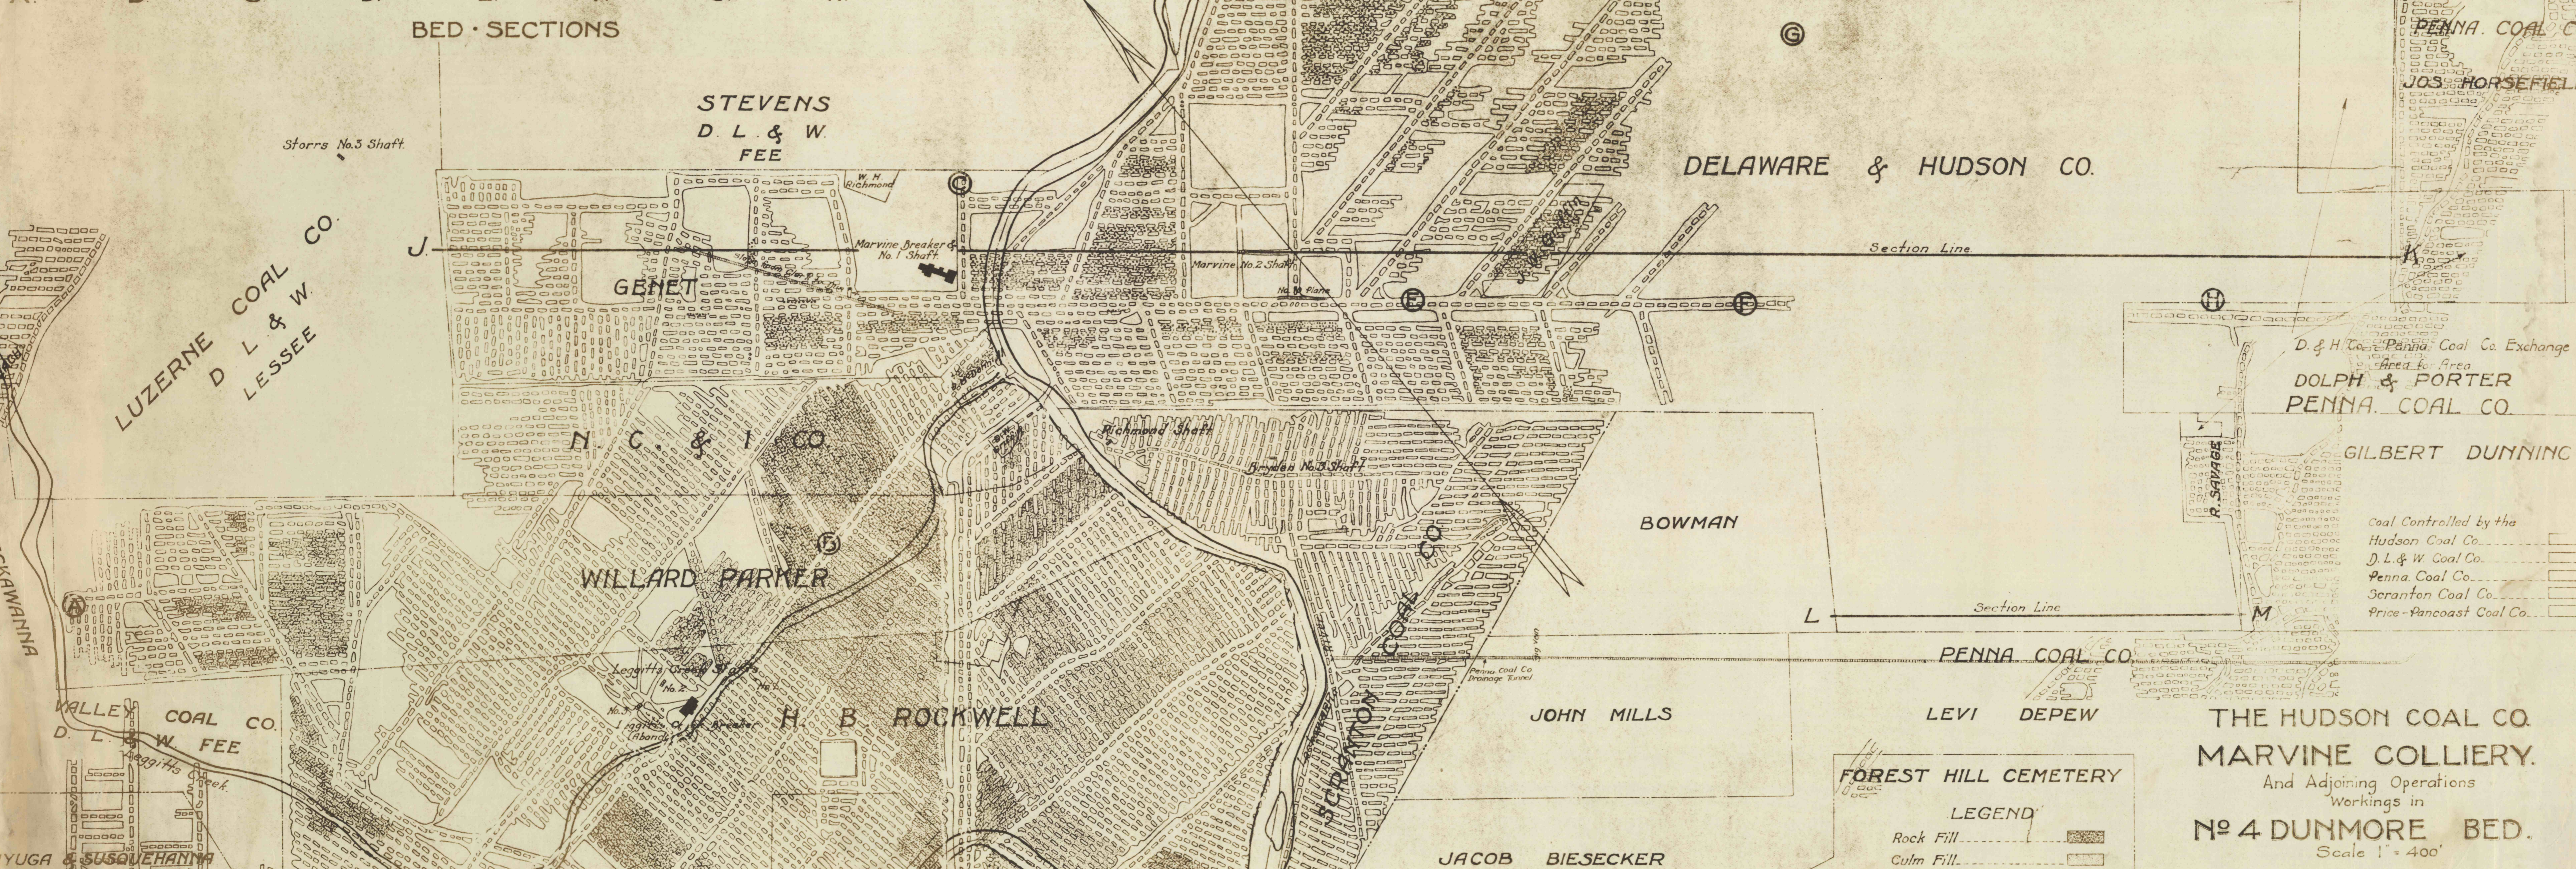

LEGEND

- Rock Fill
- Culm Fill

Coal Controlled by the
Hudson Coal Co.

D. L. & W. Coal Co.

Penna. Coal Co.

Seranton Coal Co.

Price - Pancoast Coal Co.

Scale 1" = 400'

To Accompany Report by
Eli T. Conner, Cons. Engr.
Scranton, Pa.