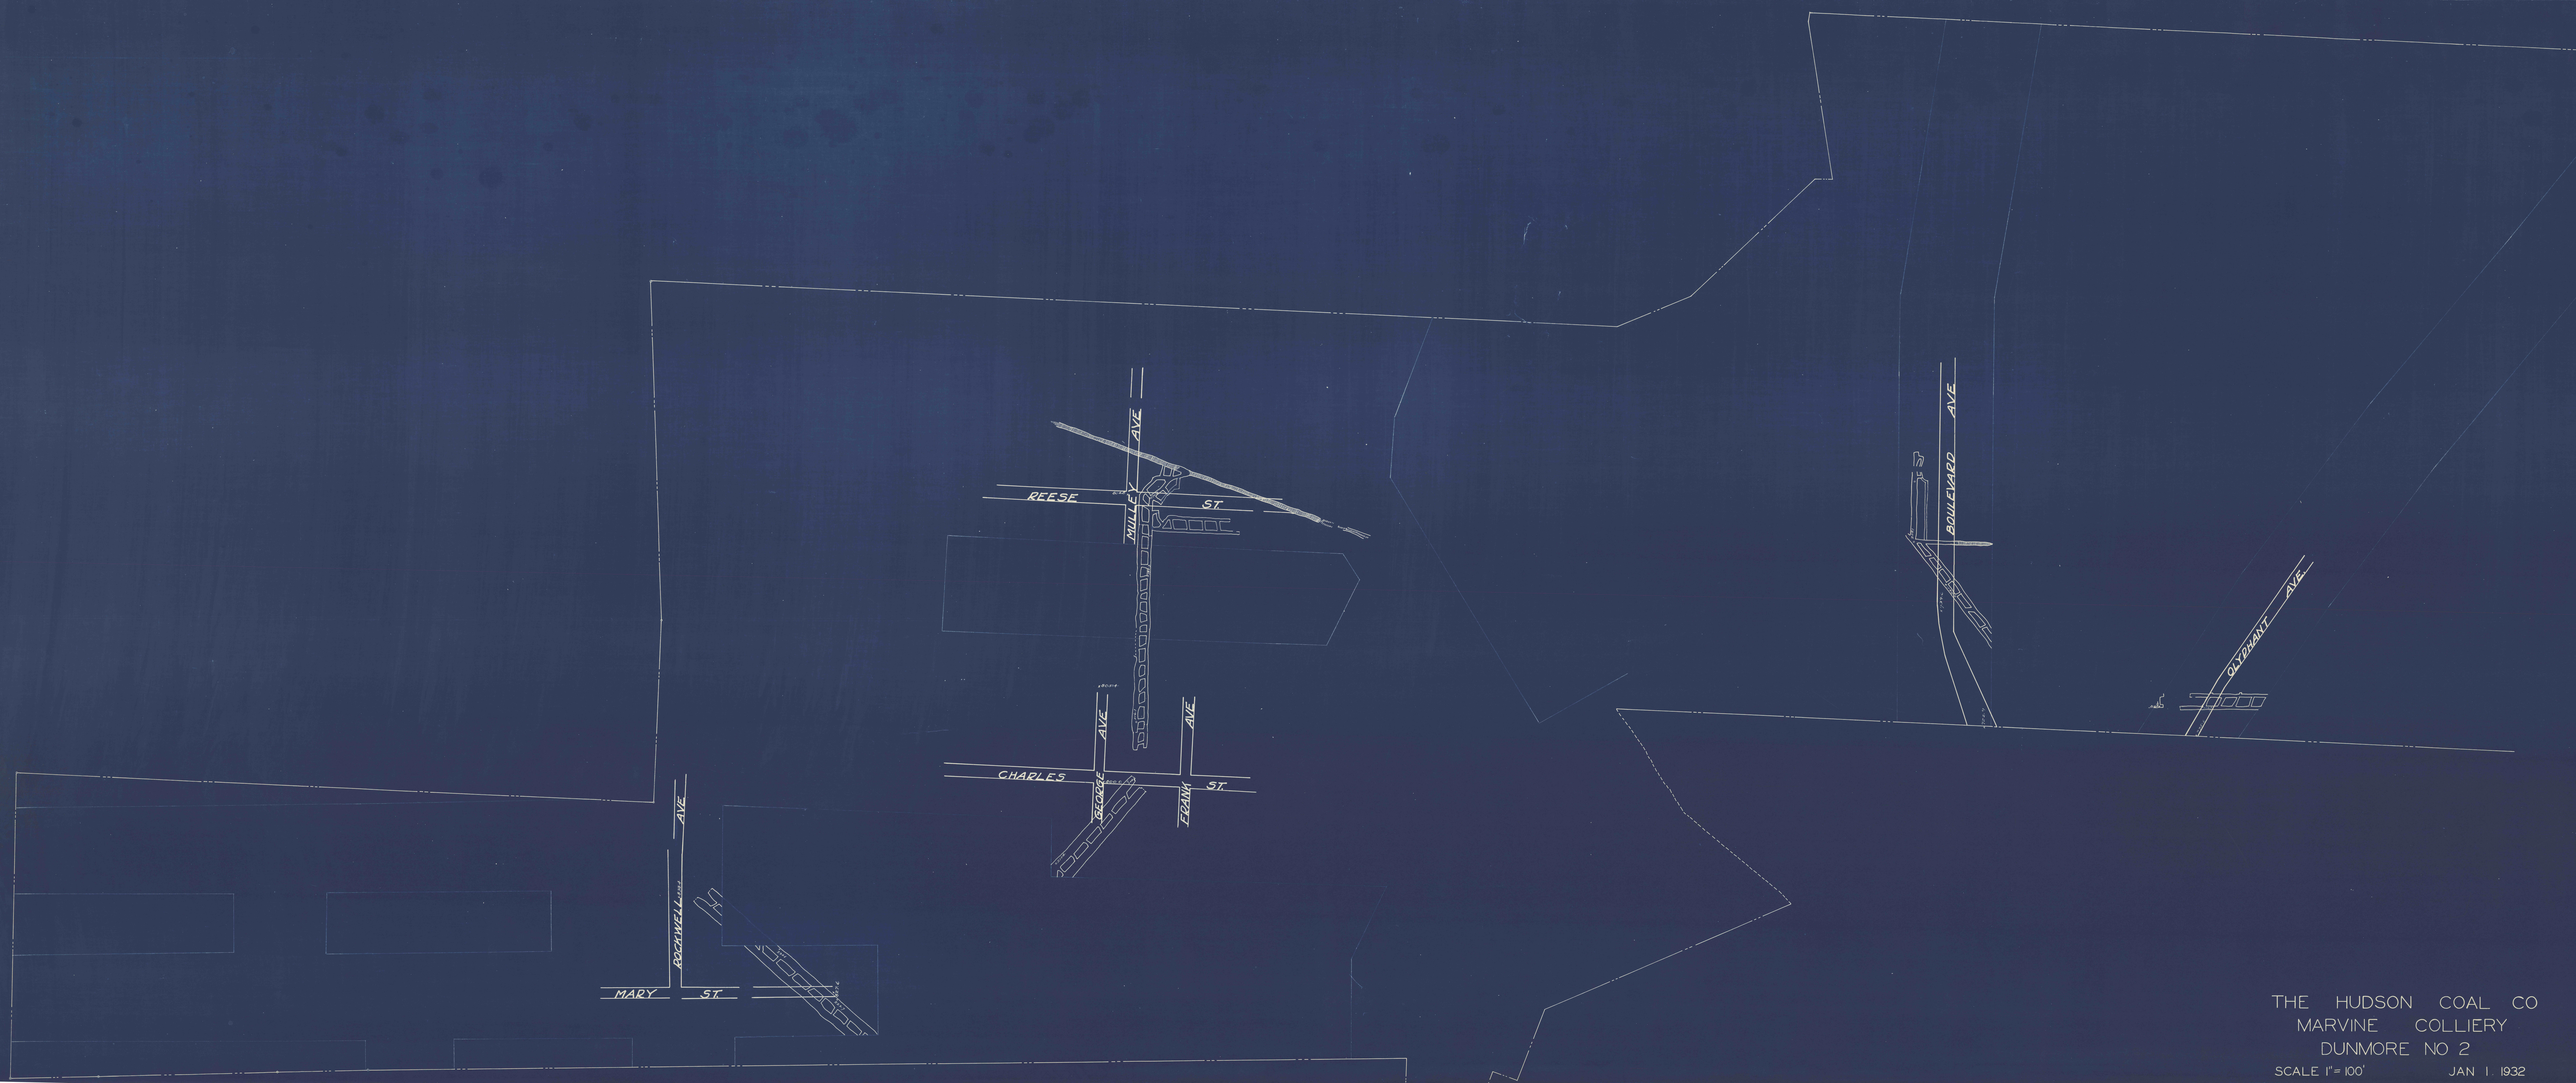
MILLER AVE.
REESE ST.
BOULEVARD AVE.
OLIPHANT AVE.
GEORGE AVE.
FRANK AVE.
CHARLES ST.
ROCKWELL AVE.
MARY ST.
THE HUDSON COAL CO
MARVINE COLLIERY
DUNMORE NO 2
SCALE 1" = 100'
JAN 1 1932