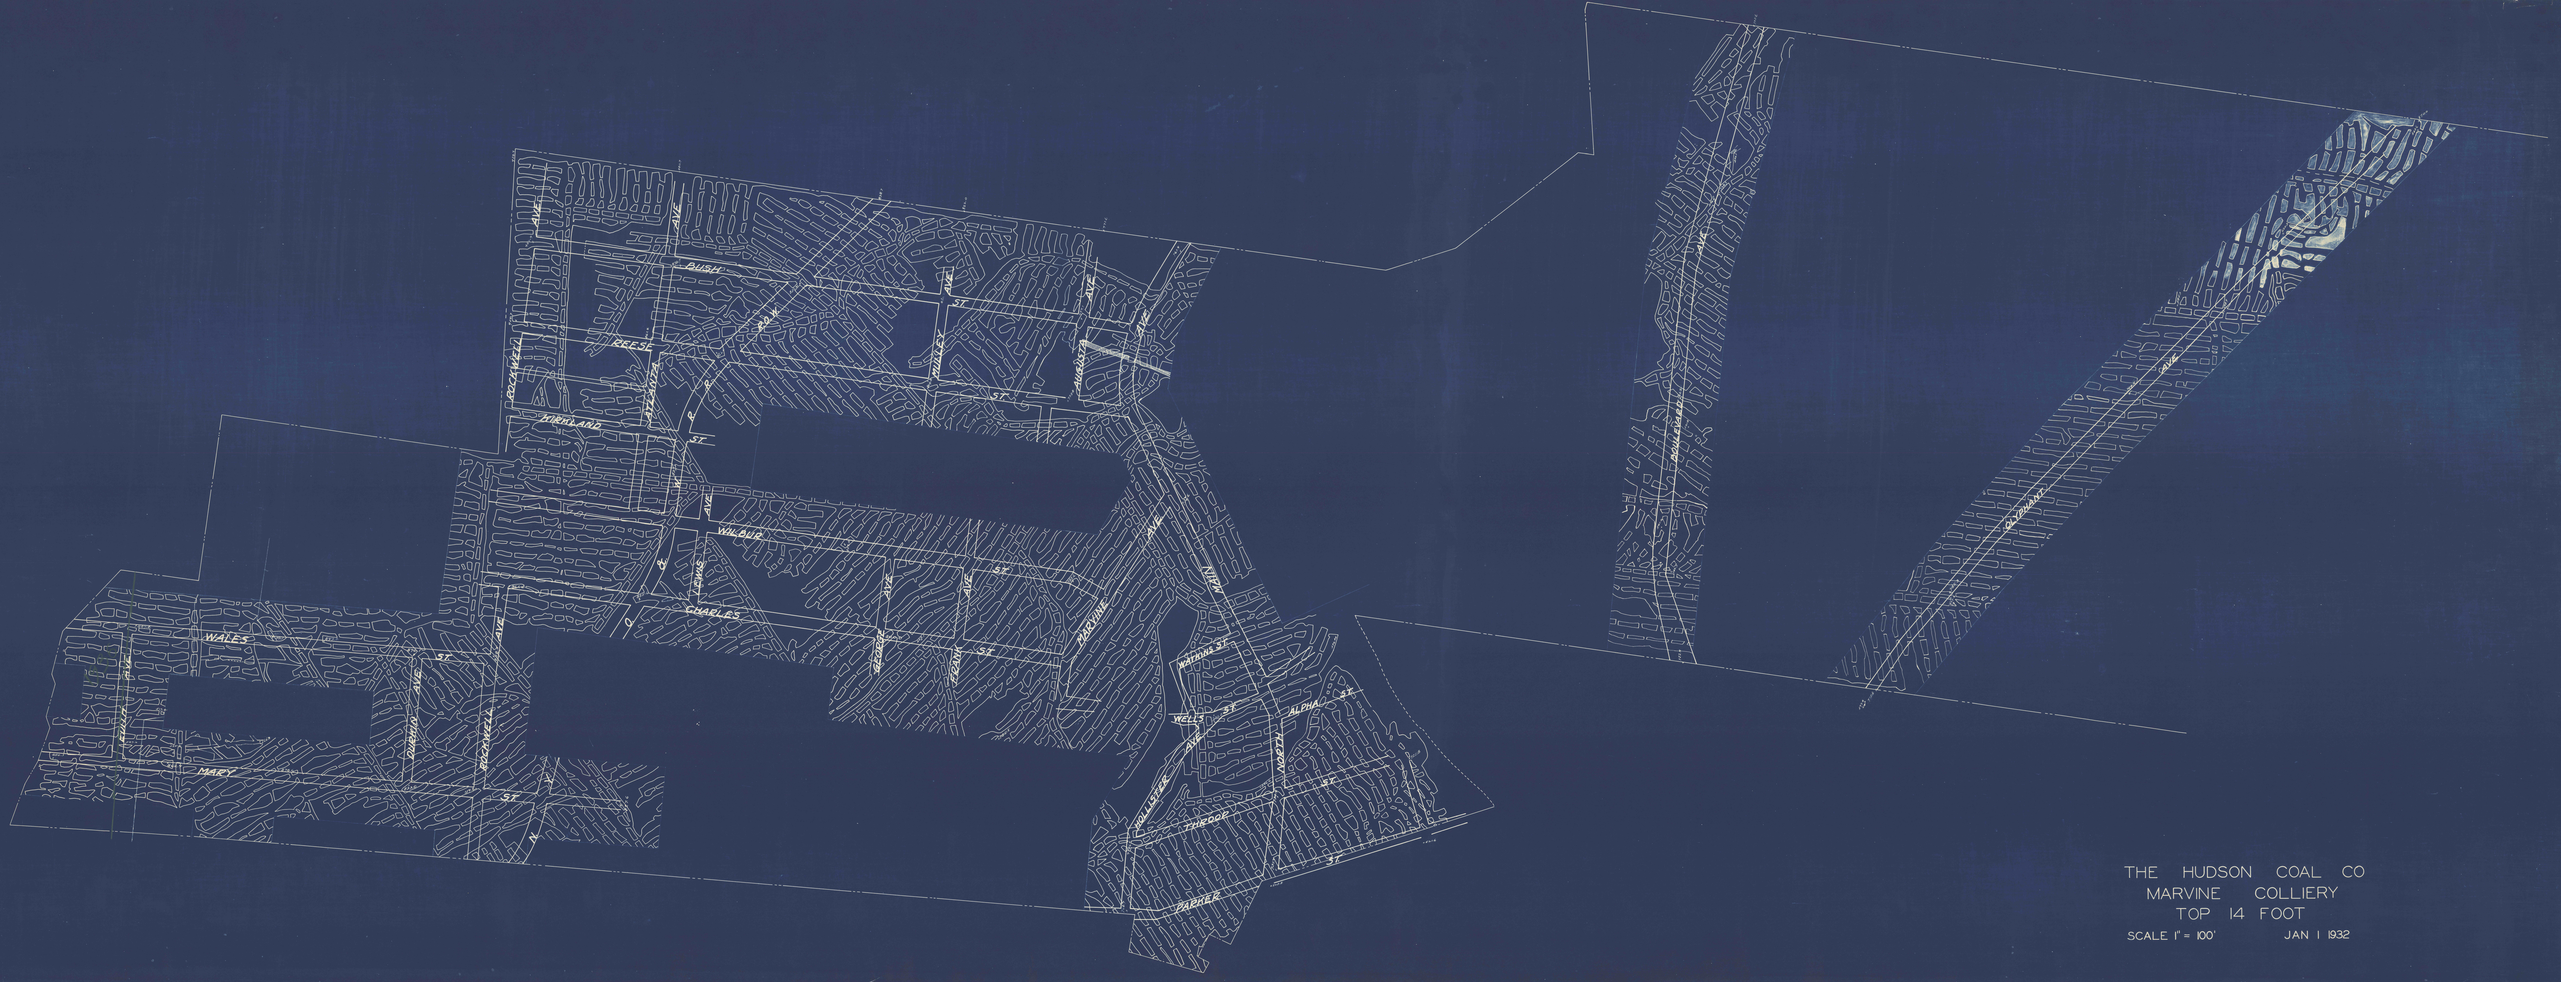

THE HUDSON COAL CO
MARVINE COLLIERY
TOP 14 FOOT
SCALE 1" = 100' JAN 1 1932