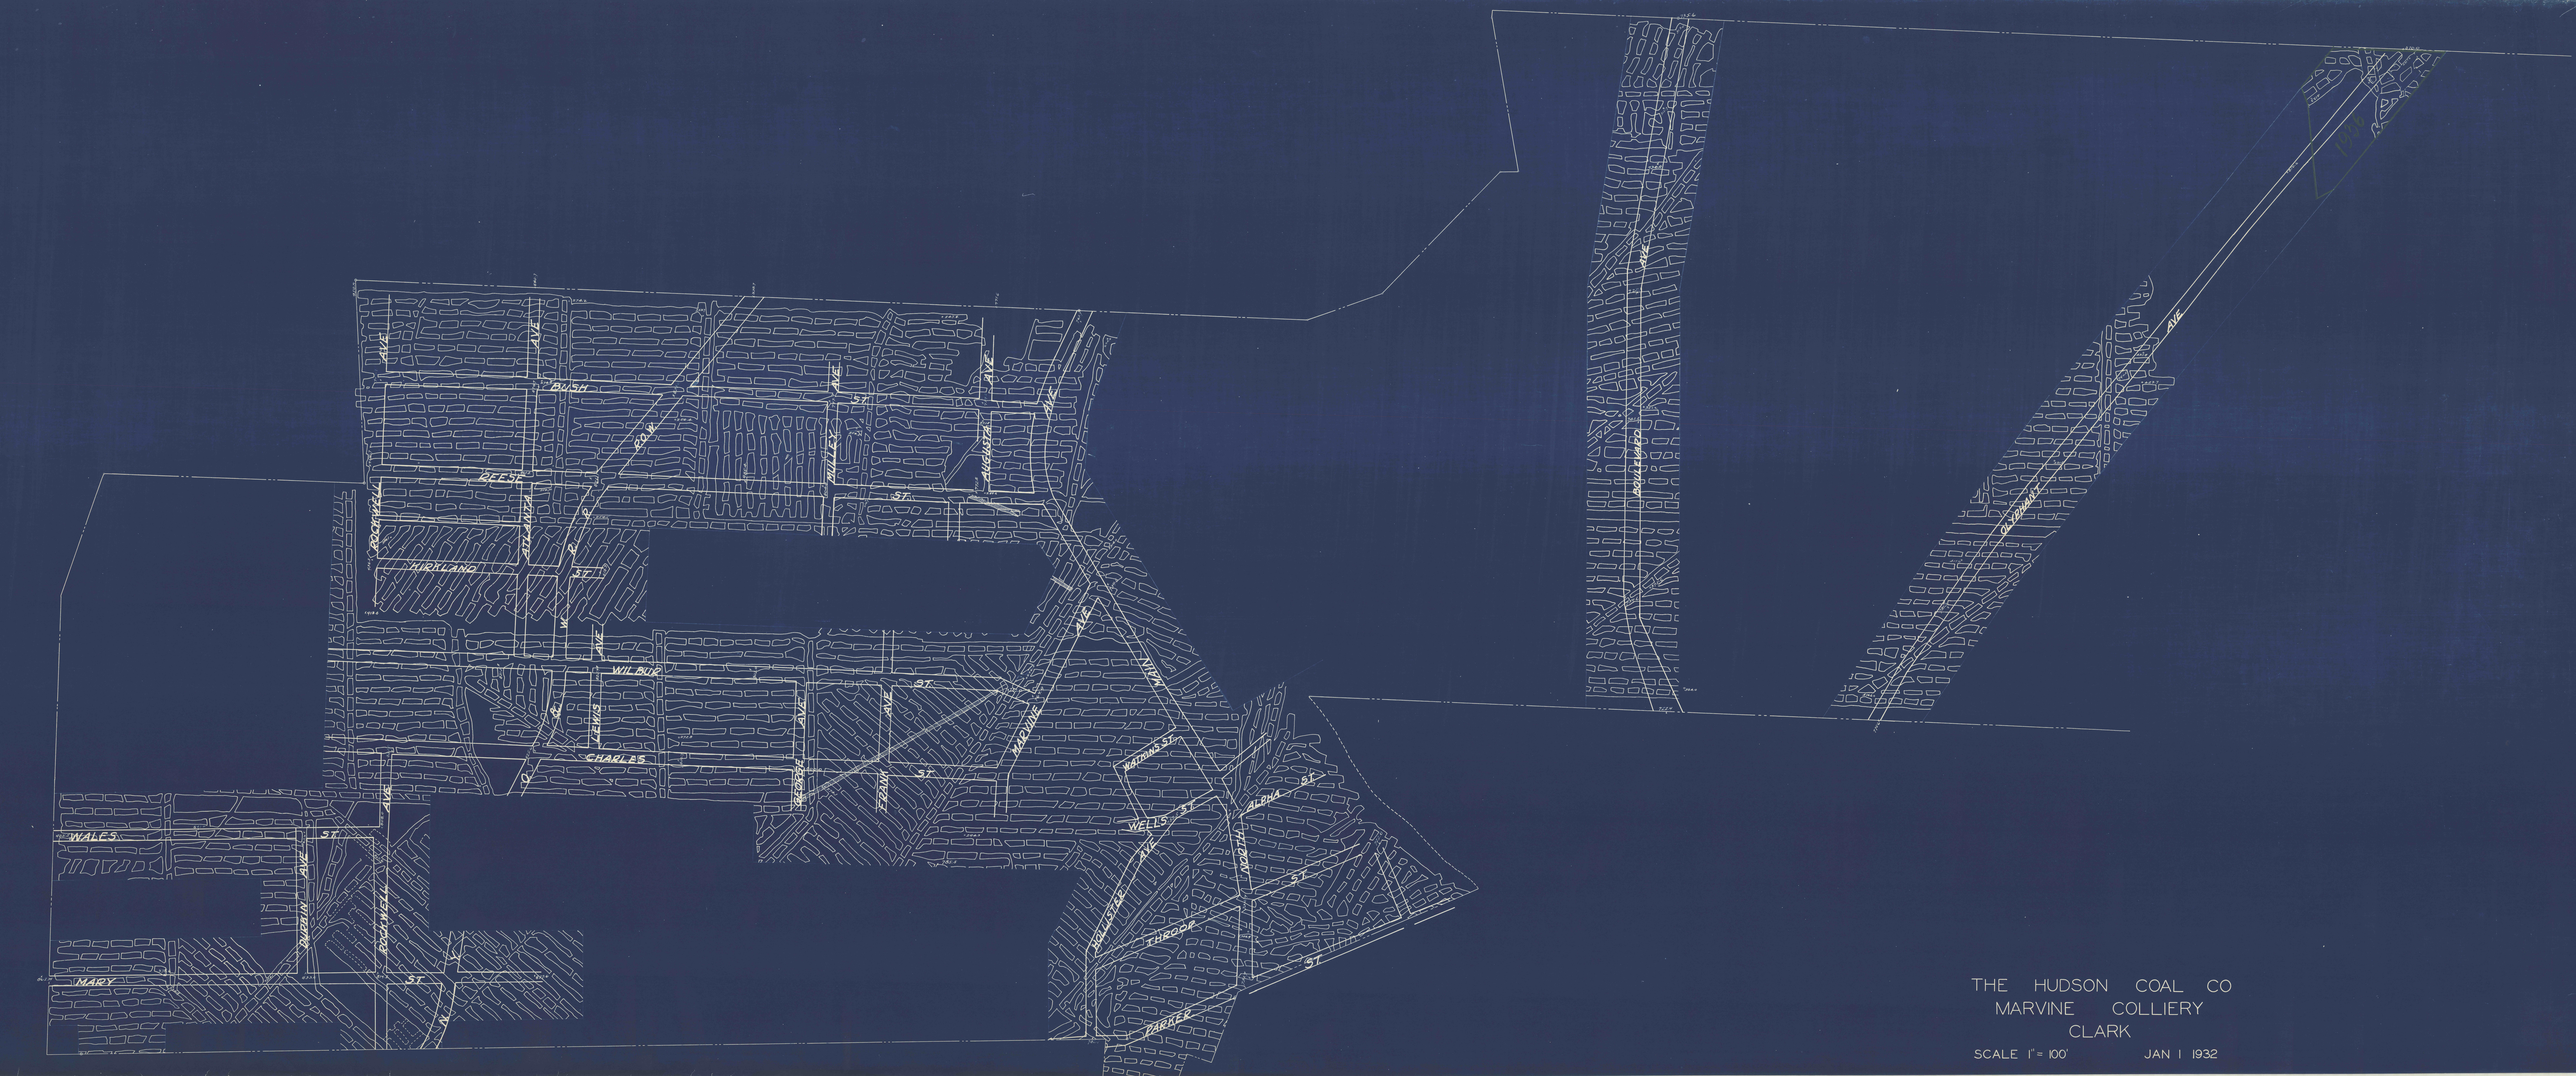

THE HUDSON COAL CO
MARVINE COLLIERY
CLARK

SCALE 1" = 100' JAN 1 1932