

18
Last Robbing Posted


FISK - S1

Barrier Dated Oct 4th 1921
Pillar

B.H. No 6	{	8 Coal 0.2"	
		Coal 2.7"	
		Slate 0.5"	
B.H. No 7	{	Slate 0.4"	
		Coal 0.9"	
		Slate 0.3"	
B.H. No 8	{	Slate 0.2"	
		Coal 0.24"	
		Slate 0.3"	
B.H. No 9	{	Coal 2.9"	
		Slate 0.5"	
B.H. No 10	{	Coal 0.9"	
		Coal 2.10"	
		Slate 0.3"	
B.H. No 27	{	Slate 0.3"	
		Coal 2.6"	
B.H. No 28	{	Coal 2.5"	
		Slate 3.5"	

2/32

File in S-2.

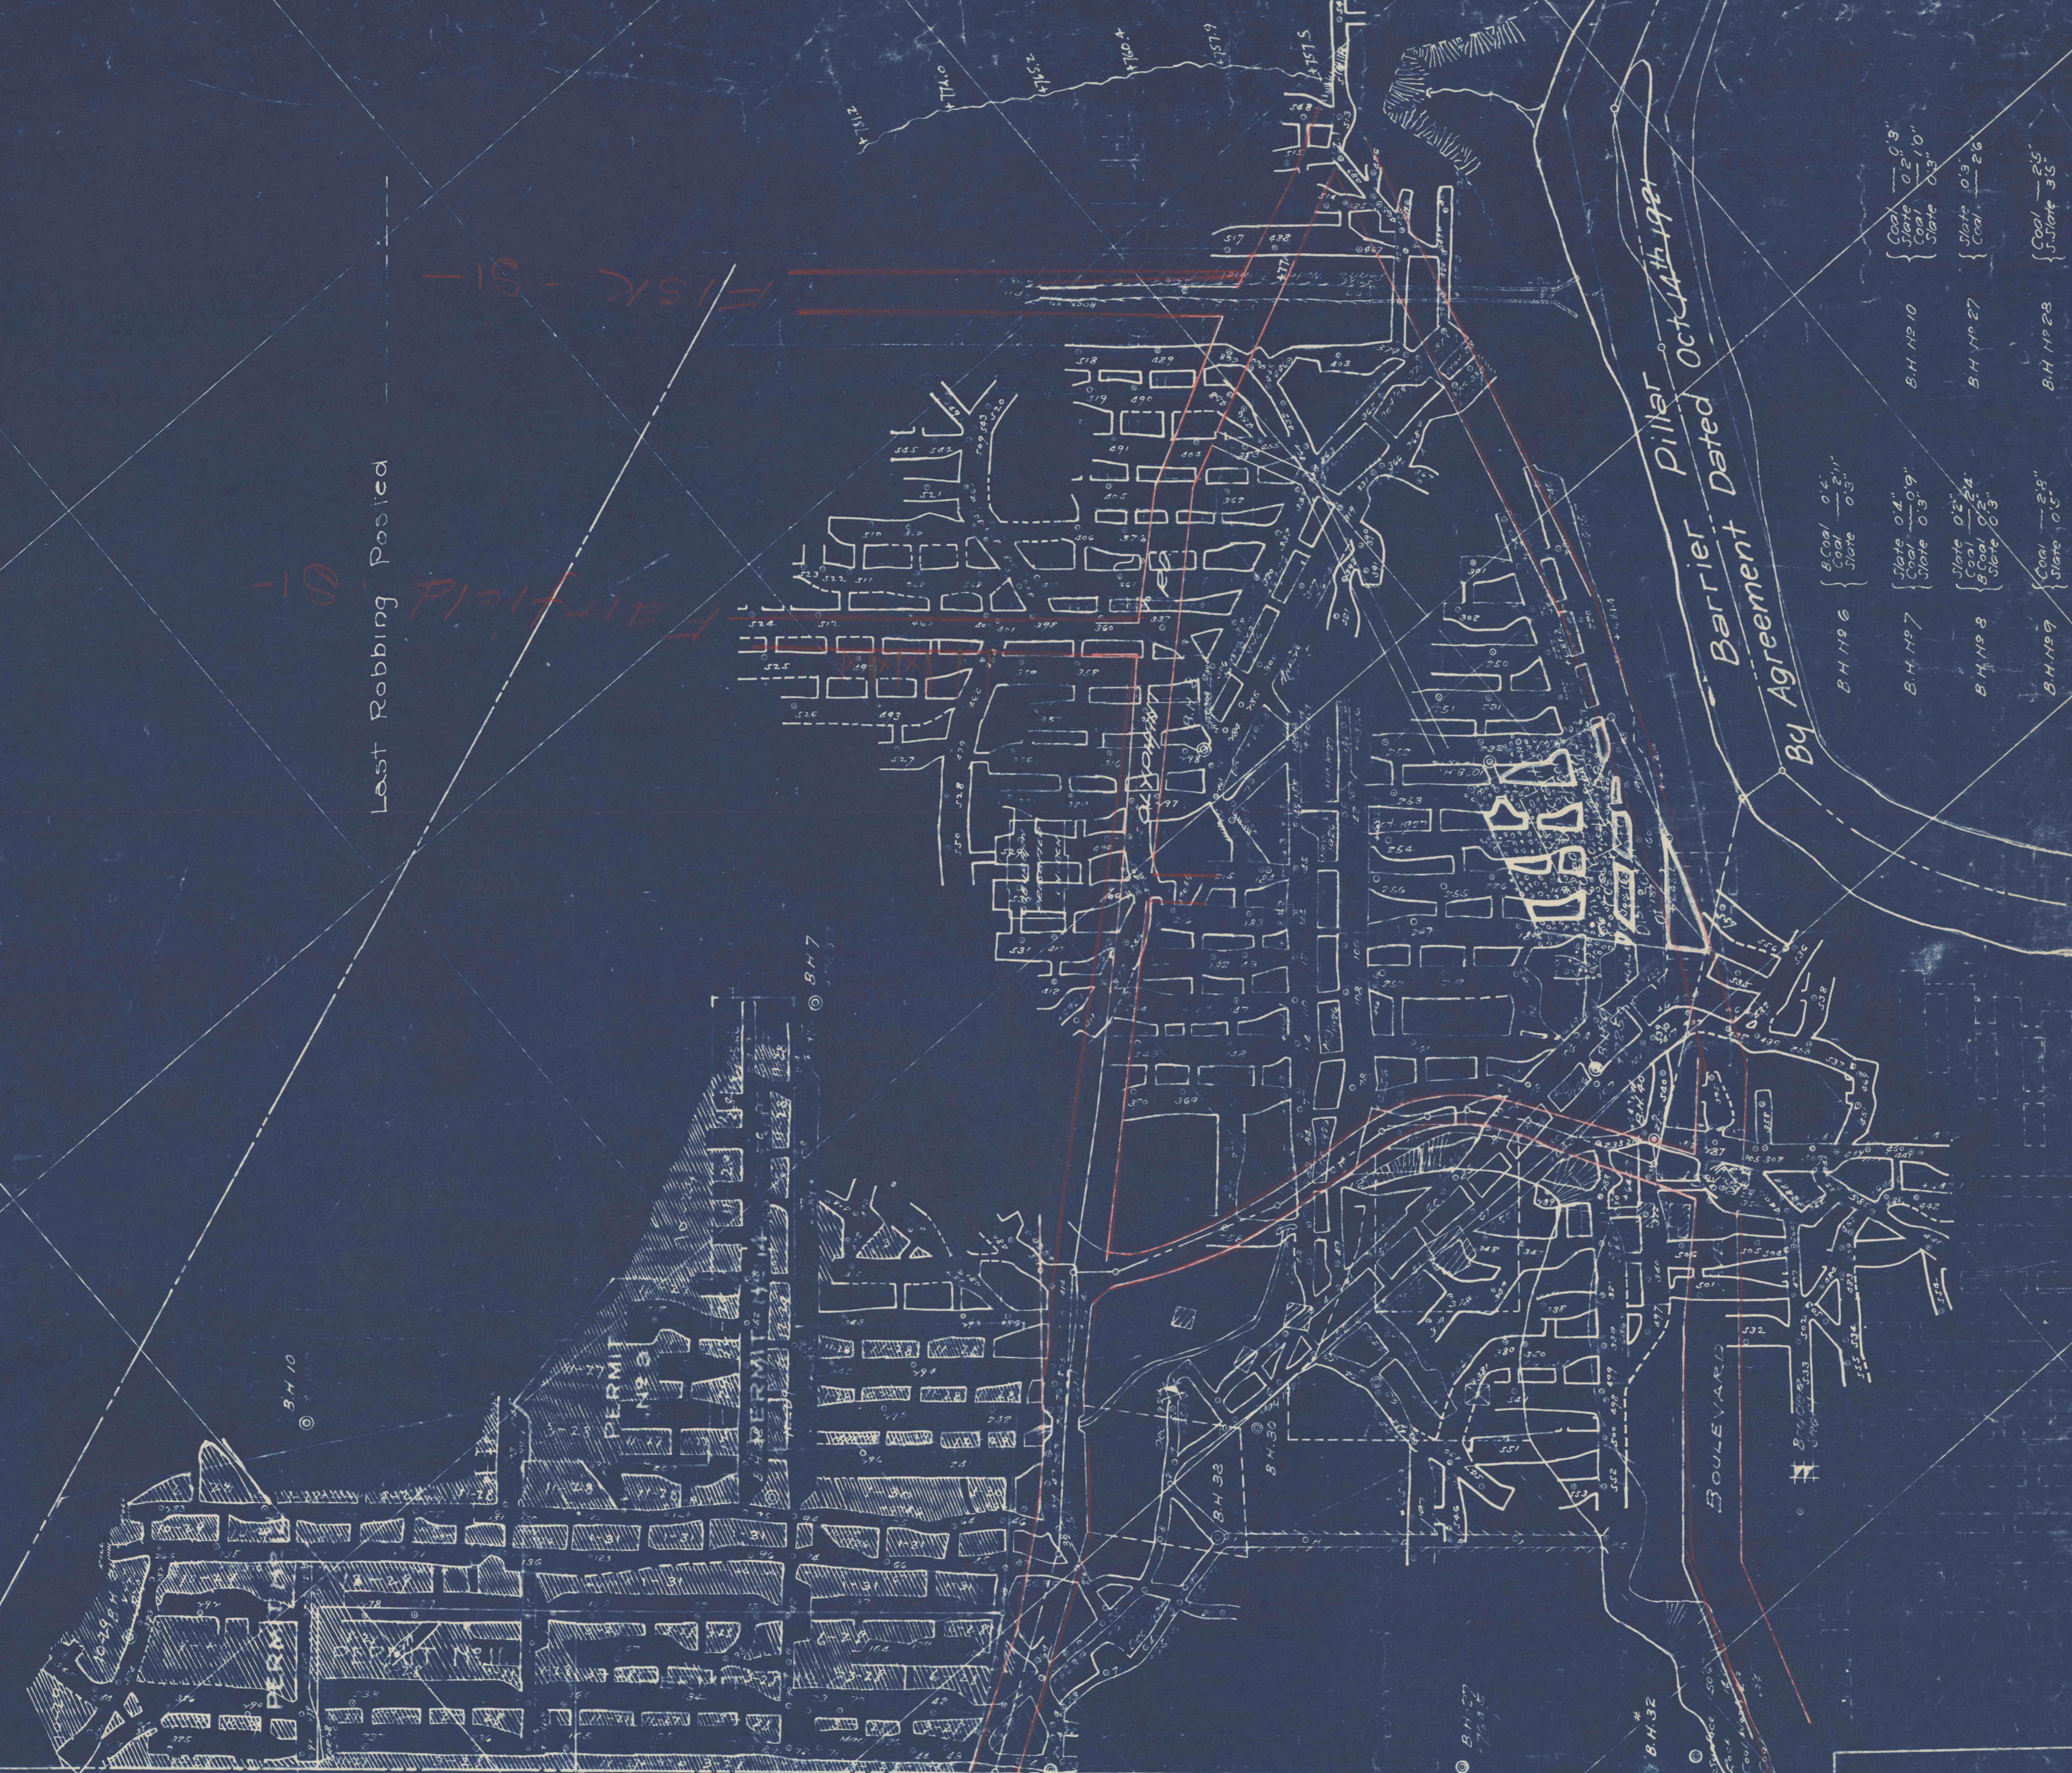

RICHMOND NO 3
 ROCK VEIN
 SCRANTON COAL COMPANY
 Scale - 1 in. = 100 ft.