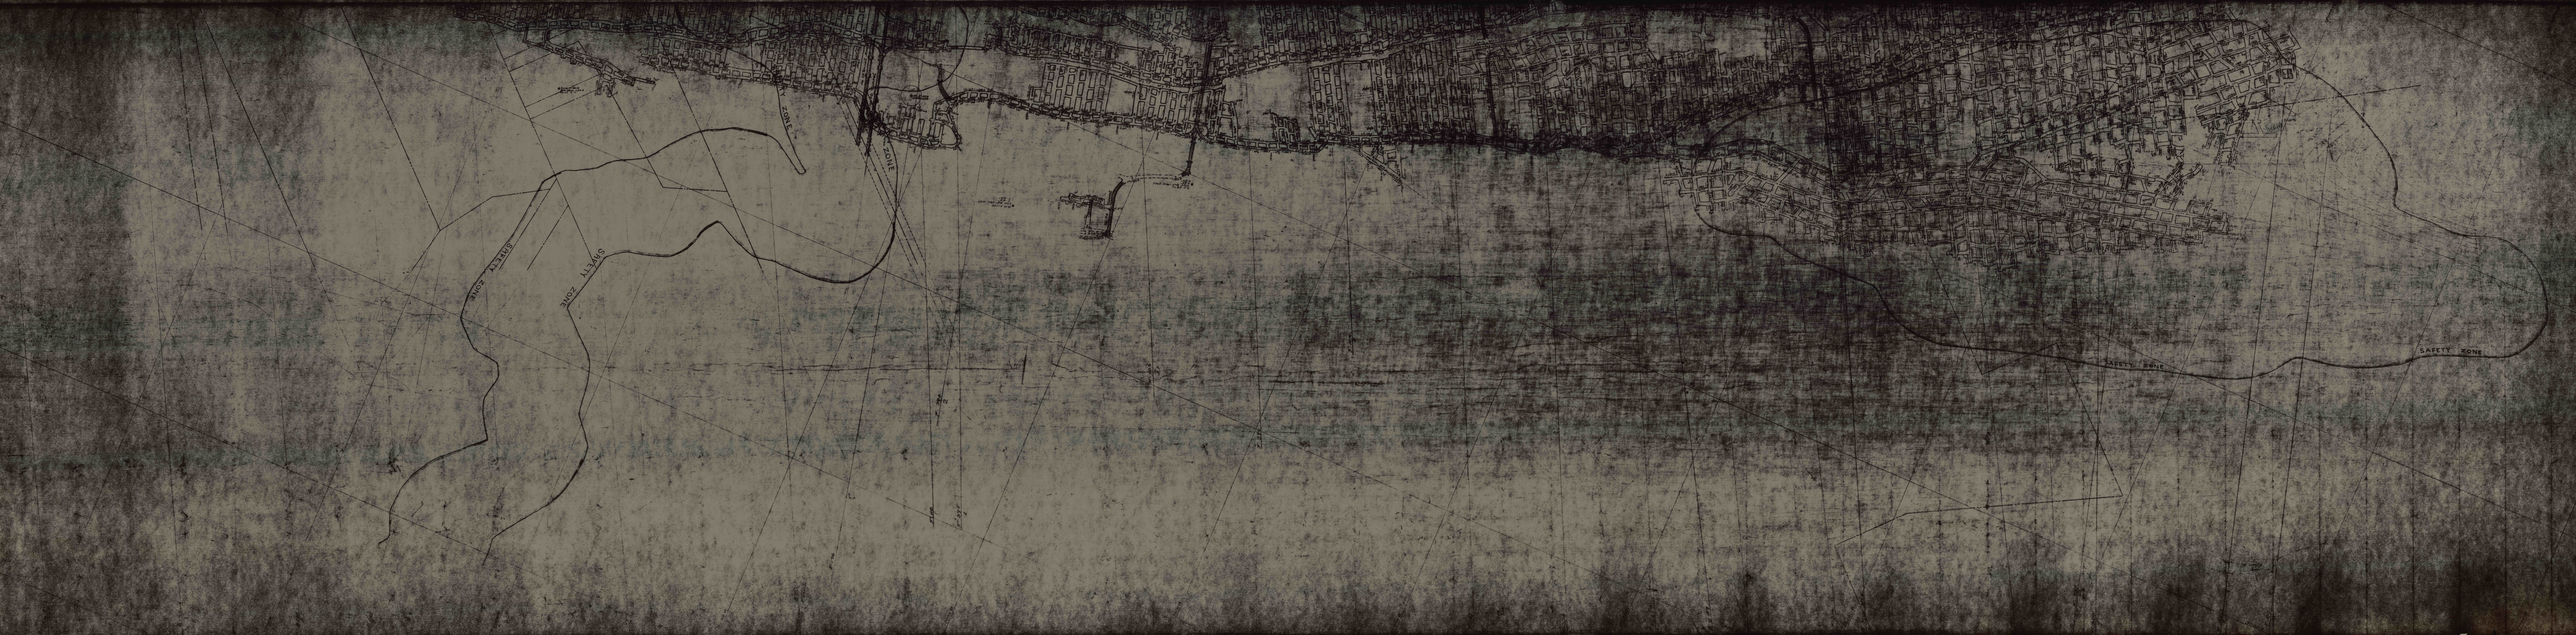
SAFETY ZONE
SAFETY ZONE
SAFETY ZONE
SAFETY ZONE