


BARRE CITY WARRANT

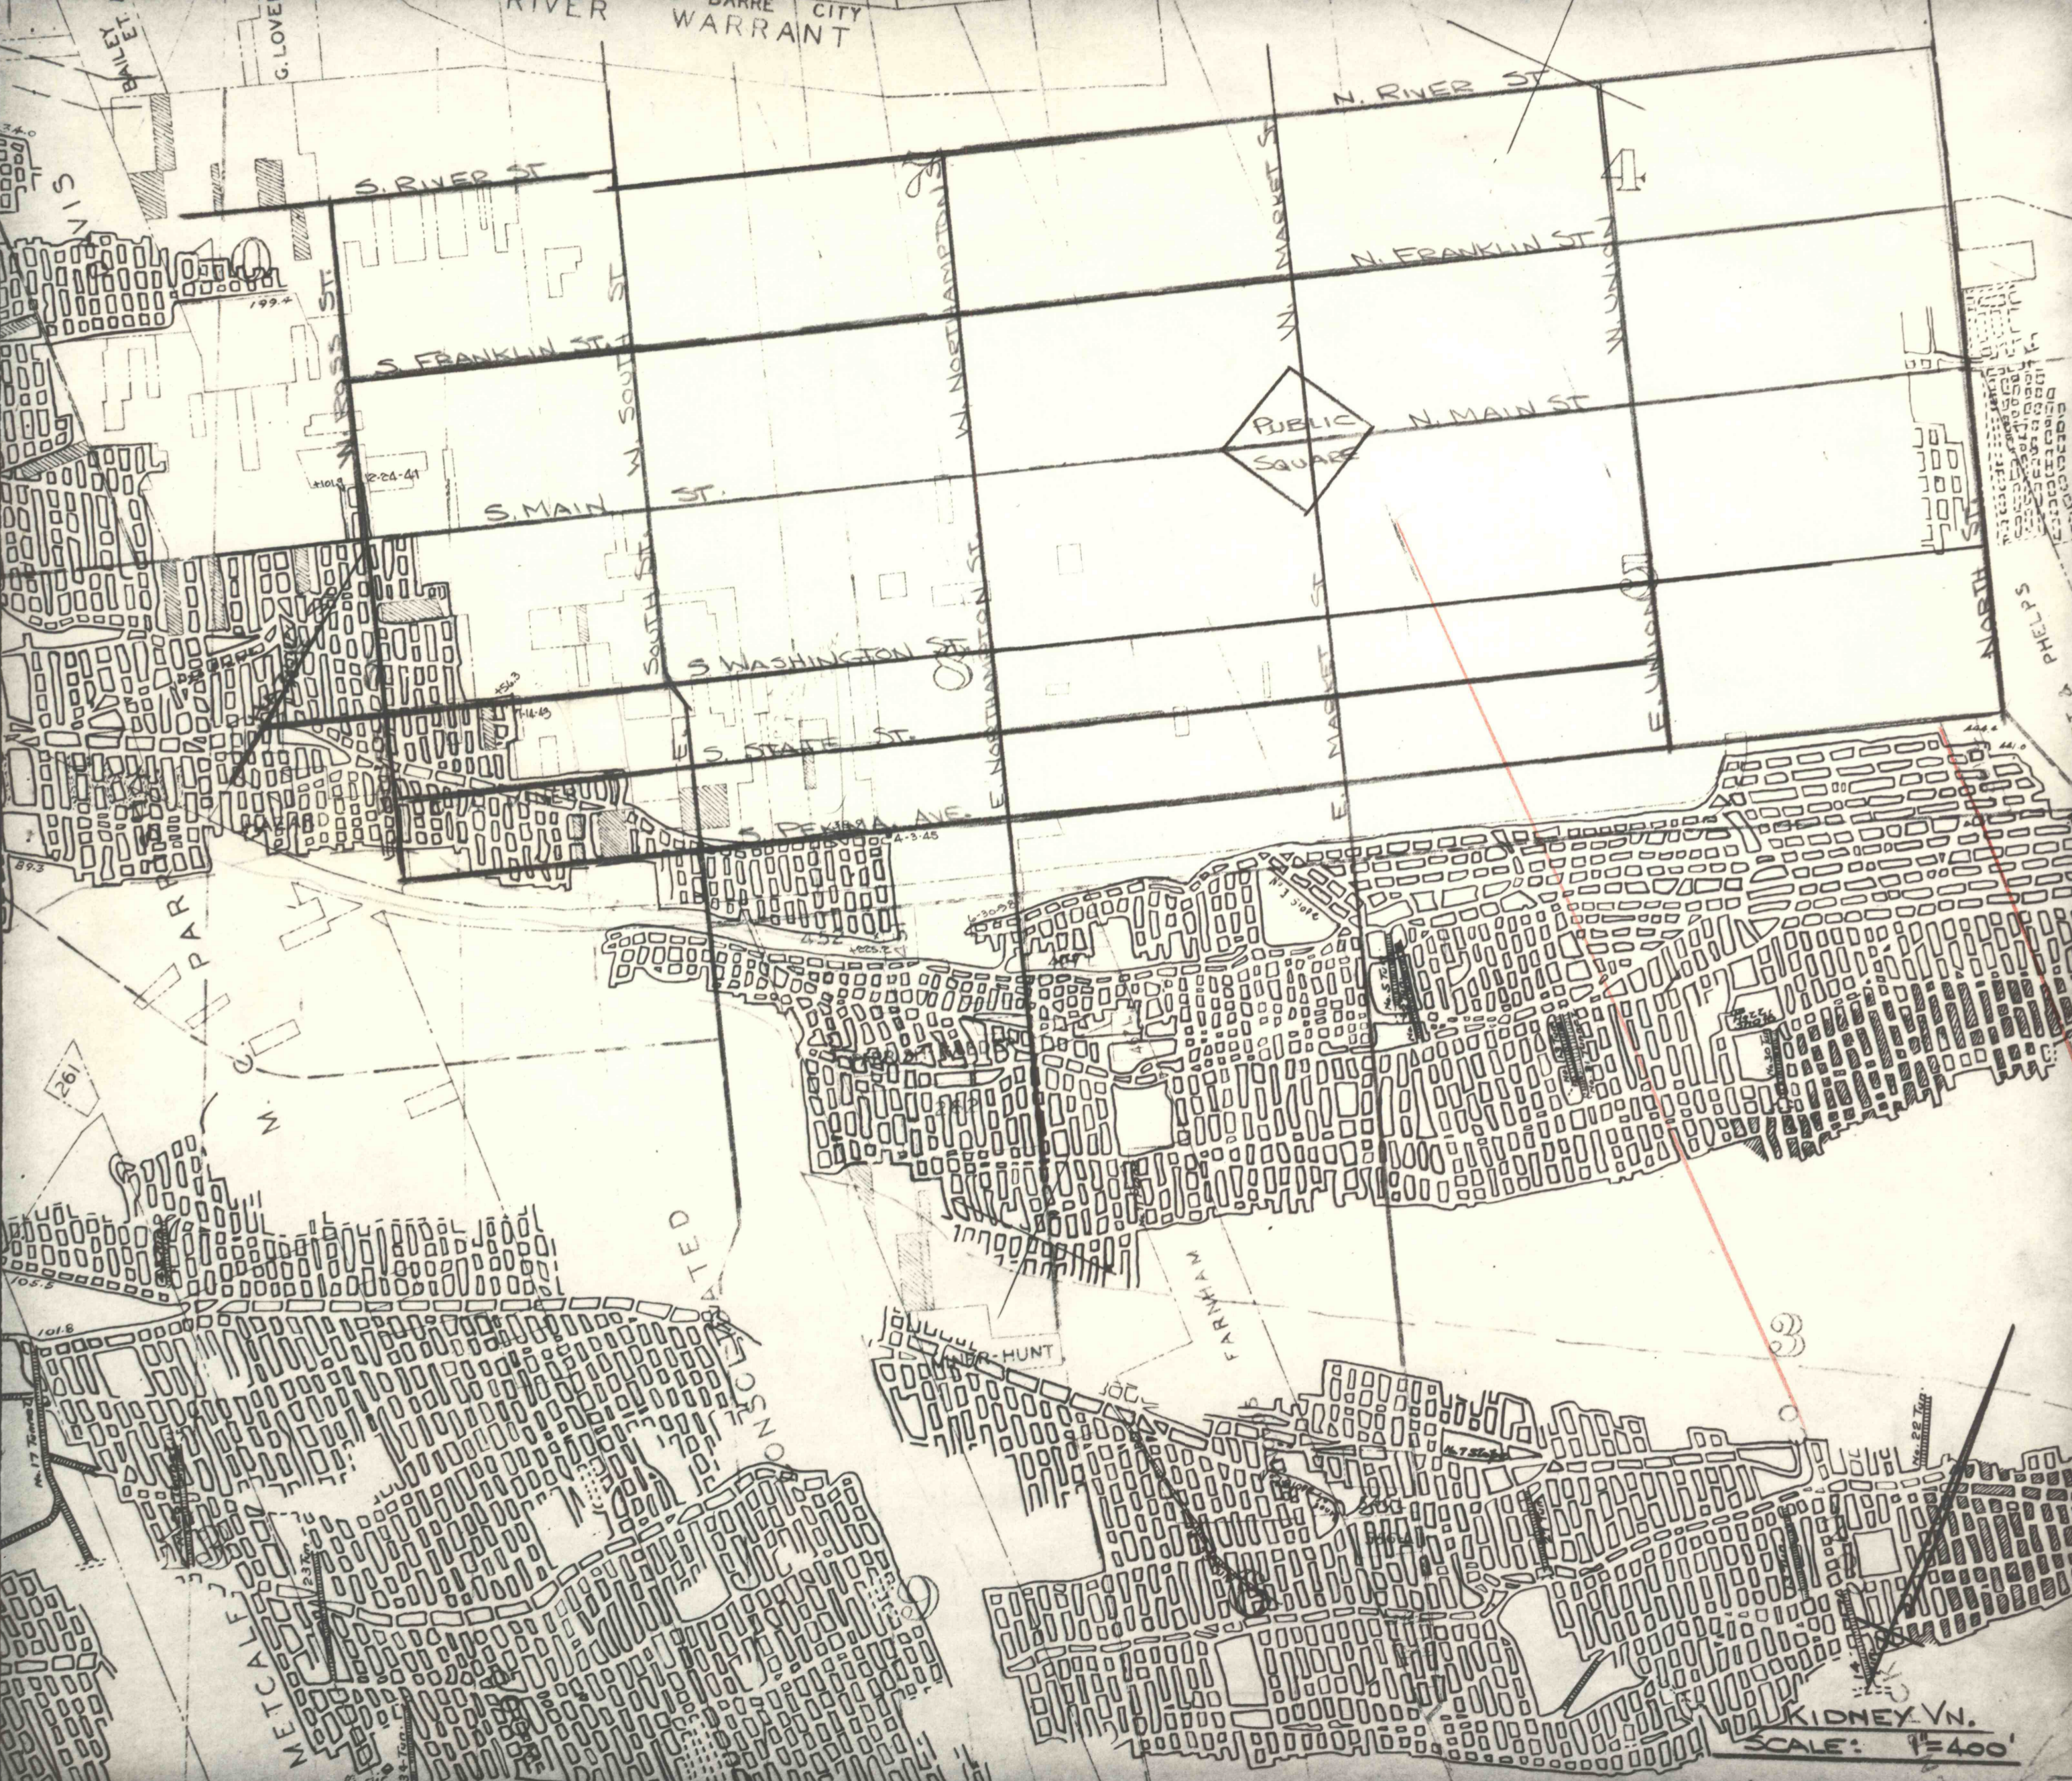

PUBLIC SQUARE

KIDNEY VN.
SCALE: 1"=400'