


14-11-1900
SHAFT
E.T. 1922

HUDSON COAL CO
PINE RIDGE COLLIERY

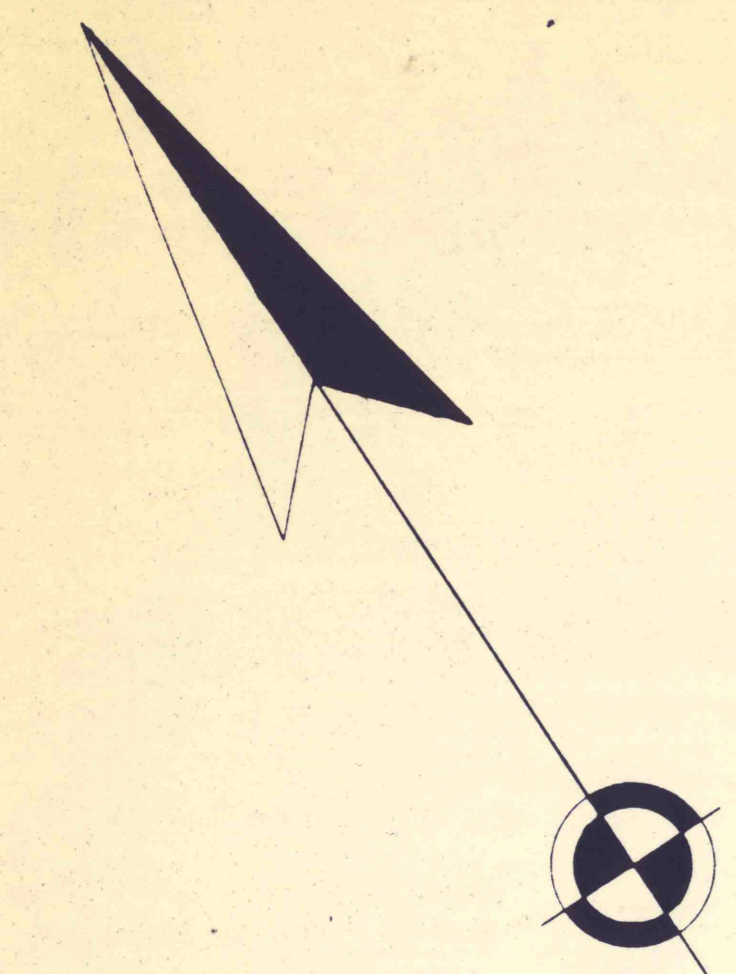

LEHIGH VALLEY COAL CO
MIDVALE SLOPE



LEHIGH VALLEY COAL CO
MINERAL SPRINGS COLLIERY

WATER
BH 5770

BH 6171
SURF ELEV. 231.0
KIDNEY VENT. NO. 2

BH 6122
SURF ELEV. 230.0
KIDNEY VENT. NO. 1

BH 5777

BH 4887

BH 5744

BH 4866

BH 5812

BH 5762

BH 5726

BH 5615

BH 5748

BH 4885

BH 6069

BH 6064

BH 6083

BH 4860

HUDSON COAL CO
CONYNGHAM COLLIERY

HUDSON COAL CO
BALTIMORE COLLIERY

PETTEBONE "3+4."

KIDNEY VN.

SCALE - 1" = 100'

BALTIMORE NO. 5
SHAFT
SURF ELEV. 128.7