
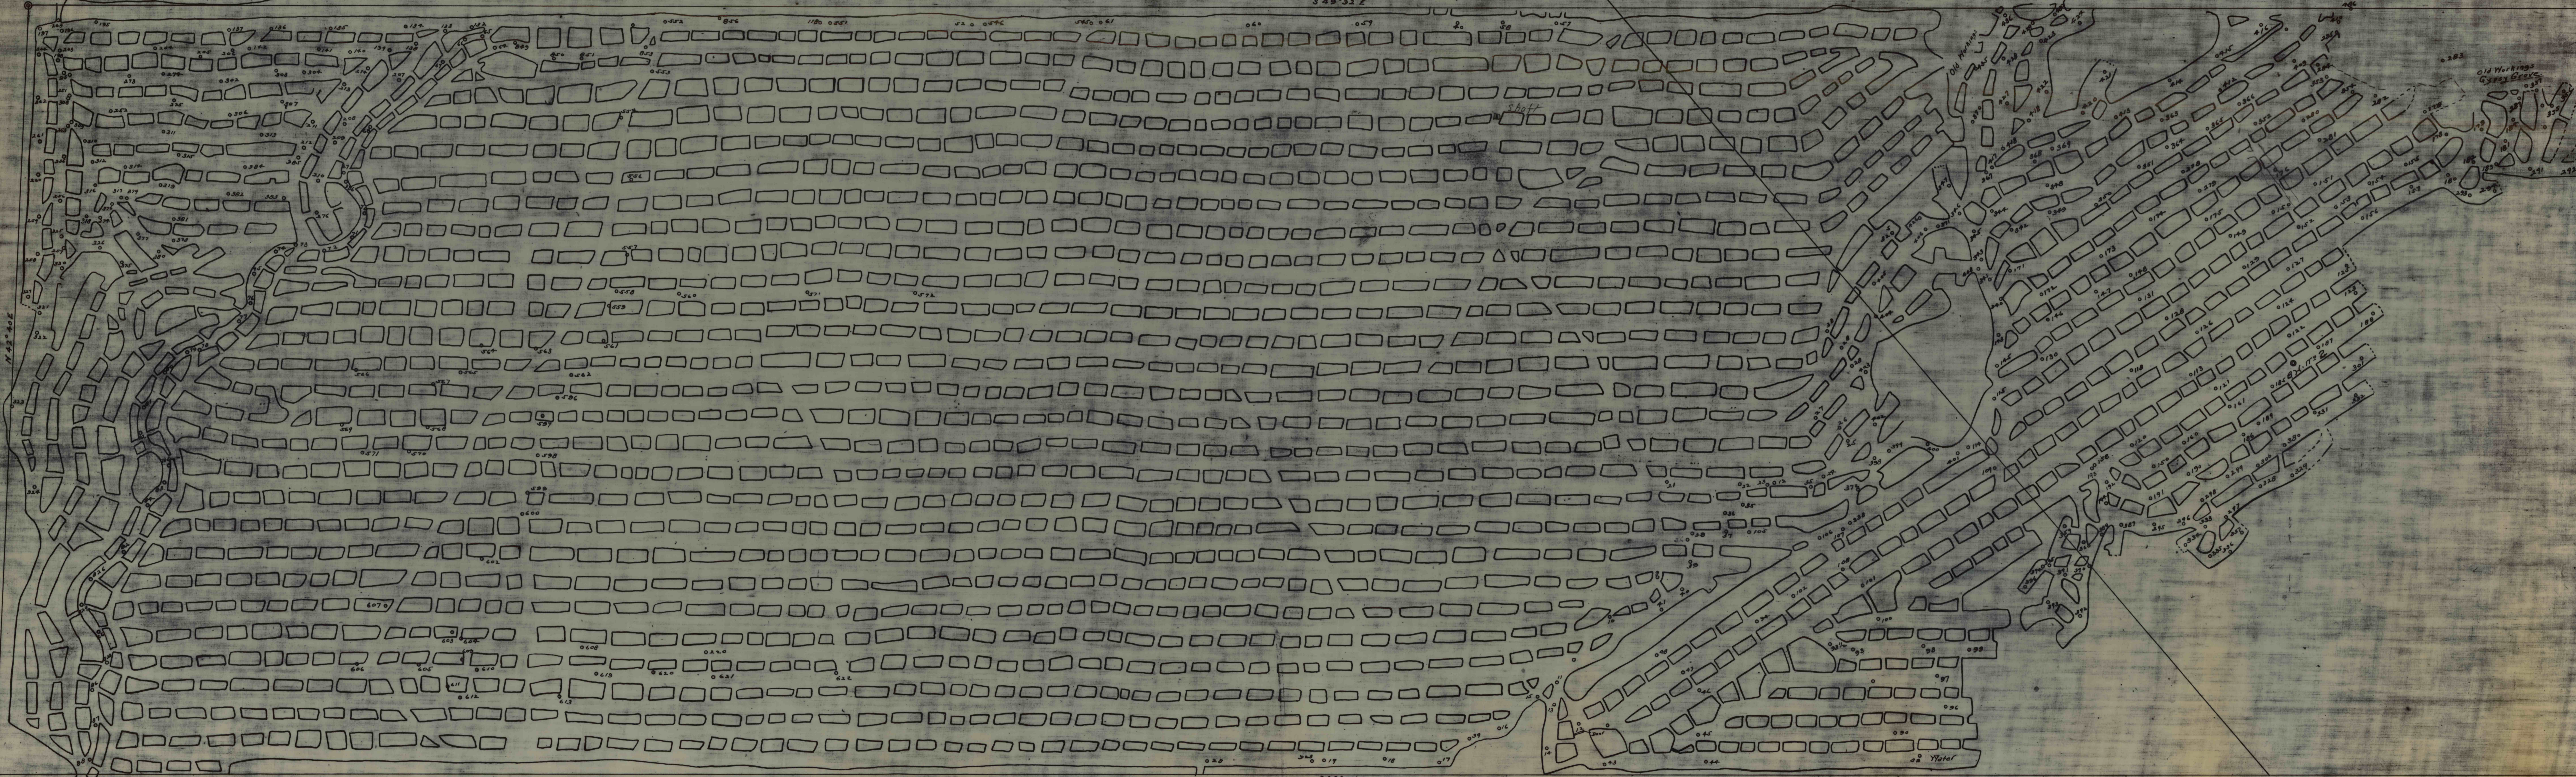


Penna Coal Co
S 49° 32' E

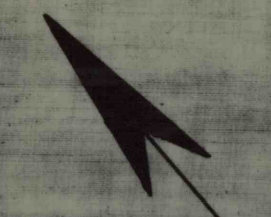

Penna. Coal Co

Spencer Estate
S 49° 32' E

Old Workings
G. B. B. Co.