


SIBILEY - BED 22H 12V

U  
S  
T  
I  
N


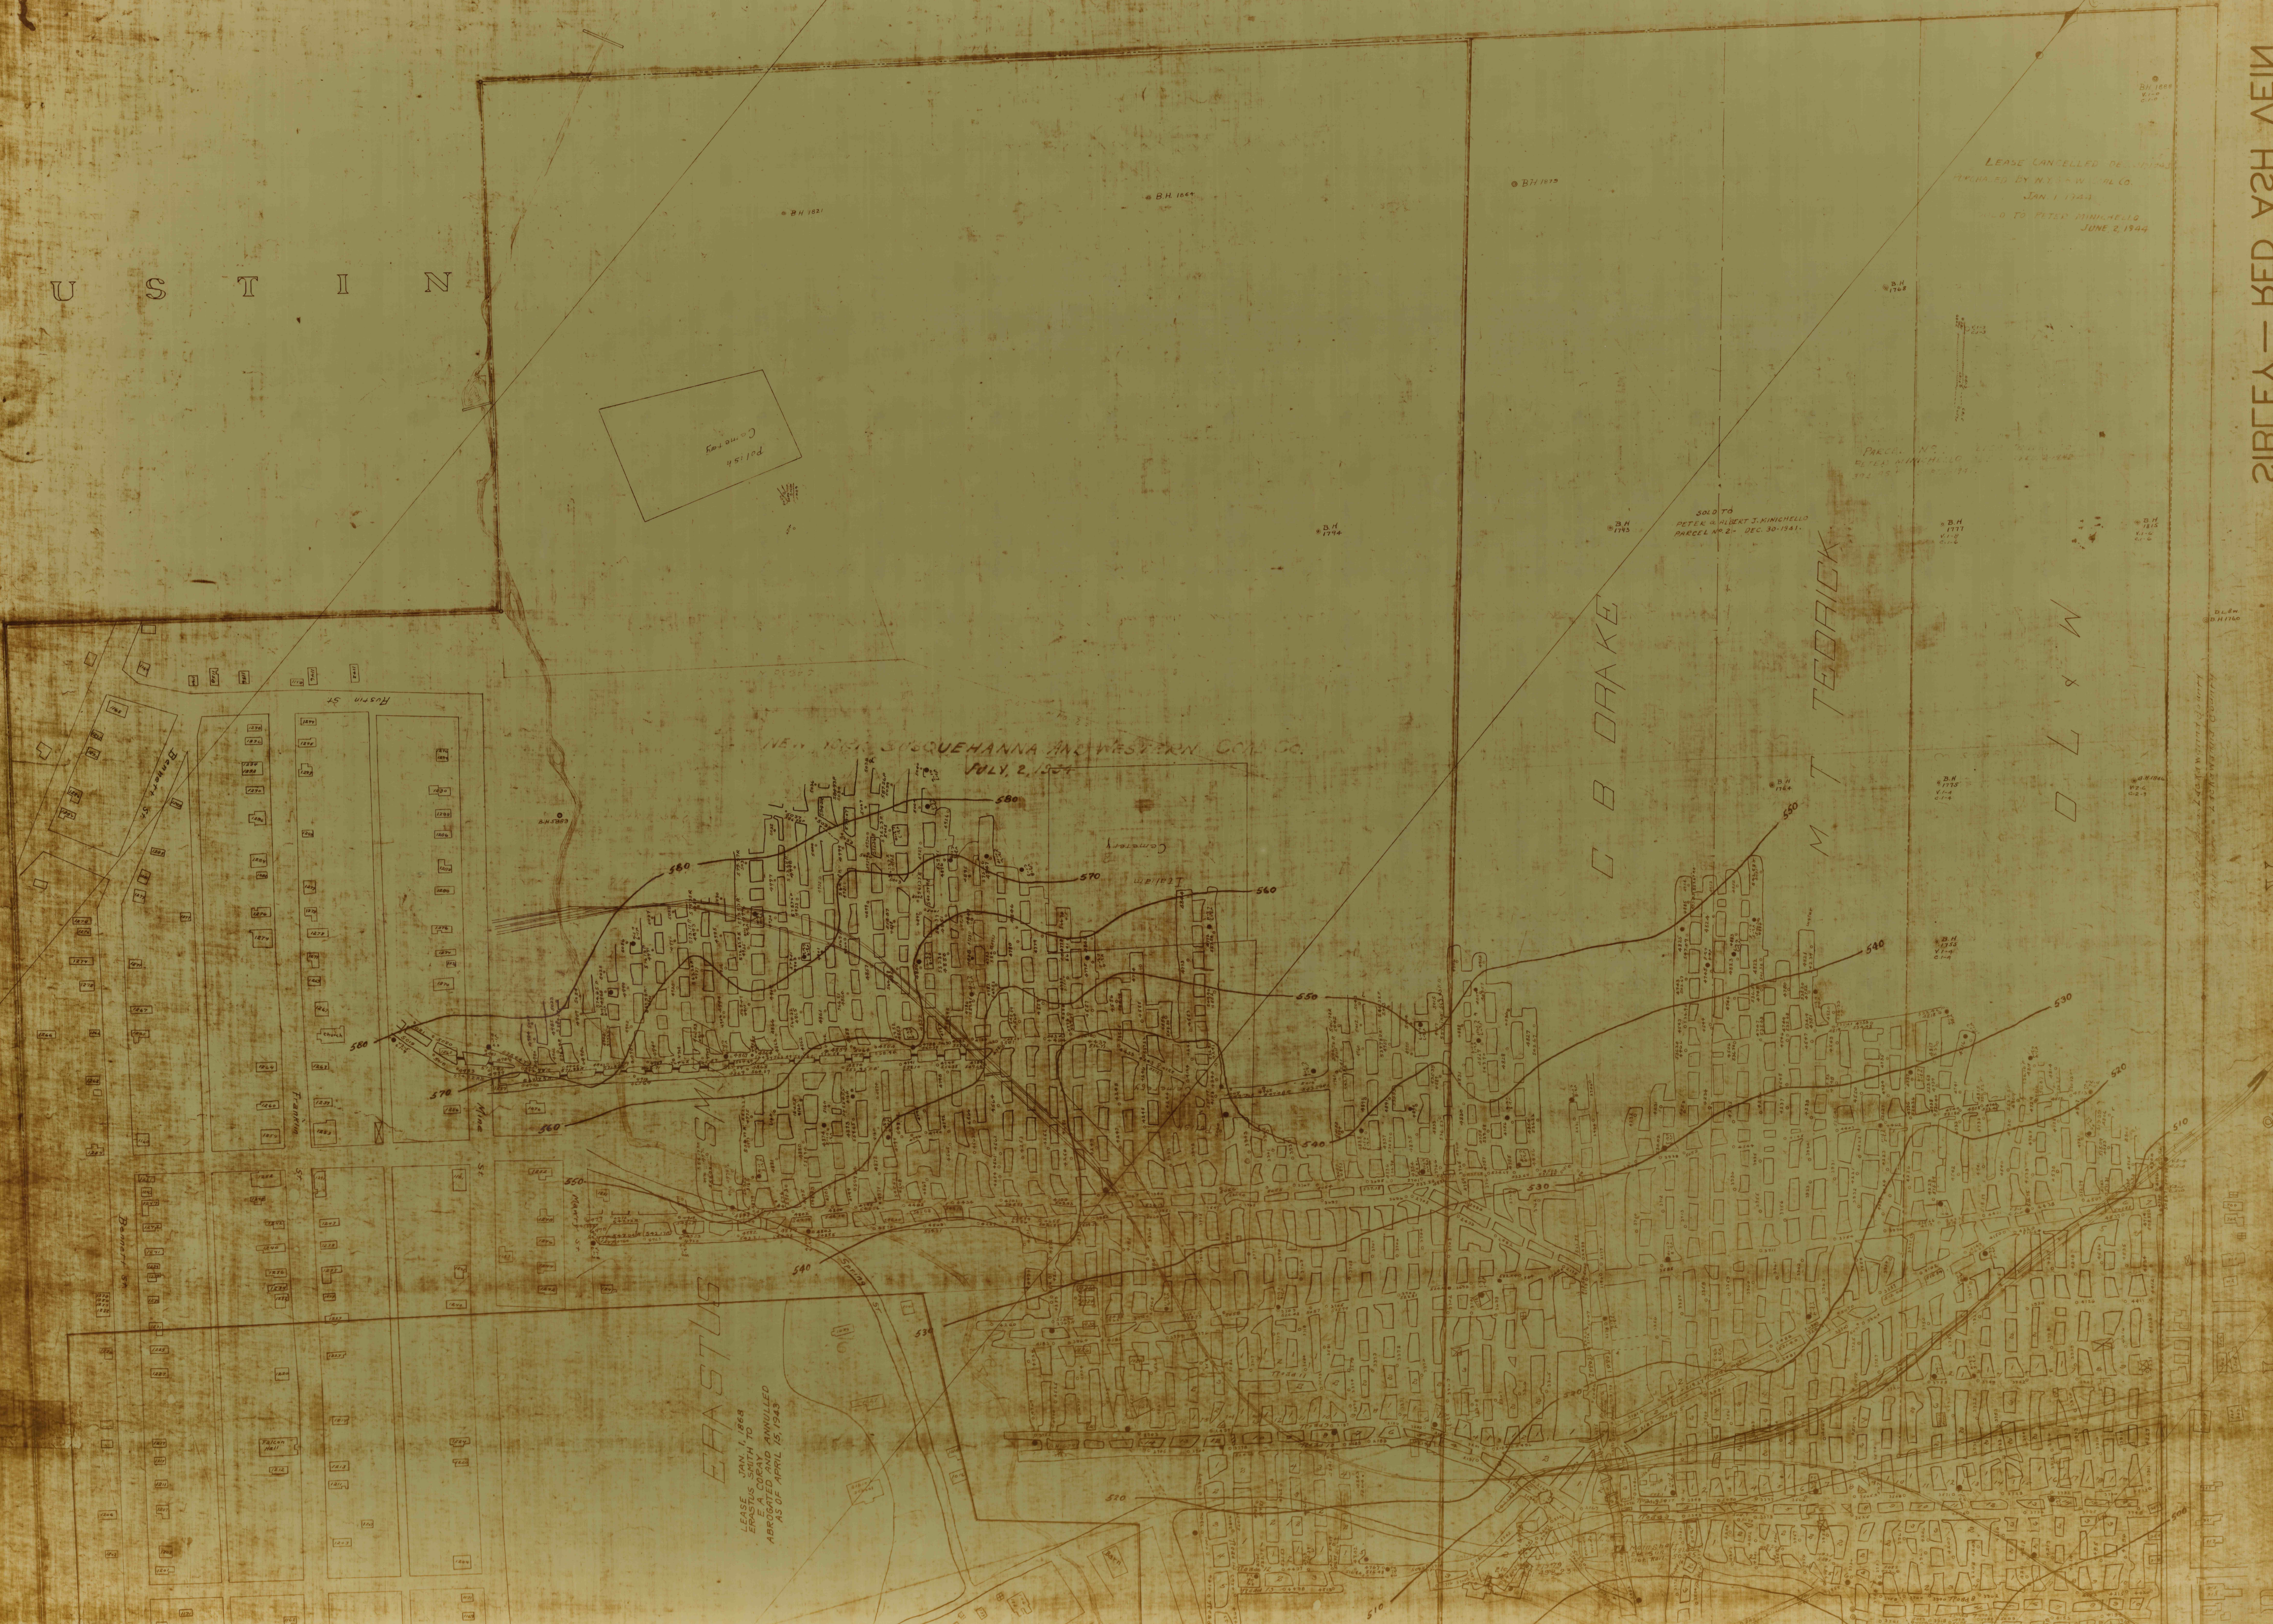

Polish Cemetery

JULY 2, 1944

ERASTUS  
JAN. 1, 1868  
LEASE TO  
E. A. COGAY  
ABROGATED AND ANNULLED  
AS OF APRIL 15, 1945

LEASE CANCELLED BY N.Y.S.W. CO.  
JAN. 1, 1944  
SOLD TO PETER MINICHIELLO  
JUNE 2, 1944

SOLD TO  
PETER & WILET J. MINICHIELLO  
PARCEL NO. 27 - DEC. 30, 1941.

C B DRAKE

M T TEDRICK

D O L & W

W.