




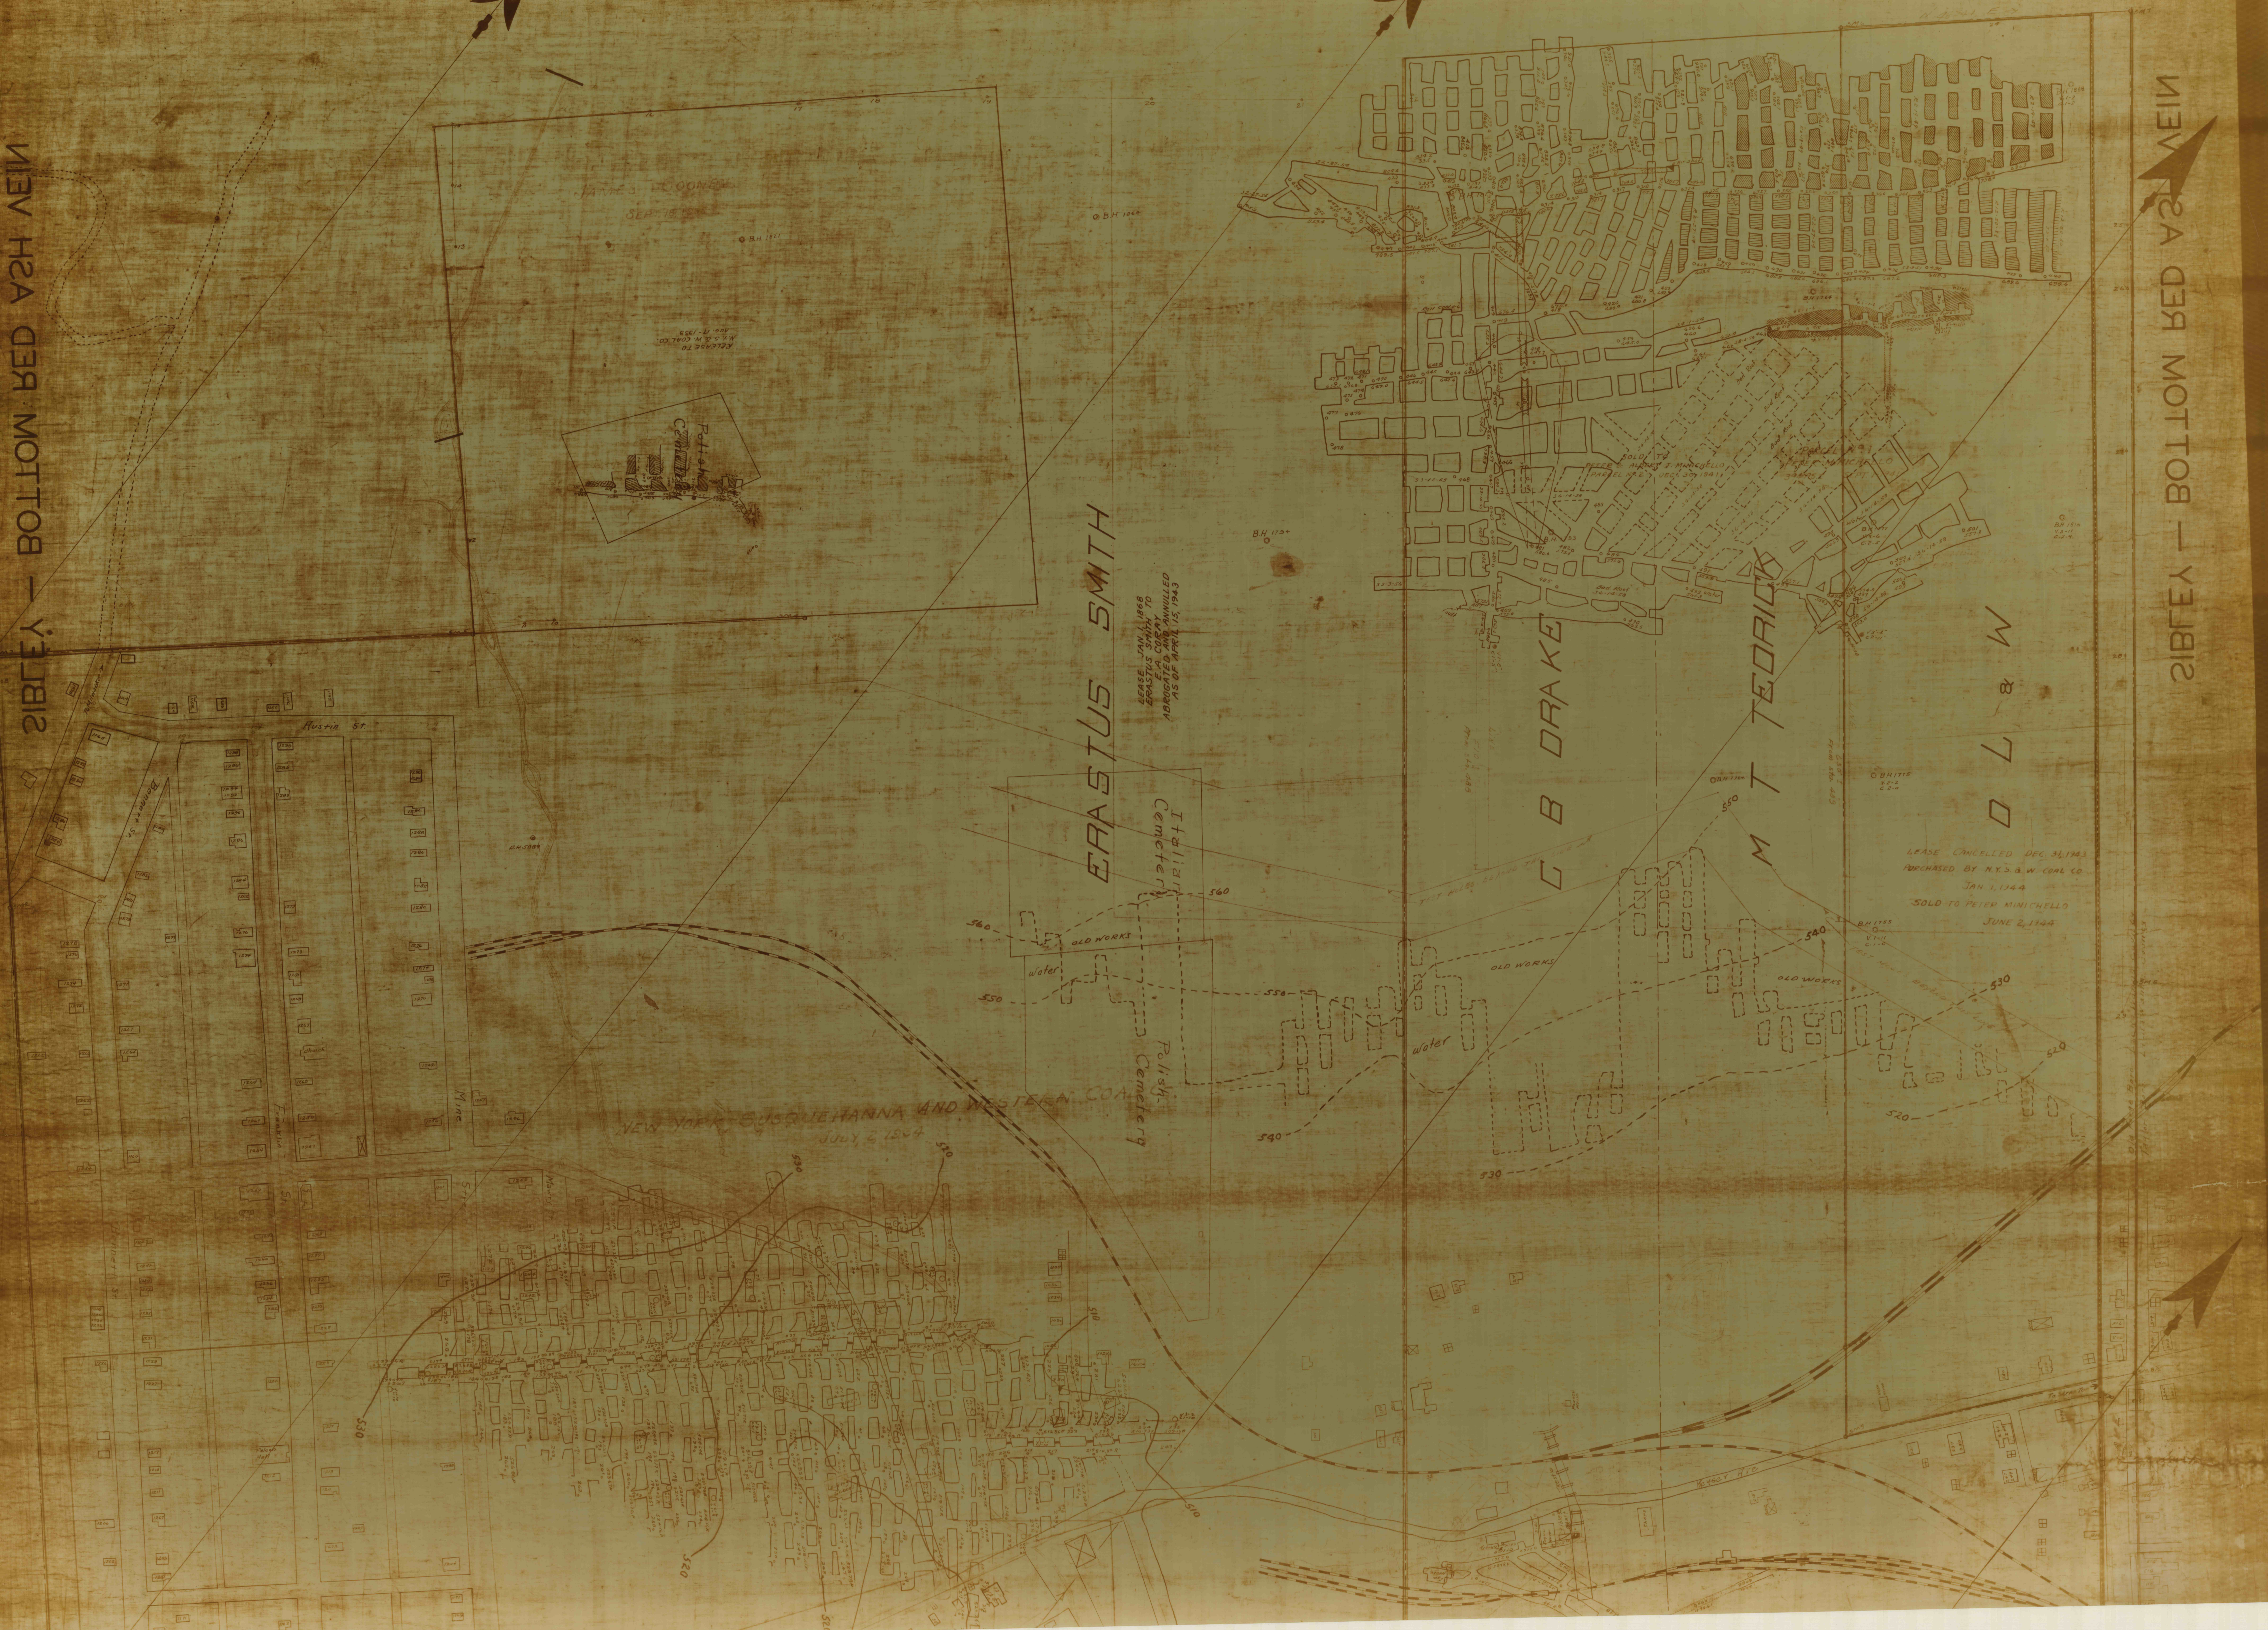

ERASTUS SMITH

C B DRAKE

M T TEORICK

ERASTUS SMITH
JAN. 1, 1943
AS OF APRIL 15, 1943

Italian Cemetery
Polish Cemetery

NEW YORK SUSQUEHANNA AND WESTERN COAL
JULY 2, 1894

LEASE CANCELLED DEC 31, 1943
PURCHASED BY N.Y.S. & W. COAL CO.
JAN. 1, 1944
SOLD TO PETER MINICHELLO
JUNE 2, 1944

