


*Penn. Coal Co.*

*Sibley Coal Co.*

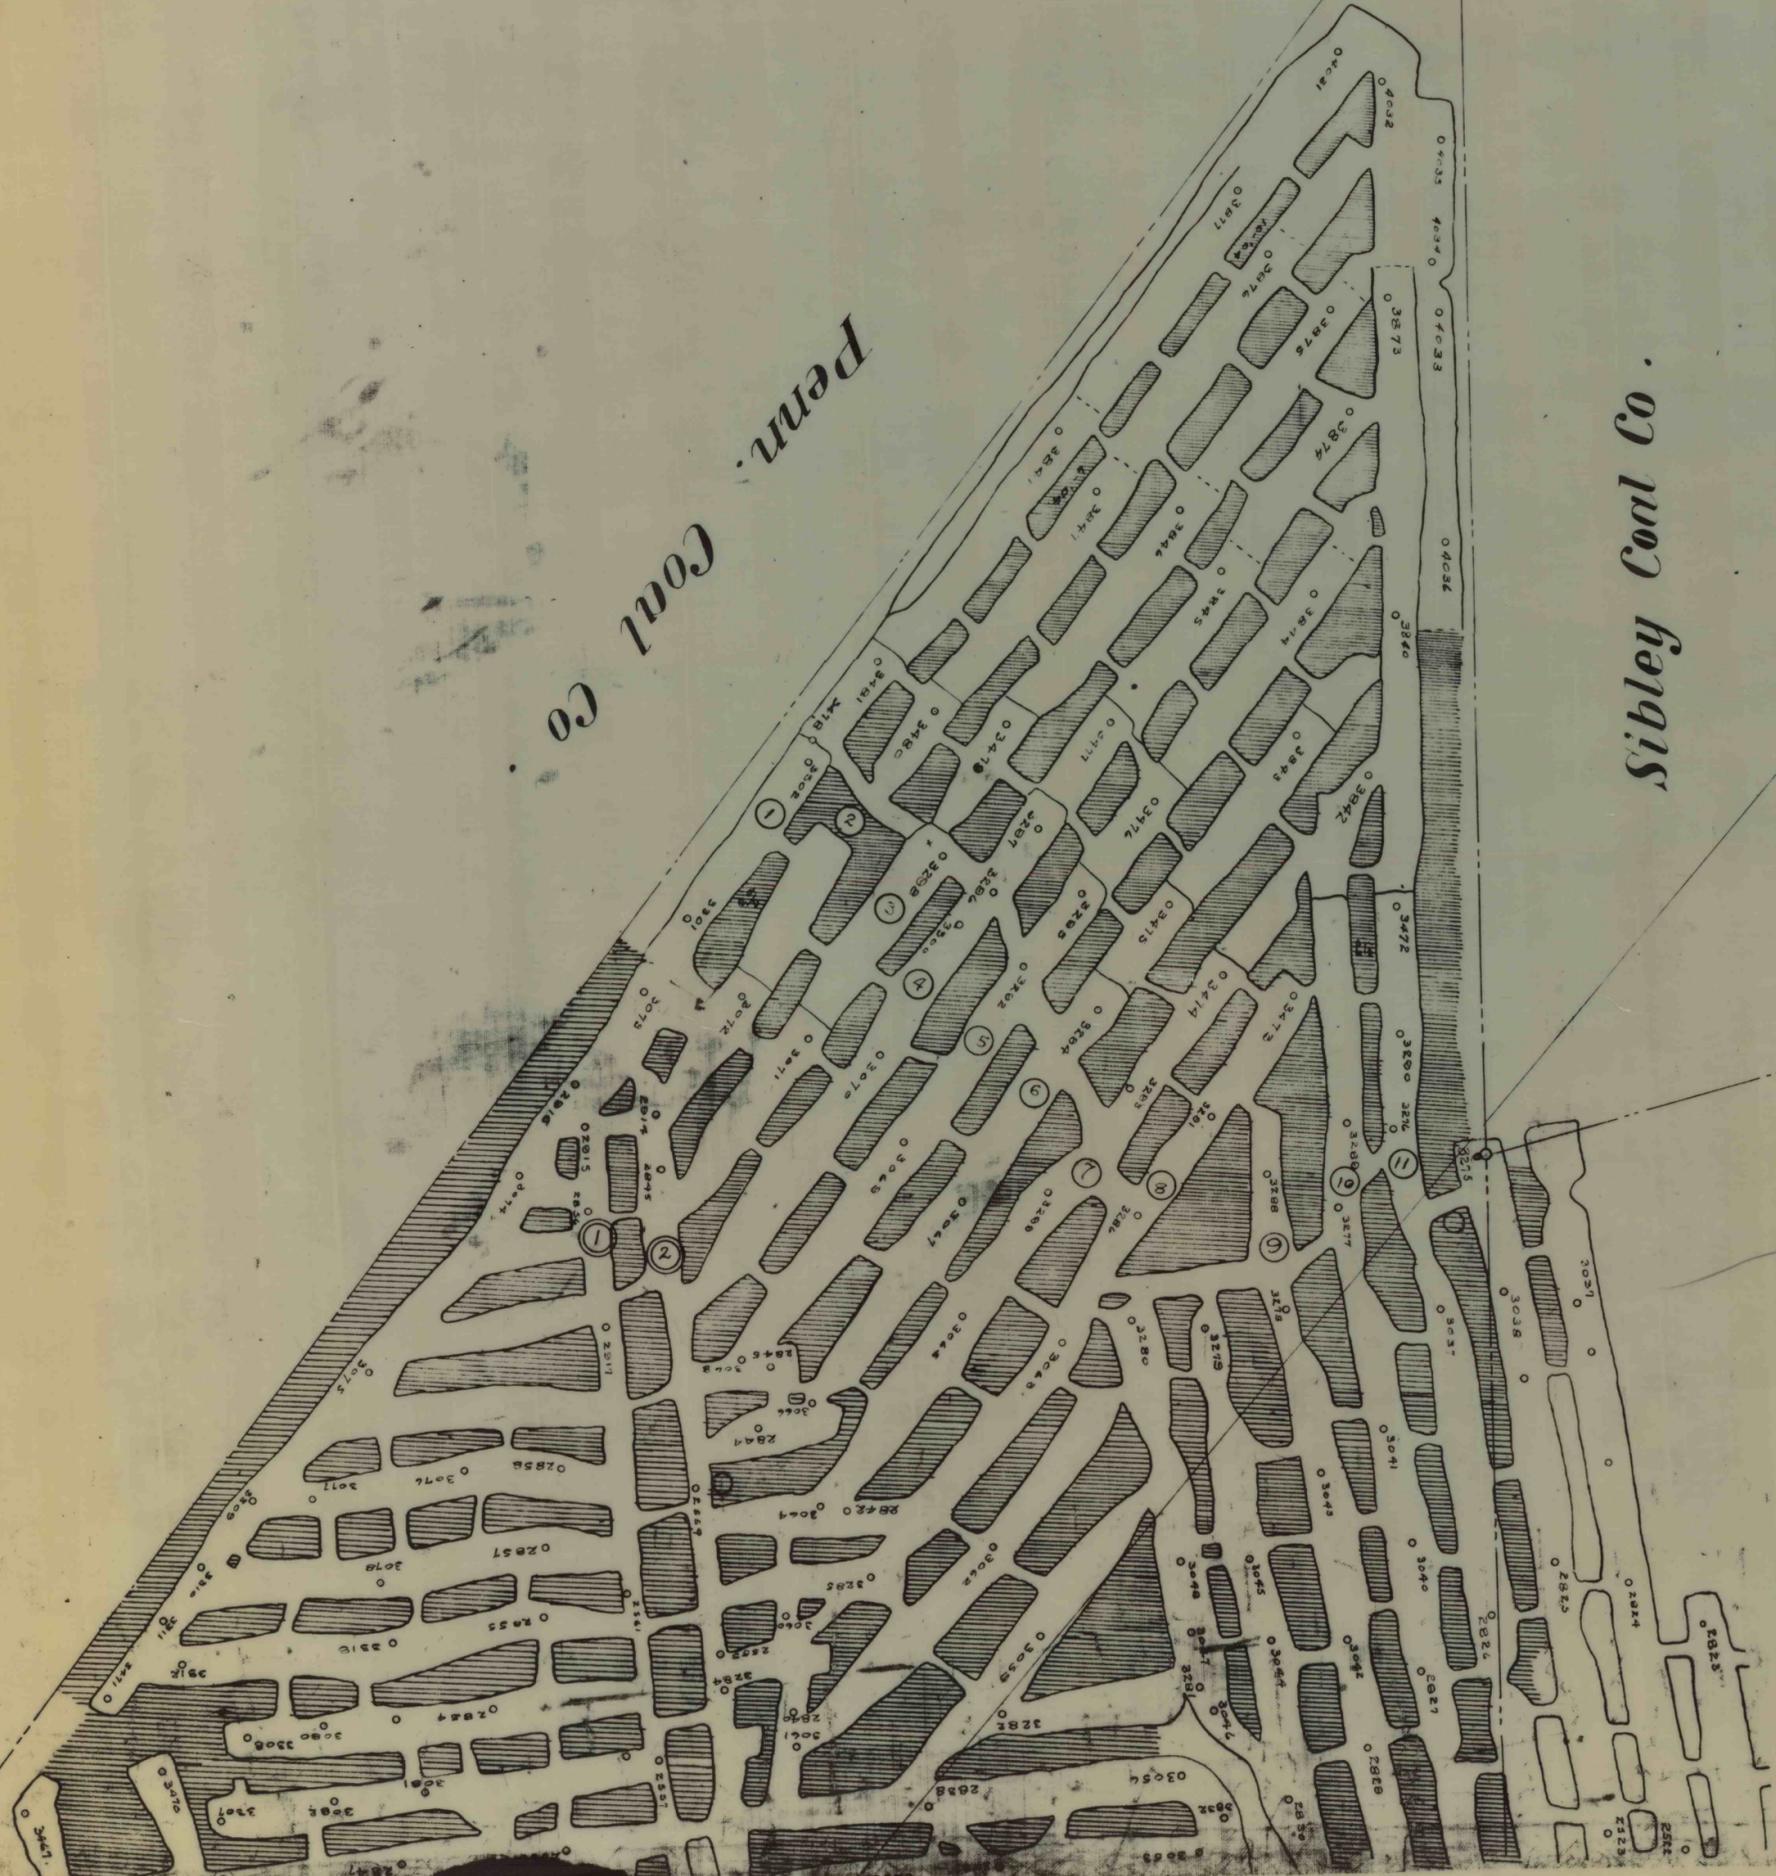

