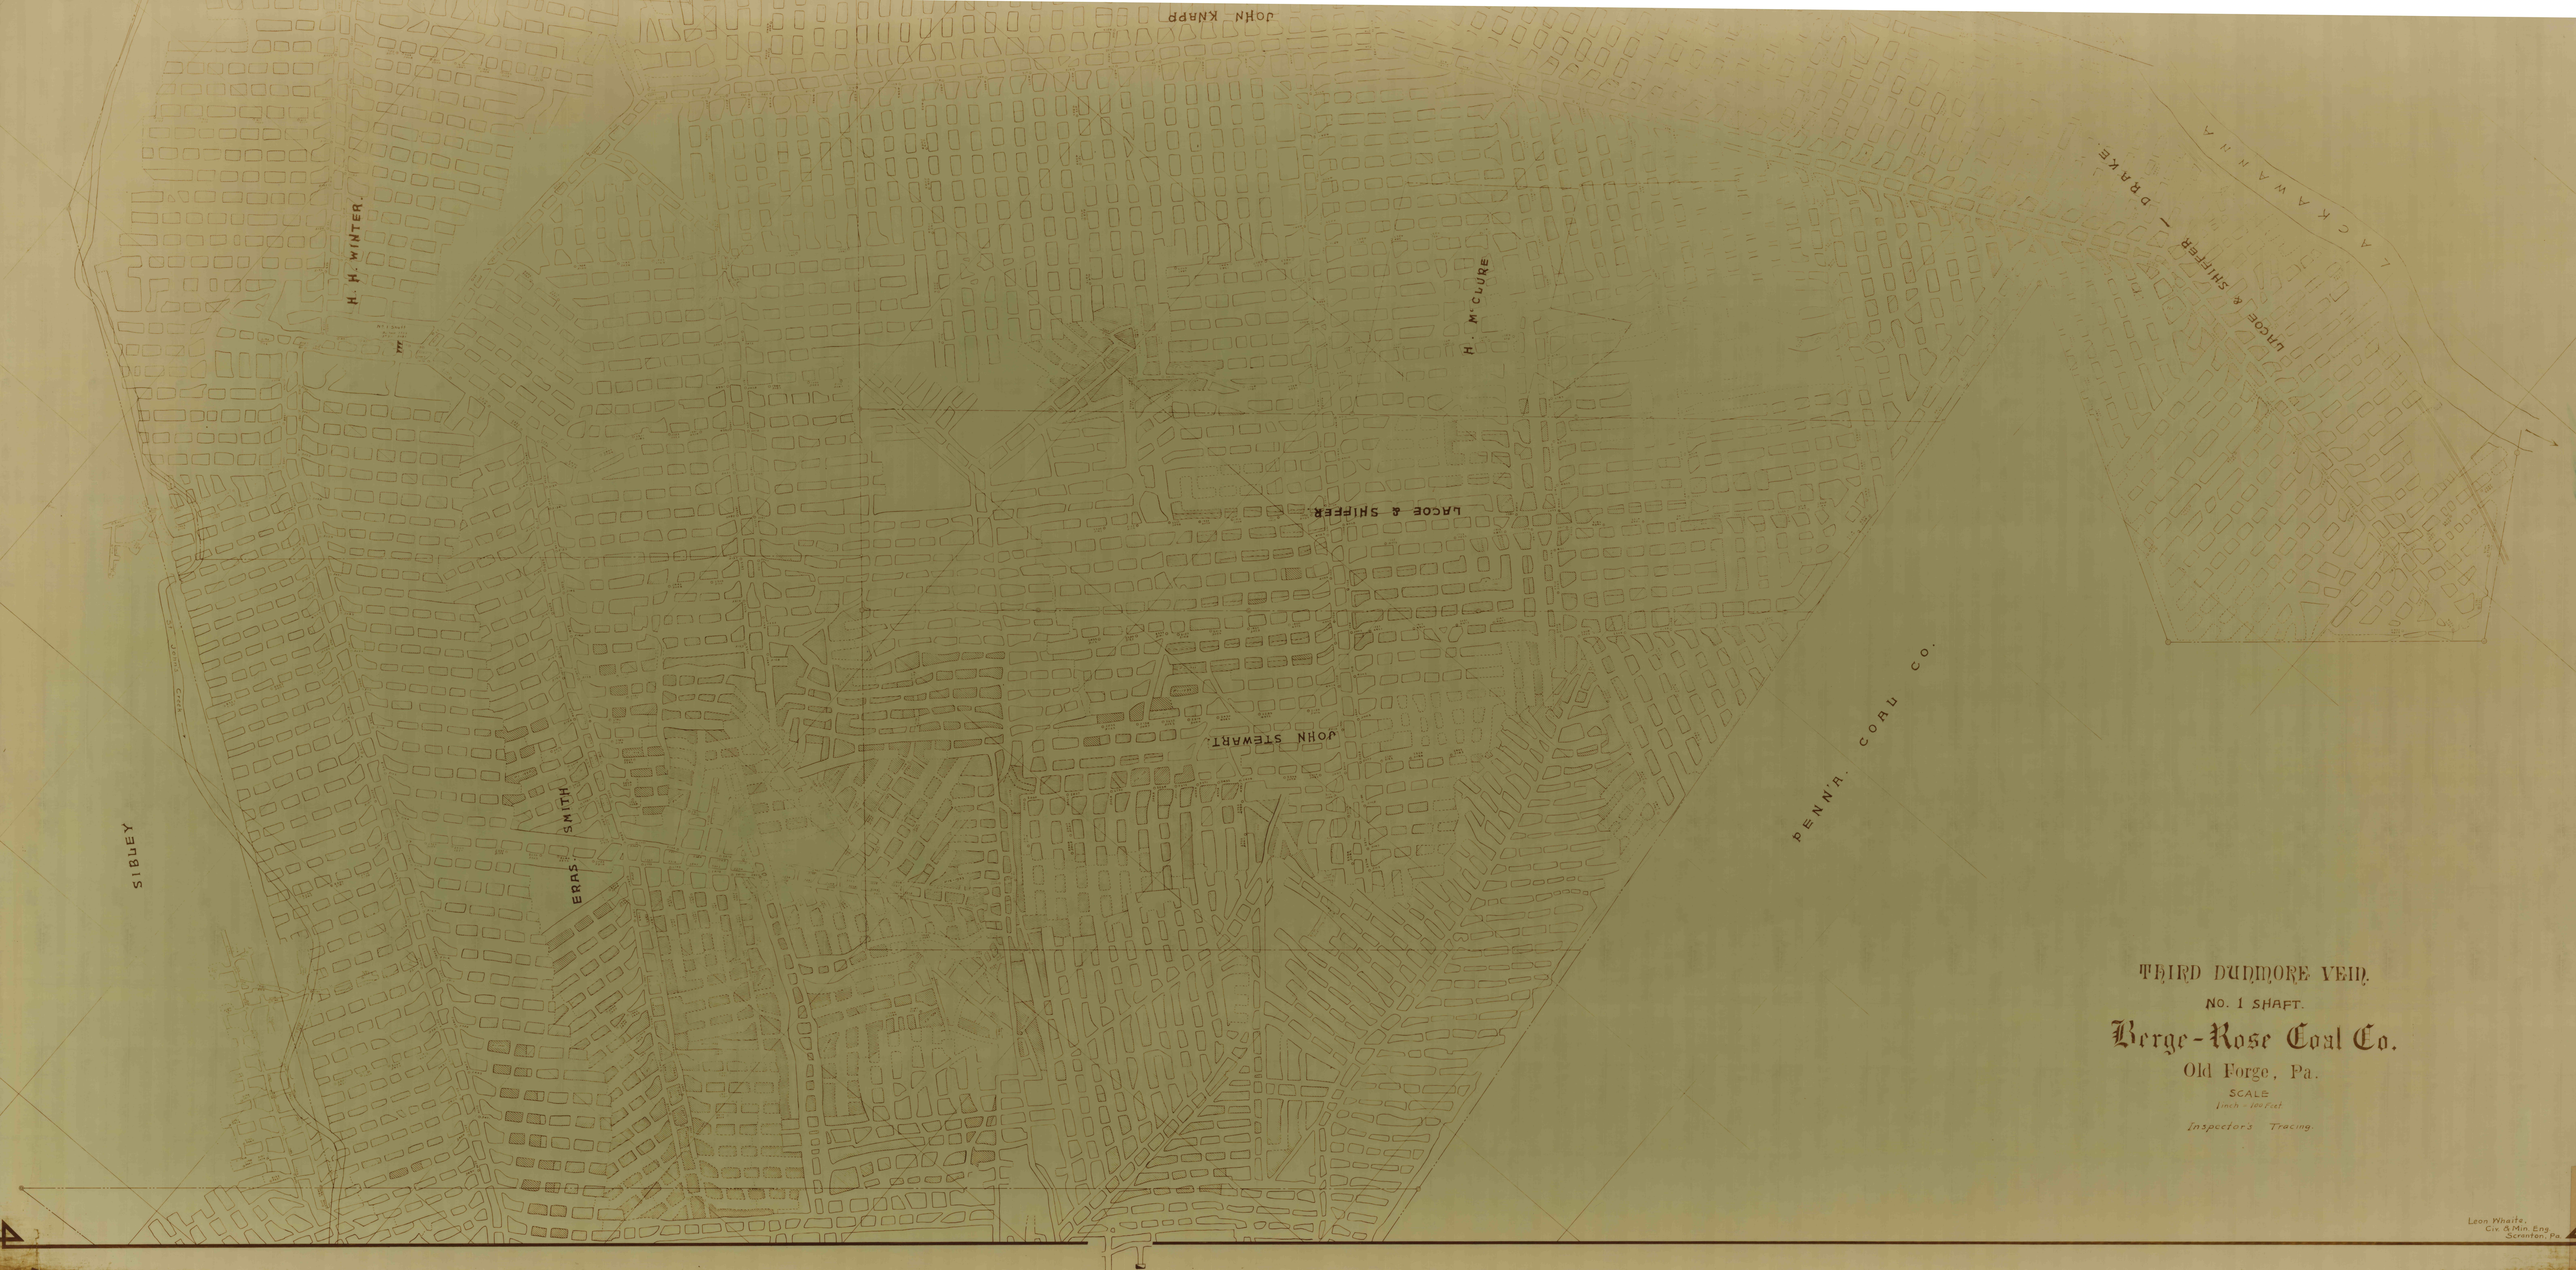
JOHN KNAPP
H. H. WINTER
H. McCUURE
LACOE & SHIFFER
LACOE & SHIFFER / DRAKE
LACKAWANNA
JOHN STEWART
PENN'A. COAL CO.
SMITH
ERAS
SIBLEY
THIRD DUNMORE VEIN.
No. 1 SHAFT.
Berge-Rose Coal Co.
Old Forge, Pa.
SCALE
1 inch = 100 Feet
Inspector's Tracing.
Leon Whaite,
Civ. & Min. Eng.
Scranton, Pa.