



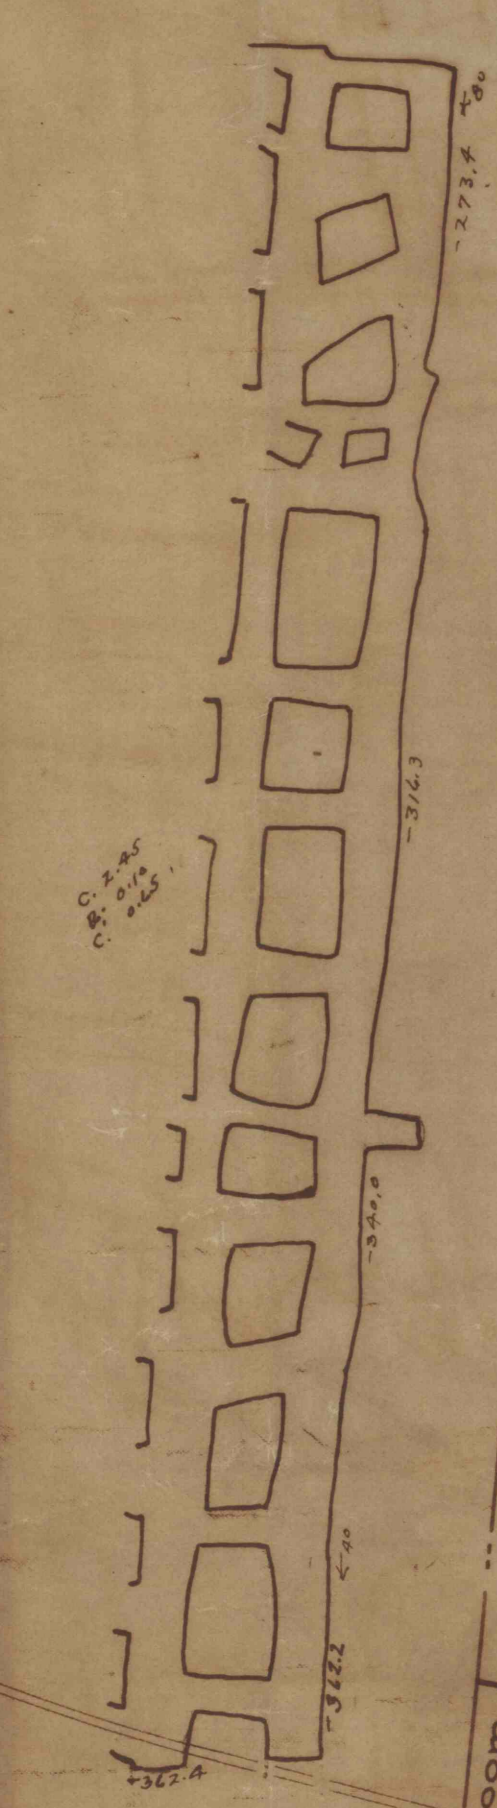

RESERVE
110-12-1

DO NOT WALK OVER THIS LINE

CO.

DO NOT WALK OVER THIS LINE

110-12-1

N

B

I

T

T