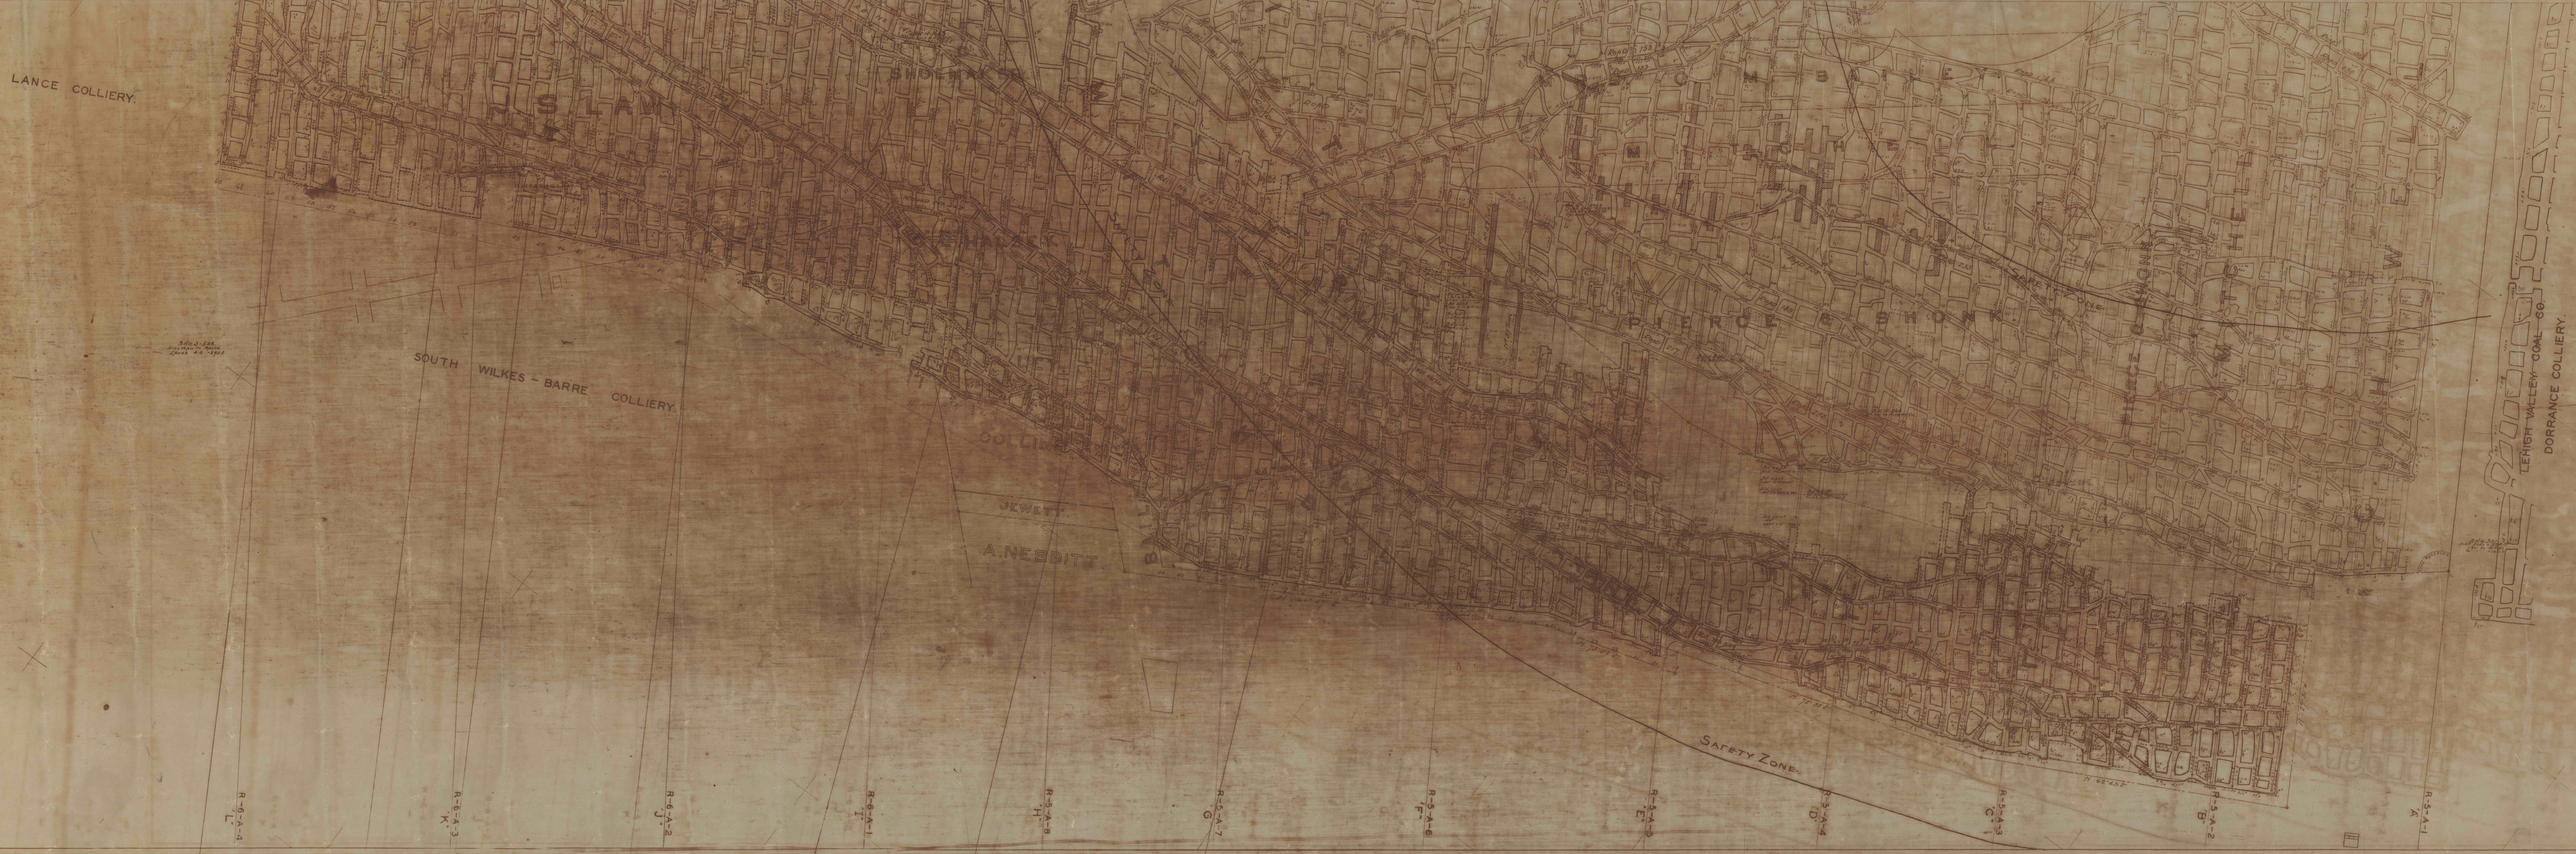
LANCE COLLIERY.
SOUTH WILKES - BARRE COLLIERY.
JEWETT
A. NESBITT
SAFETY ZONE
PIERCE & SHONK
LEHIGH VALLEY COAL CO.
DORRANCE COLLIERY.
R-6-A-9 J
R-6-A-3 K
R-6-A-2 J
R-6-A-1 I
R-5-A-9 H
R-5-A-7 G
R-5-A-6 F
R-5-A-5 E
R-5-A-4 D
R-5-A-3 C
R-5-A-2 B
R-5-A-1 A

LANCE – SOUTH