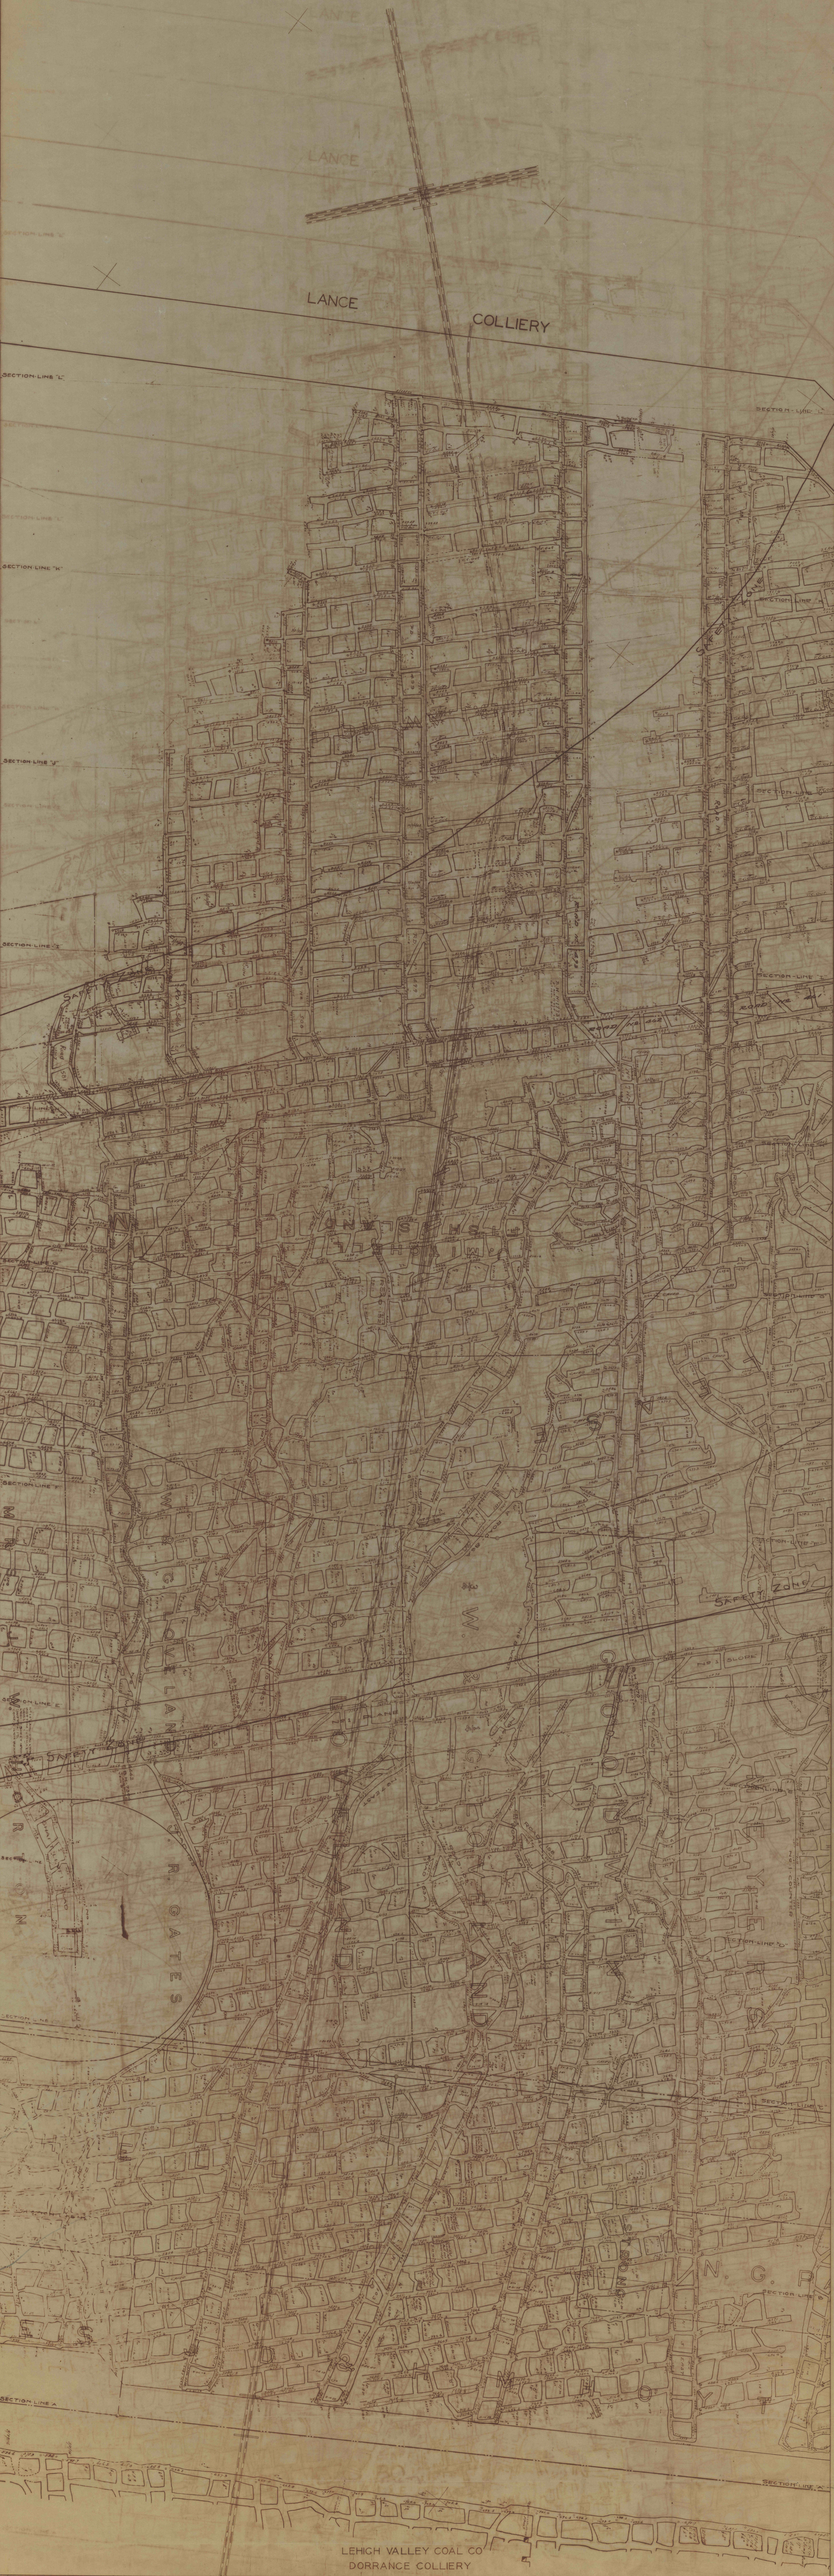

LEHIGH VALLEY COAL CO
DORRANCE COLLIERY