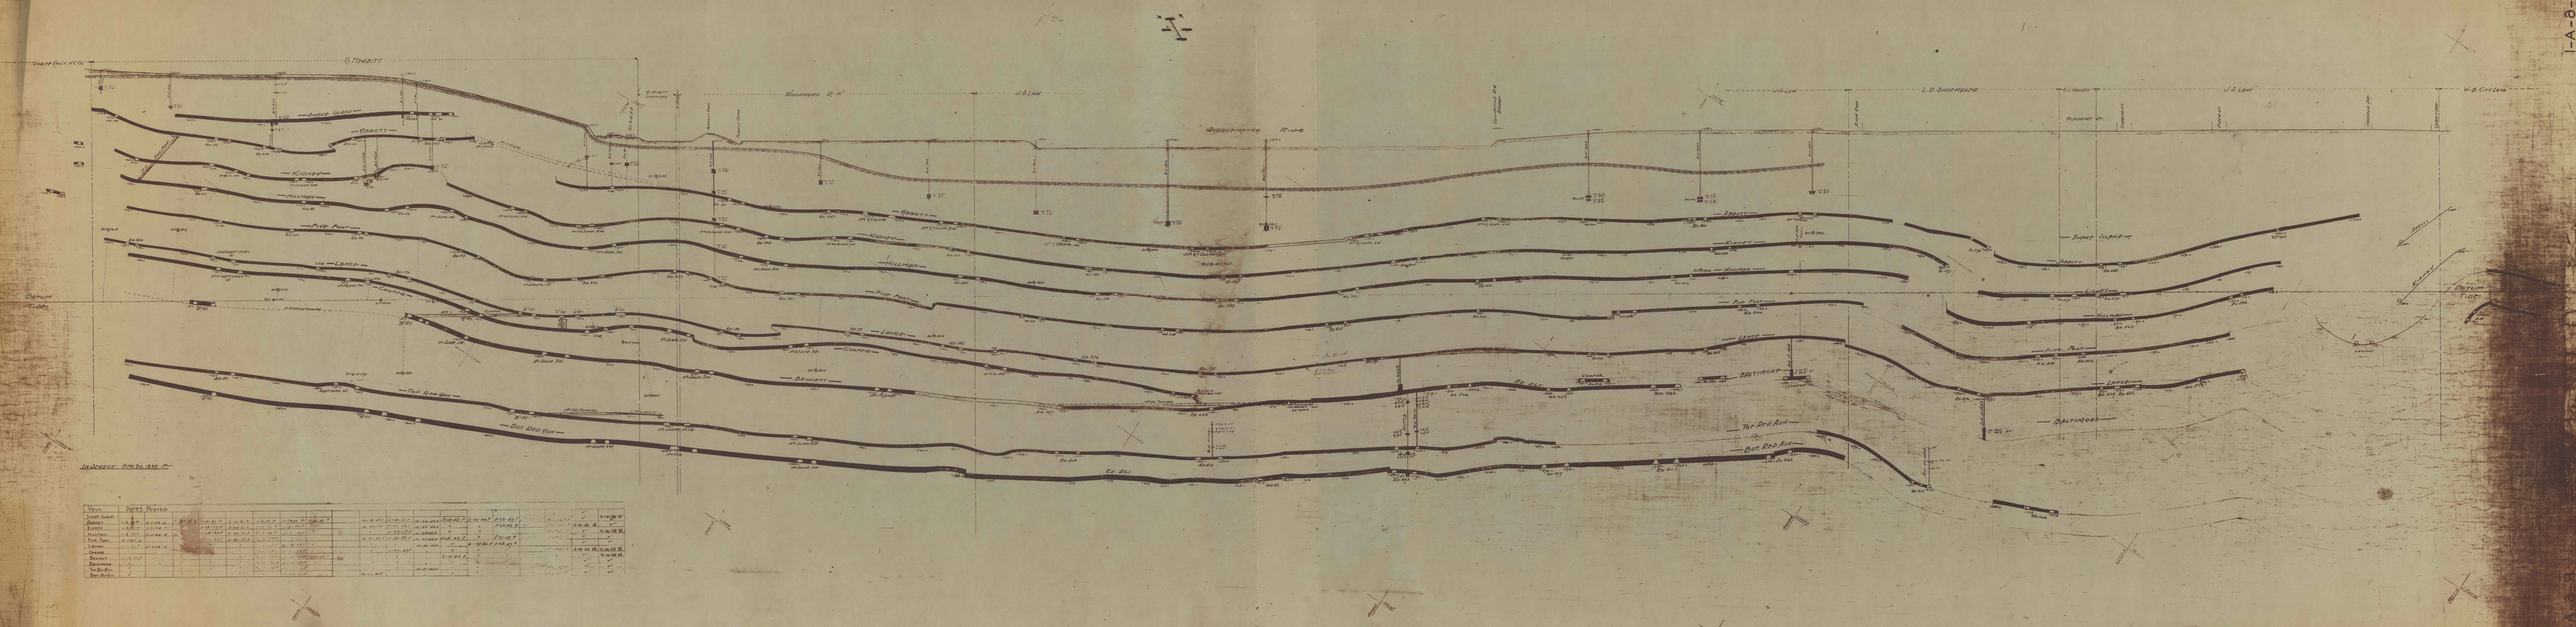

Vein	Dates Proved																		
Sugar Island																			
Abbott																			
Kinney																			
Hillman																			
Five Foot																			
Leech																			
Cooper																			
Bennett																			
Baltimore																			
Two Red Ash																			
Bot. Red Ash																			