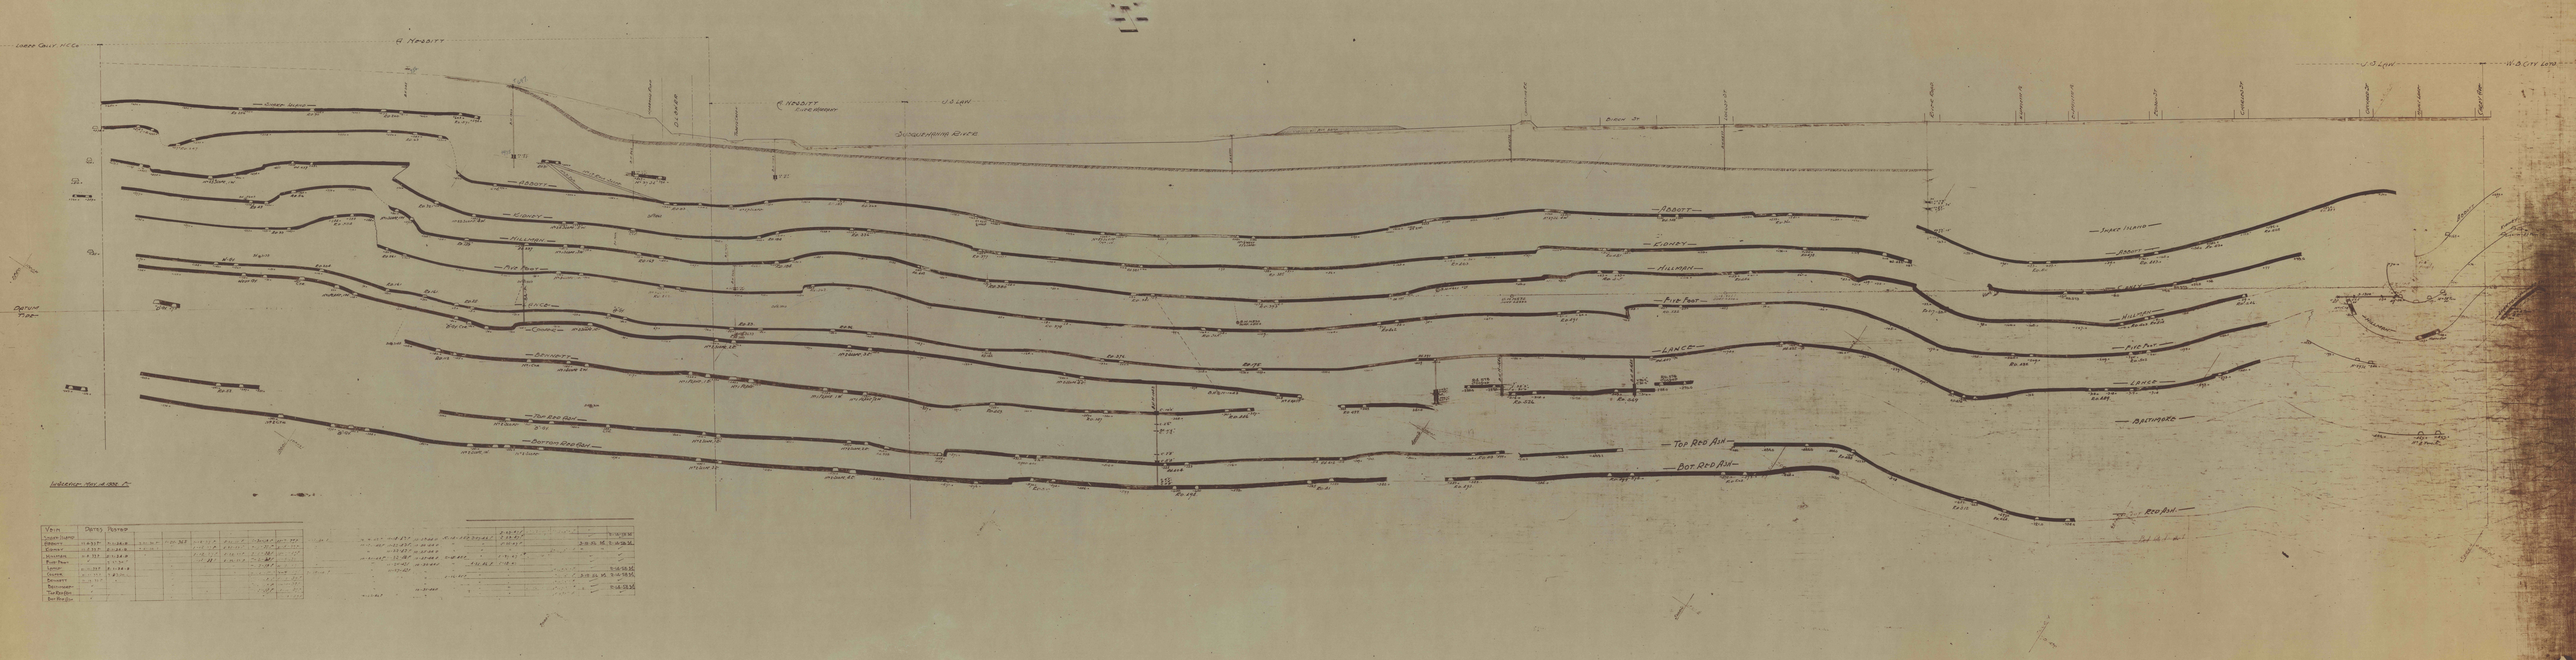

Top Red Ash													
Bottom Red Ash													