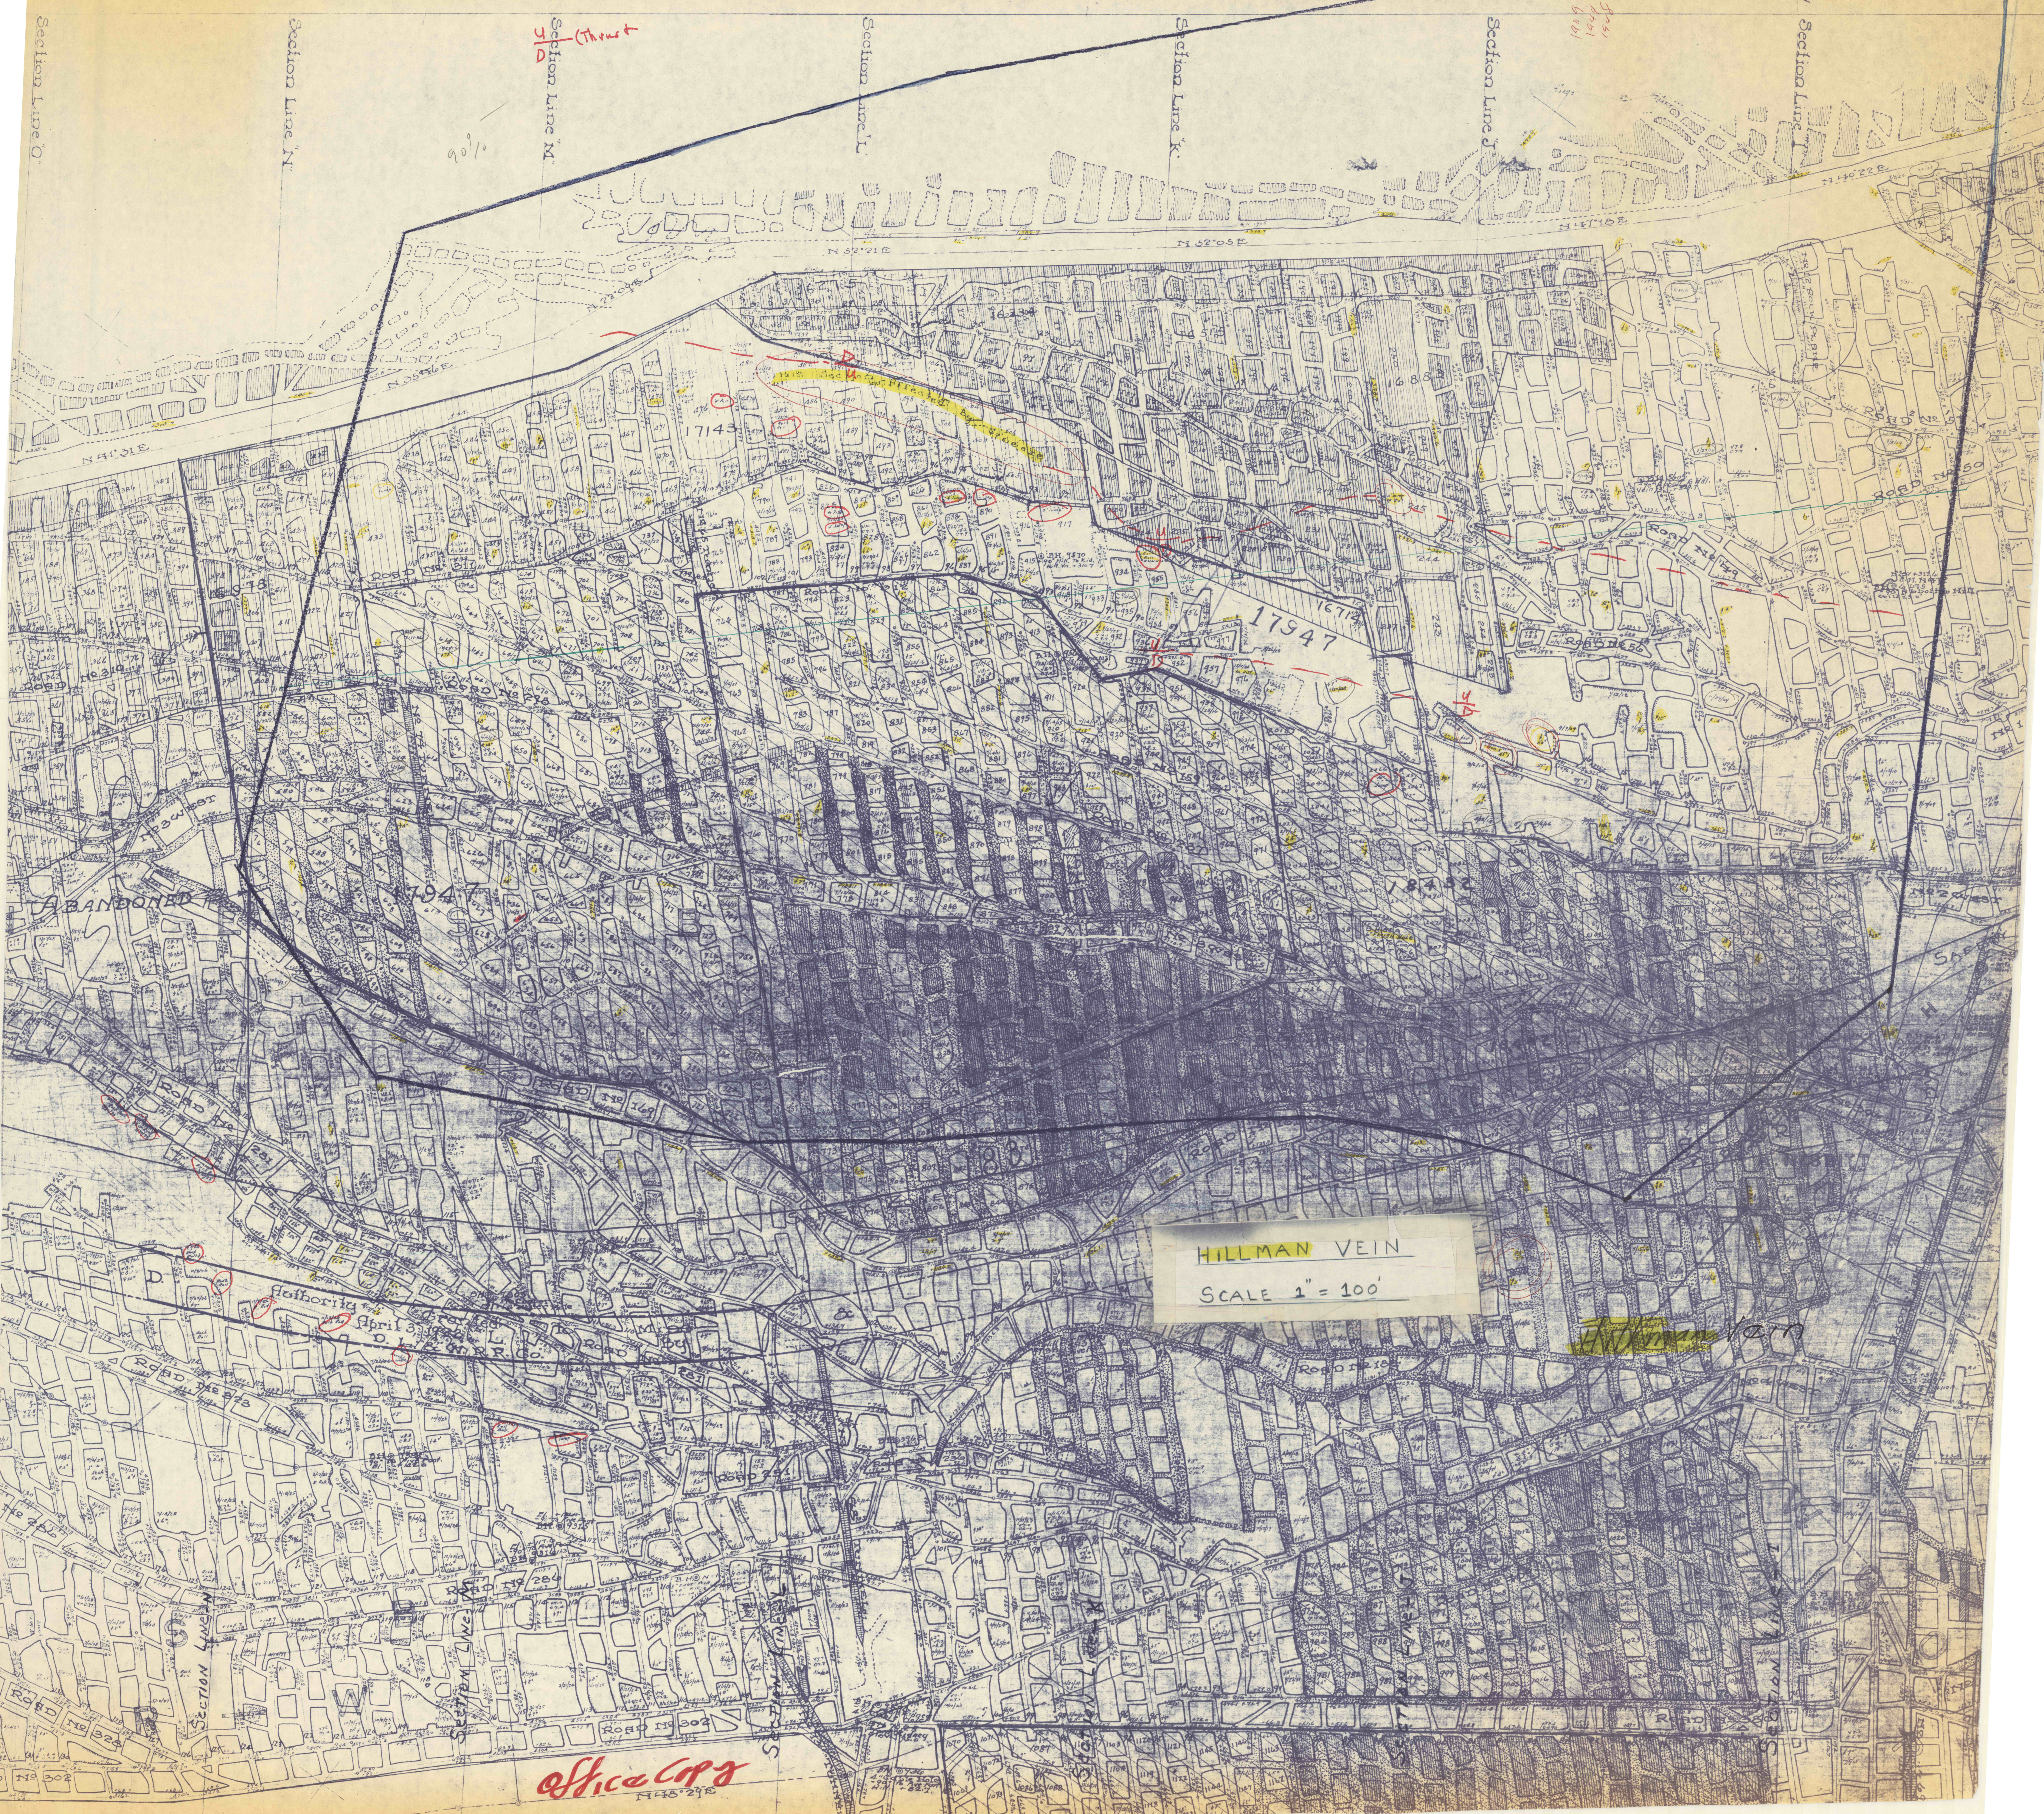
HILLMAN VEIN
SCALE 1" = 100'
Section Line "O"
Section Line "N"
Section Line "M"
Section Line "L"
Section Line "K"
Section Line "J"
Section Line "I"
U/D (Thrust
90%
N 41°31E
N 35°46E
N 52°21E
N 52°05E
N 47°18E
N 40°22E
17143
16234
16888
17947
16714
18432
ABANDONED
Road No 310
Road No 278
Road No 312
Road No 169
Road No 281
Road No 323
Road No 286
Road No 302
Road No 328
Road No 50
Road No 56
No 3 West
Hillman Vein
Office Copy
N 48°29E