


HILLSIDE AVENUE


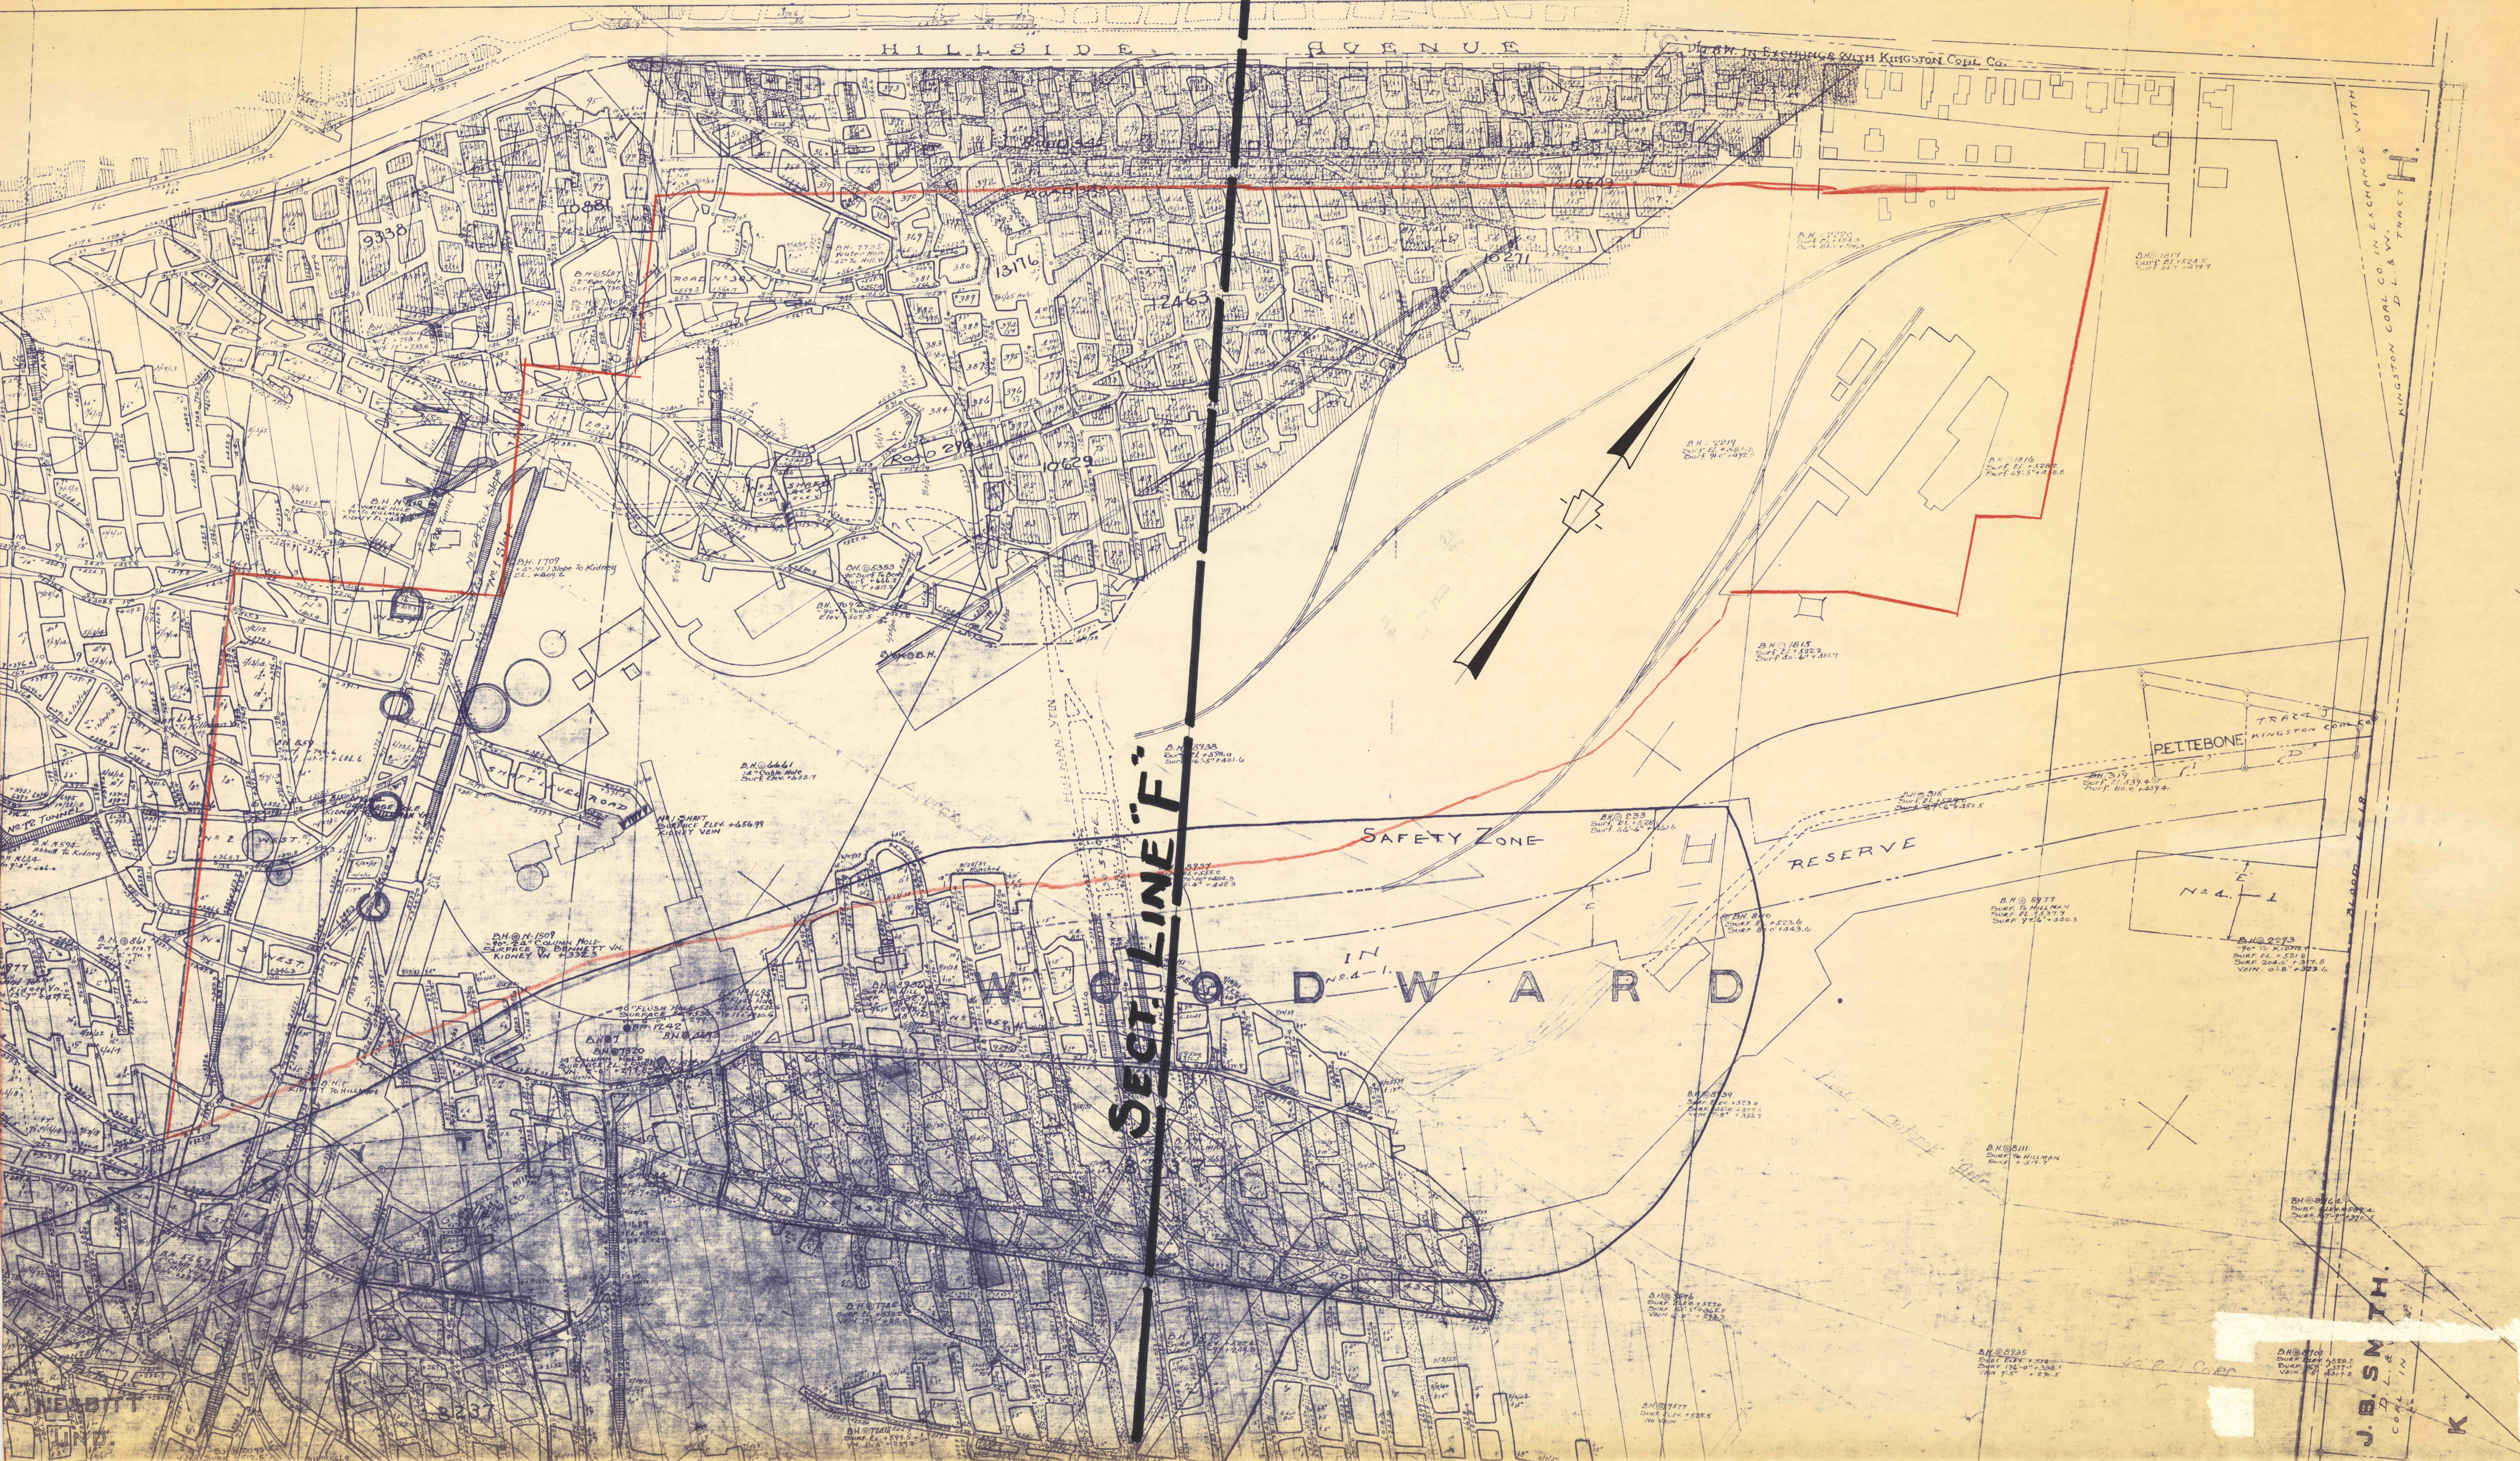

9338

1088

1316

2463

6271

10629

SECT. LINE "F"

SAFETY ZONE

RESERVE

WOODWARD

PETTEBONE KINGSTON COAL CO.

J. B. SMITH
D. L. &
K