


CROSS-SECTION "E"

ESE

NNW

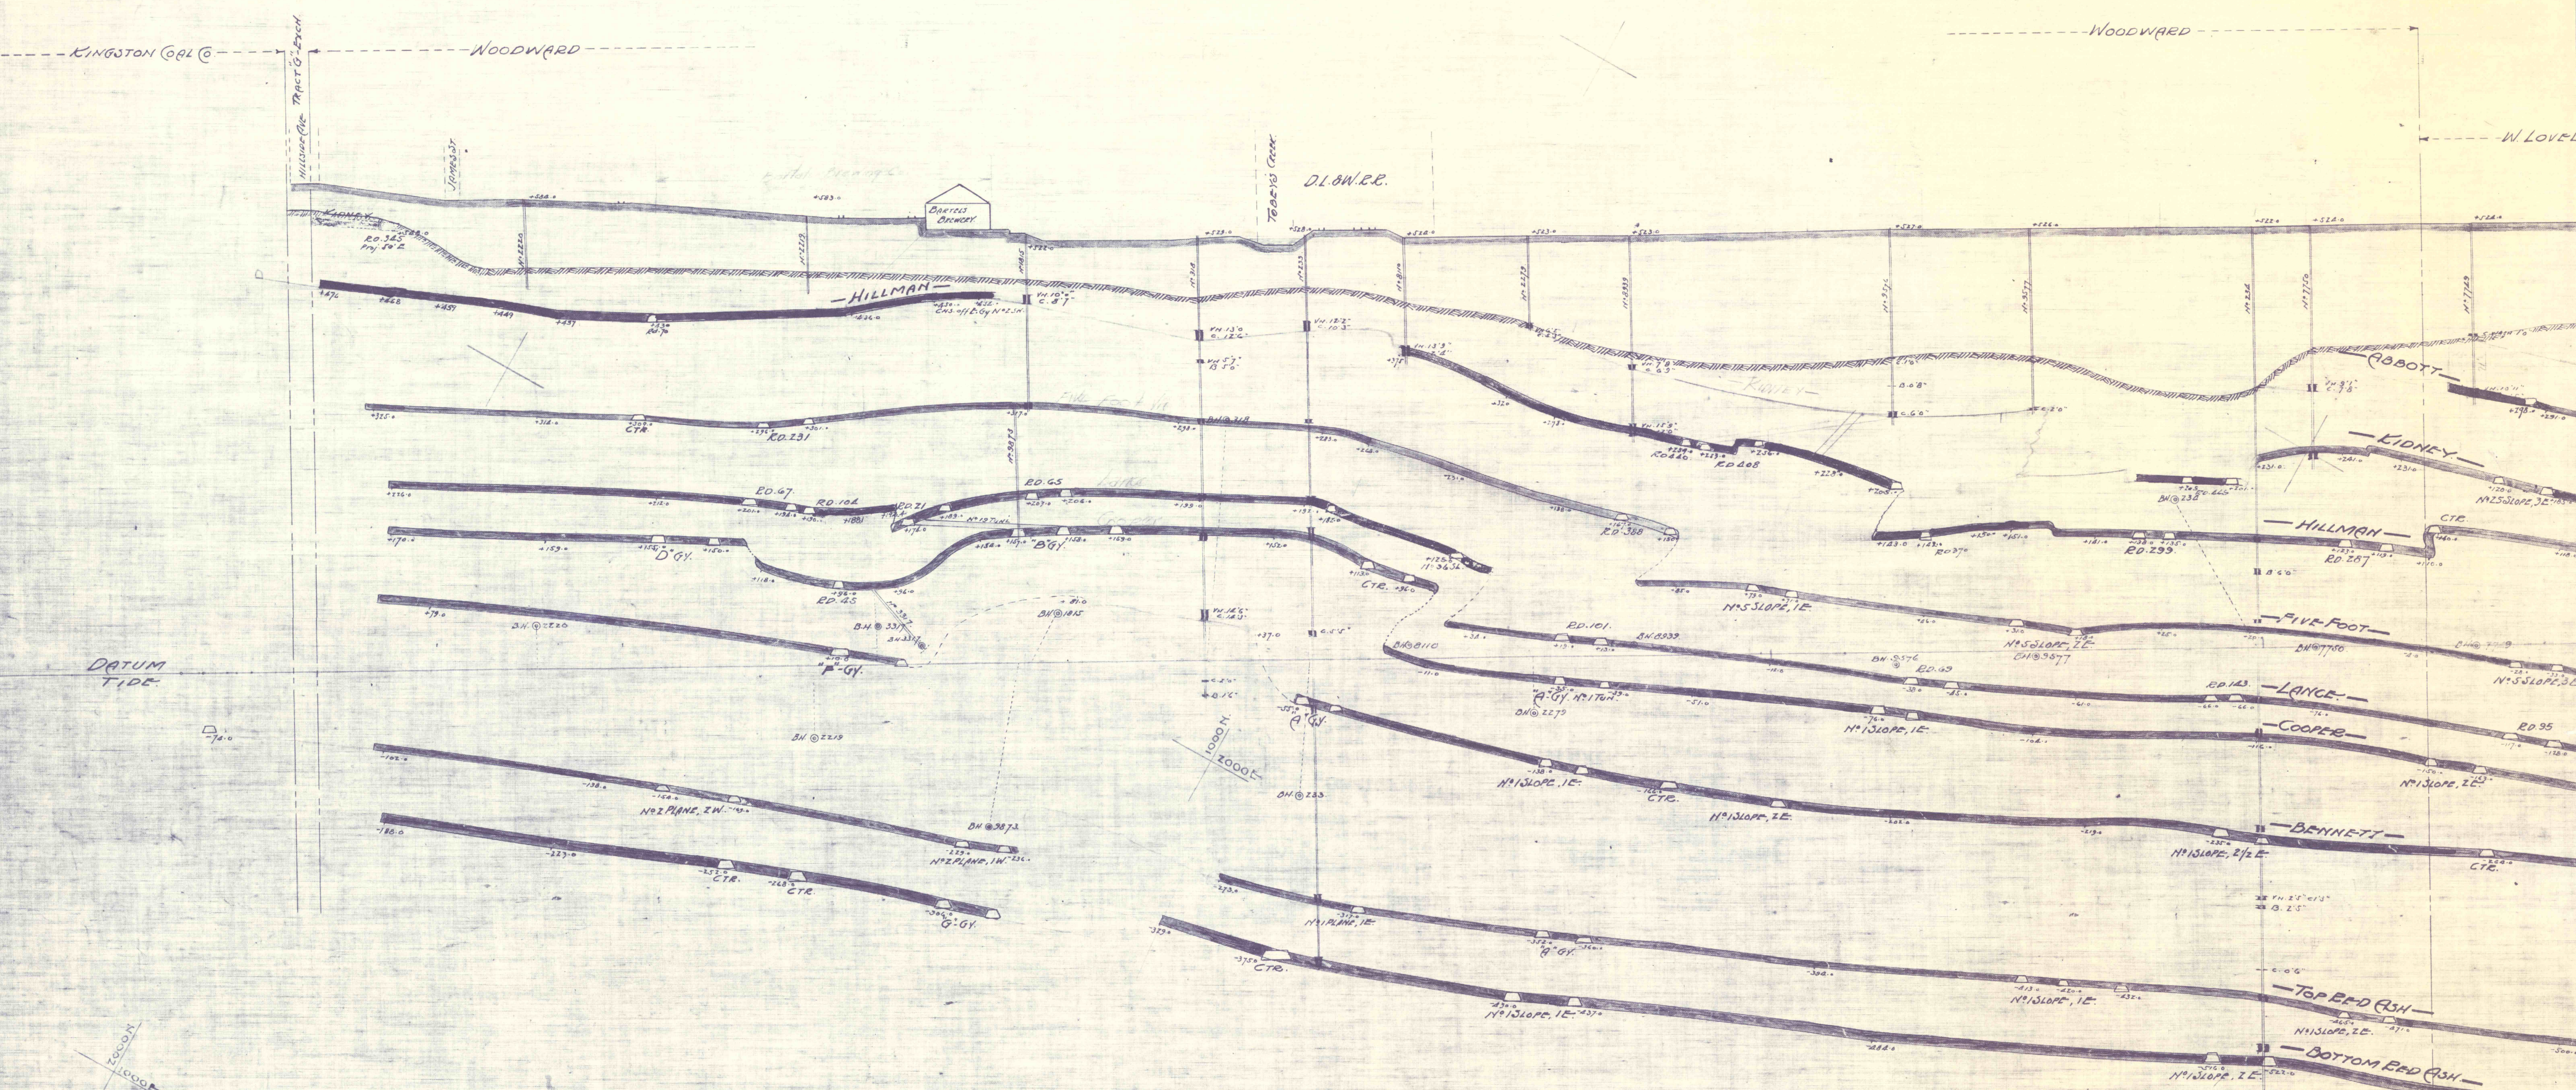

IN SERVICE, AUG. 29, 1932 F

VEIN	DATES POSTED																	
SNARE ISLAND																		
ABBOTT	11-4-33 F	7-20-34 F	1-2-36 F	1-12-37 F	5-25-37 F	2-20-38 F	11-7-38 F		10-14-41 F	11-18-43 F	10-24-44 F	5-14-45 F	3-27-46 F	5-23-47 F	5-22-48 F	10-16-49 F	3-12-56 F	2-13-58 F
KIDNEY	✓	✓	✓	1-12-37 F	5-25-37 F	7-1-38 F	11-8-38 F		10-20-42 F	11-22-43 F	10-20-44 F	"	"	5-26-47 F			✓	2-14-58 F
HILLMAN	11-8-33 F	7-23-34 F		1-12-37 F	5-25-37 F	7-1-38 F	11-4-38 F		"	11-25-43 F	10-28-44 F	"	"	"	10-11-48 F		✓	
FIVE FOOT	11-9-33 F			1-12-37 F	5-26-37 F	7-2-38 F	11-4-38 F		10-21-42 F	11-24-43 F	10-27-44 F	5-15-45 F		5-27-47 F			✓	
LANCE	✓	✓	✓								10-20-44 F		4-25-46 F	5-28-47 F			✓	
COOPER	✓	✓	✓			7-2-38 F	11-4-38 F			11-27-43 F							✓	
BENNETT	✓	✓	✓			7-1-38 F	11-10-38 F					5-16-45 F					✓	
DALTIMORE	✓	✓	✓			7-1-38 F	11-10-38 F										✓	
TOP BED RSH	✓	✓	✓			7-1-38 F	11-10-38 F		10-21-42 F		10-31-44 F			5-28-47 F	2-15-48 F		✓	
BOT BED RSH	✓	✓	✓						10-22-42 F								✓	

1000 FT

1000 FT