


# CROSS - SECTION "D"

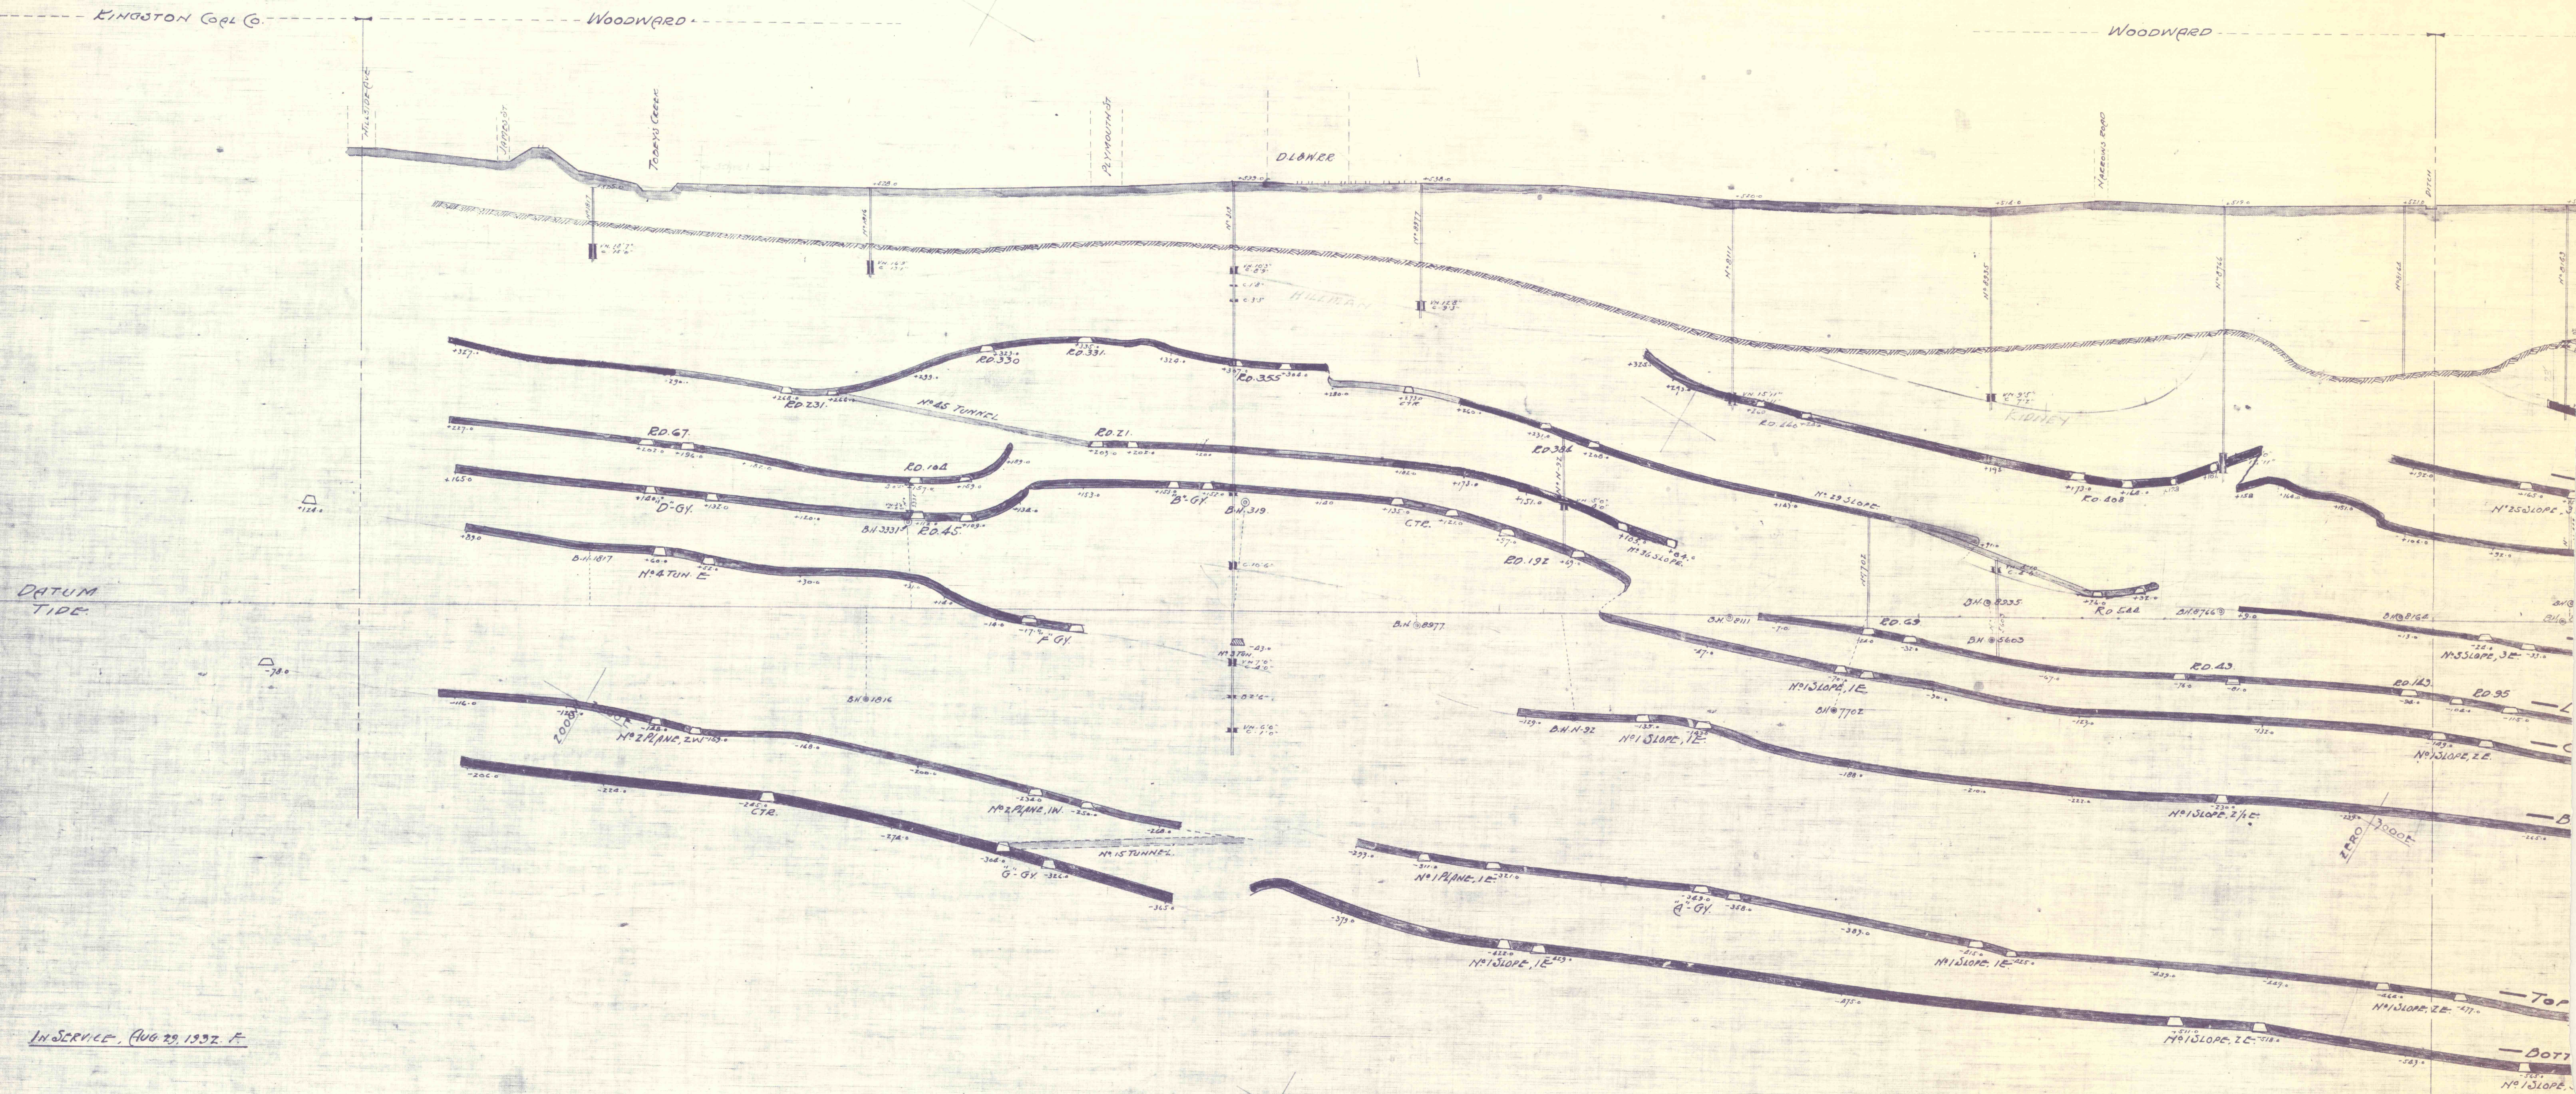

IN SERVICE, AUG 29, 1932, F.

VEIN	DATES POSTED															
SHAKE ISLAND																
ABBOTT	11-4-33 F	7-20-34 F	1-2 X 5	1-12-37 F	5-25-37 F	6-30-38 F	11-7-39 F	2-18-40 F	10-11-42 F	11-18-43 F	10-20-44 F	5-10-45 F	3-27-46 F	5-7-47 F	3-10-56	✓
KIDNEY	11-7-33 F			1-12-37 F	5-25-37 F	7-1-38 F	11-8-39 F	"	10-21-42 F	11-22-43 F	10-23-44 F	5-14-45 F	"	5-26-47 F	10-17-48 F	2-12-58 M
HILLMAN				1-12-37 F	5-25-37 F	7-1-38 F	11-7-39 F	"	"	11-23-43 F	"	"	"	"	"	2-14-58 M
FIVE FOOT	11-9-33 F	7-24-34 F		1-12-37 F	5-25-37 F	7-2-38 F	11-7-39 F	"	10-21-42 F	11-24-43 F	10-27-44 F	5-15-45 F	"	5-27-47 F	"	✓
LANEE	✓	✓	✓	"	"	"	"	"	"	"	"	"	"	"	"	✓
COOPER	✓	✓	✓	"	"	7-2-38 F	11-7-39 F	7-19-40 F	"	11-27-43 F	"	"	"	"	"	✓
DENNETT	✓	✓	✓	"	"	7-2-38 F	11-7-39 F	"	"	"	"	5-16-45 F	"	"	"	✓
BALTIMORE	✓	✓	✓	"	"	7-2-38 F	11-7-39 F	"	"	"	"	"	"	"	"	✓
TOP REDISH	✓	✓	✓	"	"	7-2-38 F	11-7-39 F	"	"	"	"	"	"	"	"	✓
DAY REDISH	✓	✓	✓	"	"	7-2-38 F	11-7-39 F	"	10-22-42 F	"	"	"	"	5-28-47 F	"	✓

ZERO 3000'