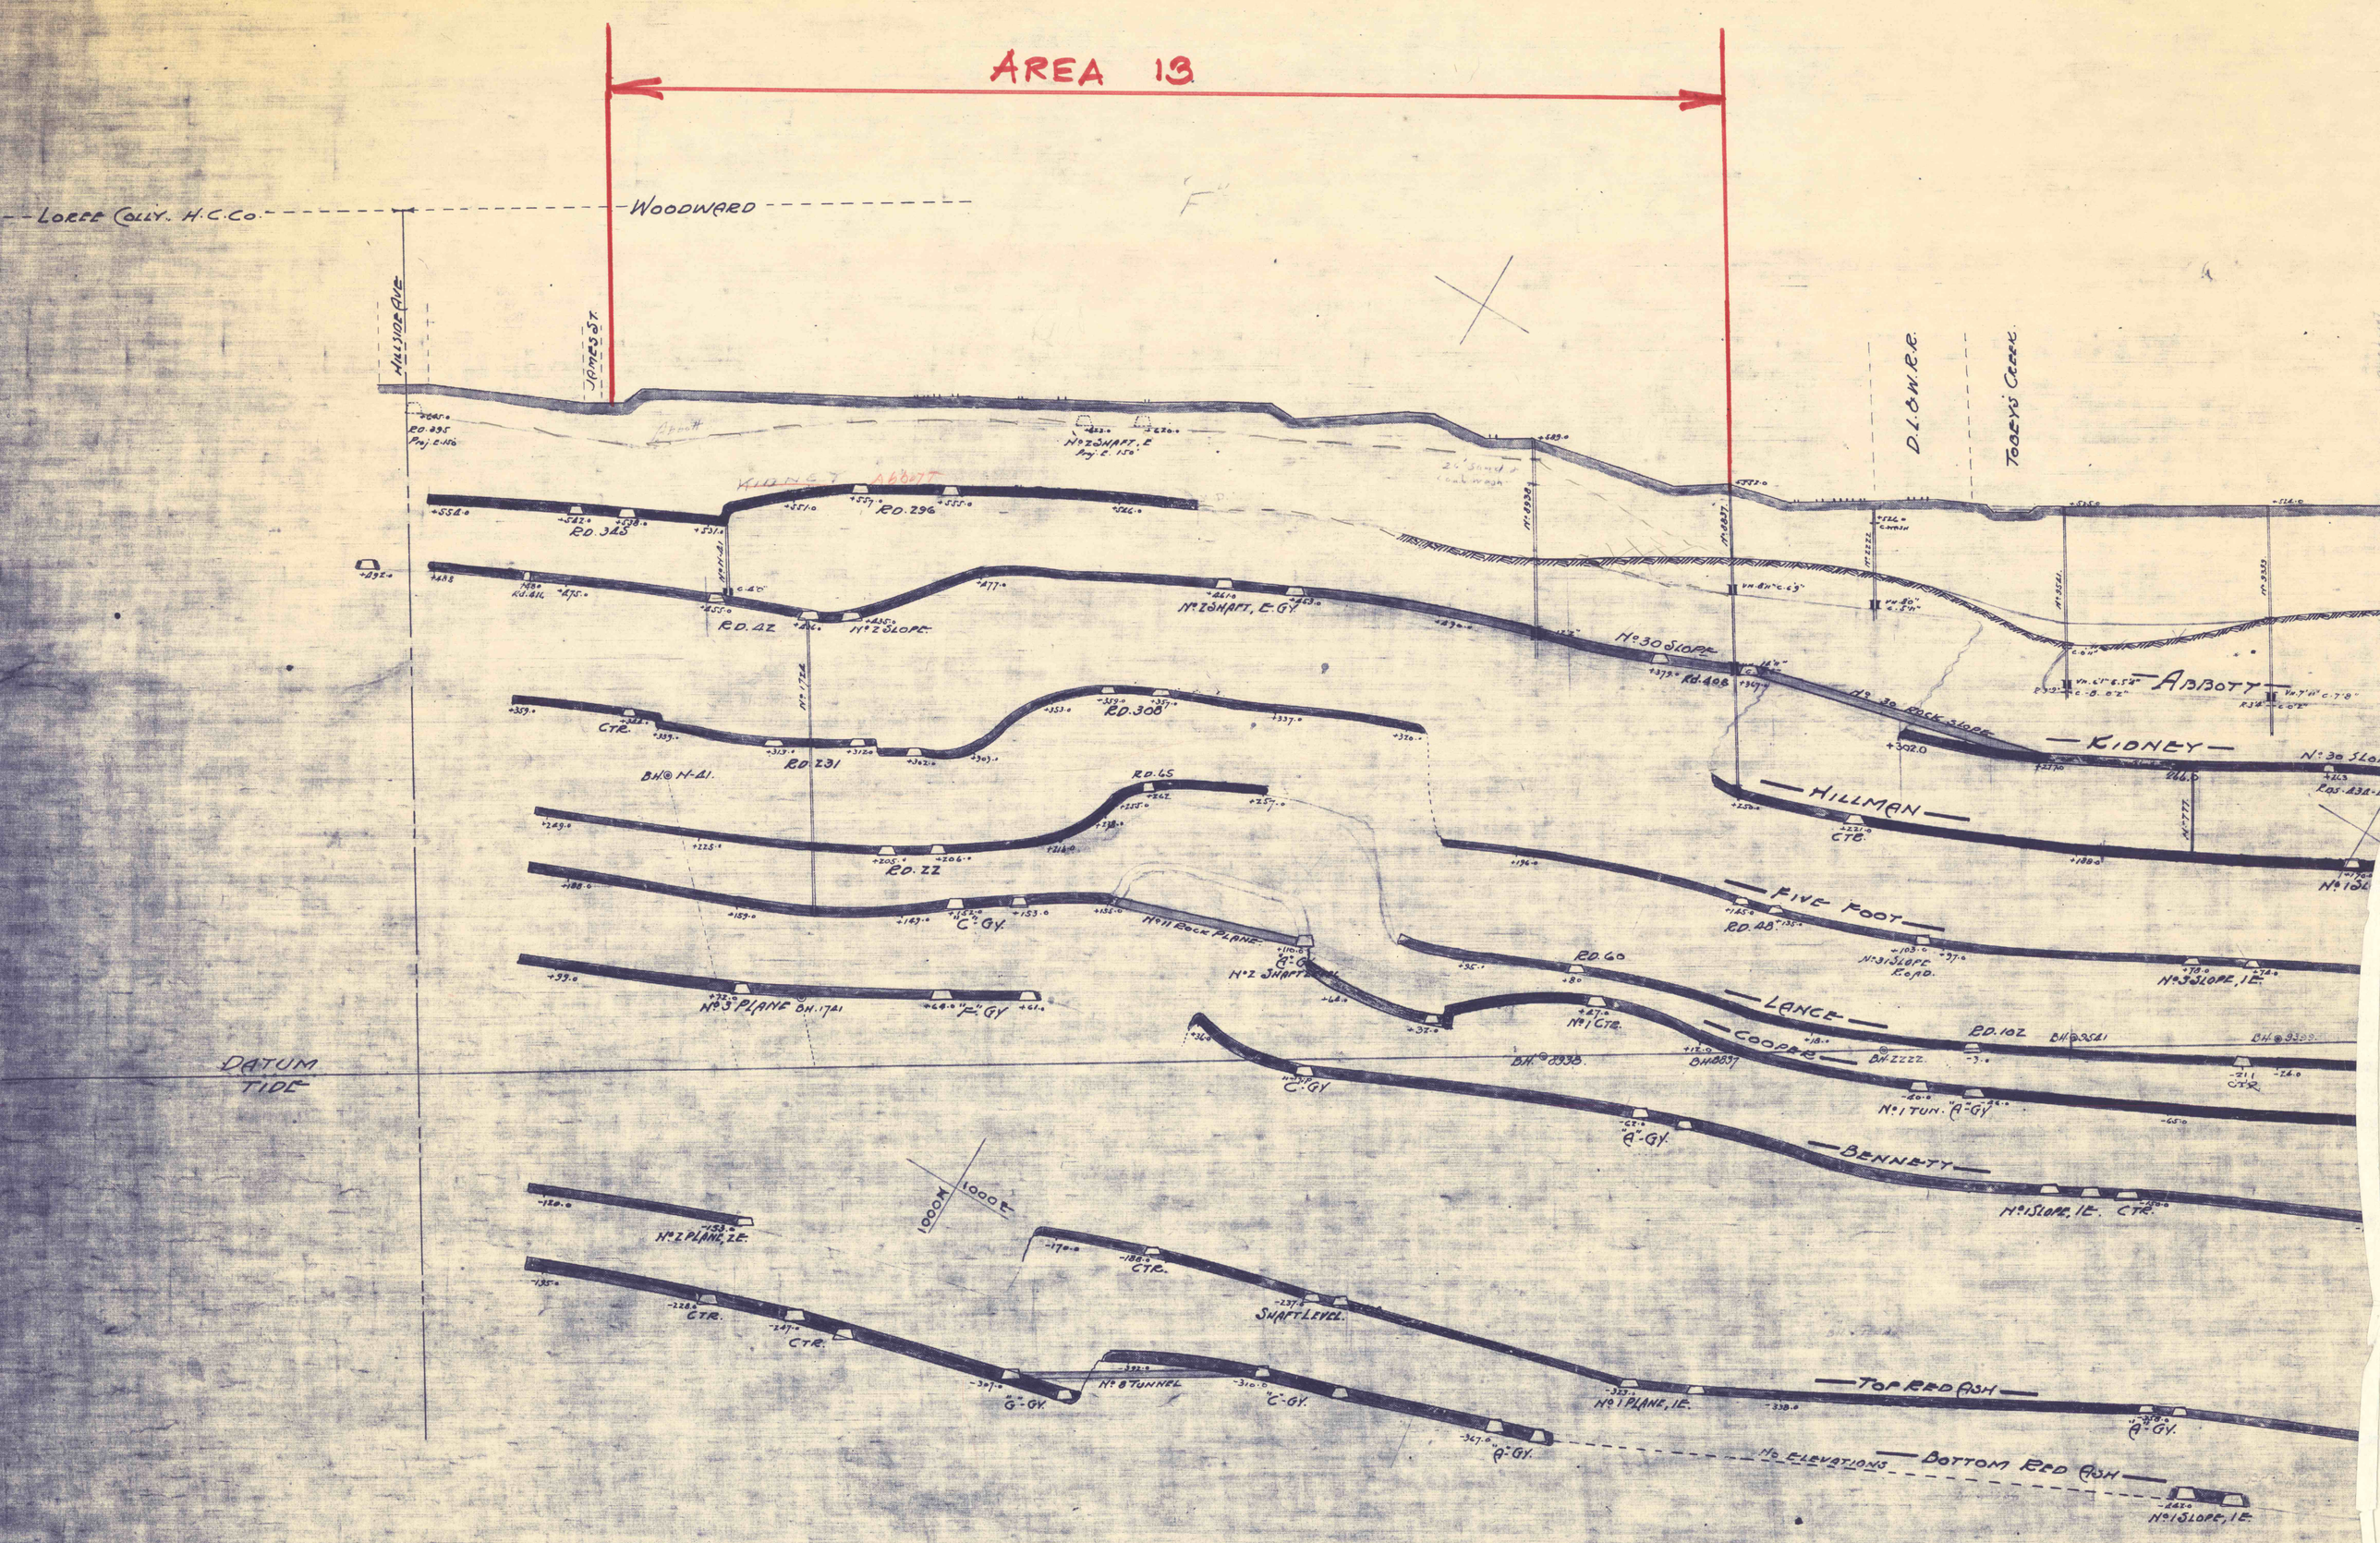

IN SERVICE, AUG. 29, 1932, F.

X SECTION "F"
SCALE 1" = 100'

VEIN	DATES POSTED																		
SNAKE ISLAND																	✓	✓	✓
ABBOTT	11.4.33 F		1-2-36 S	1-12-37 F	5-25-37 F	6-30-38 F	11-7-39 F	7-18-40 F		10-19-42 F	11-18-43 F	10-24-44 D	5-14-45 F	3-27-46 F	5-23-47 F	3-23-49 F	✓	✓	2-13-58 M
KIDNEY	11.7.33 F	7.21.34 F	✓	1-12-37 F	5-25-37 F	7-1-38 F	11-8-39 F	"		10-20-42 F	11-22-43 F	10-20-44 D	"	"	5-26-47 F	"	10.17.50 F	3-12-56 M	2-13-58 M
HILLMAN	✓	7.23.24 F	✓	1-12-37 F	5-25-37 F	7-1-38 F	11-9-39 F	"		"	11-23-43 F	10-25-44 D	"	"	"	"	10.17.50 F	✓	2-14-58 M
FIVE FOOT	✓		✓	1-13-37 F	5-26-37 F	7-2-38 F	11-9-39 F	"		10-21-42 F	11-24-43 F	10-27-44 D	5-15-45 F	"	5-27-47 F	3-24-49 F	10.18.50 F	✓	✓
LANCE	✓		✓	"	5-26-37 F	7-2-38 F	11-9-39 F	"		"	11-24-43 F	10-30-44 D	"	4-25-46 F	5-28-47		"	3-12-56 M	✓
COOPER	✓		✓	"	"	7-5-38 F	11-9-39 F	7-19-40 F		"	11-27-43 F	"	"	"	"		✓	✓	2-14-58 M
BENNETT	✓		✓	"	"	7-5-38 F	11-10-39 F	"		"	"	"	5-16-45 F	"	"	"	✓	✓	✓
BALTIMORE	✓		✓	"	"	7-5-38 F	11-10-39 F	"		"	"	"	"	"	"	"	✓	✓	✓
TOP RED ASH	✓		✓	"	"	7-5-38 F	11-10-39 F	"		"	"	10-31-44 D	"	"	"	3-25-49 F	✓	✓	✓
BOT. RED ASH	✓		✓	"	"	✓	11-10-39 F	"		10-22-42 F	"	"	"	"	"	"	✓	✓	✓

ZERO 1000E

1000N ZERO