


HUDSON COAL CO.

NORTHWEST COAL CO
RAYMOND COLLY
-SURFACE MAP-
SCALE 1"=400'

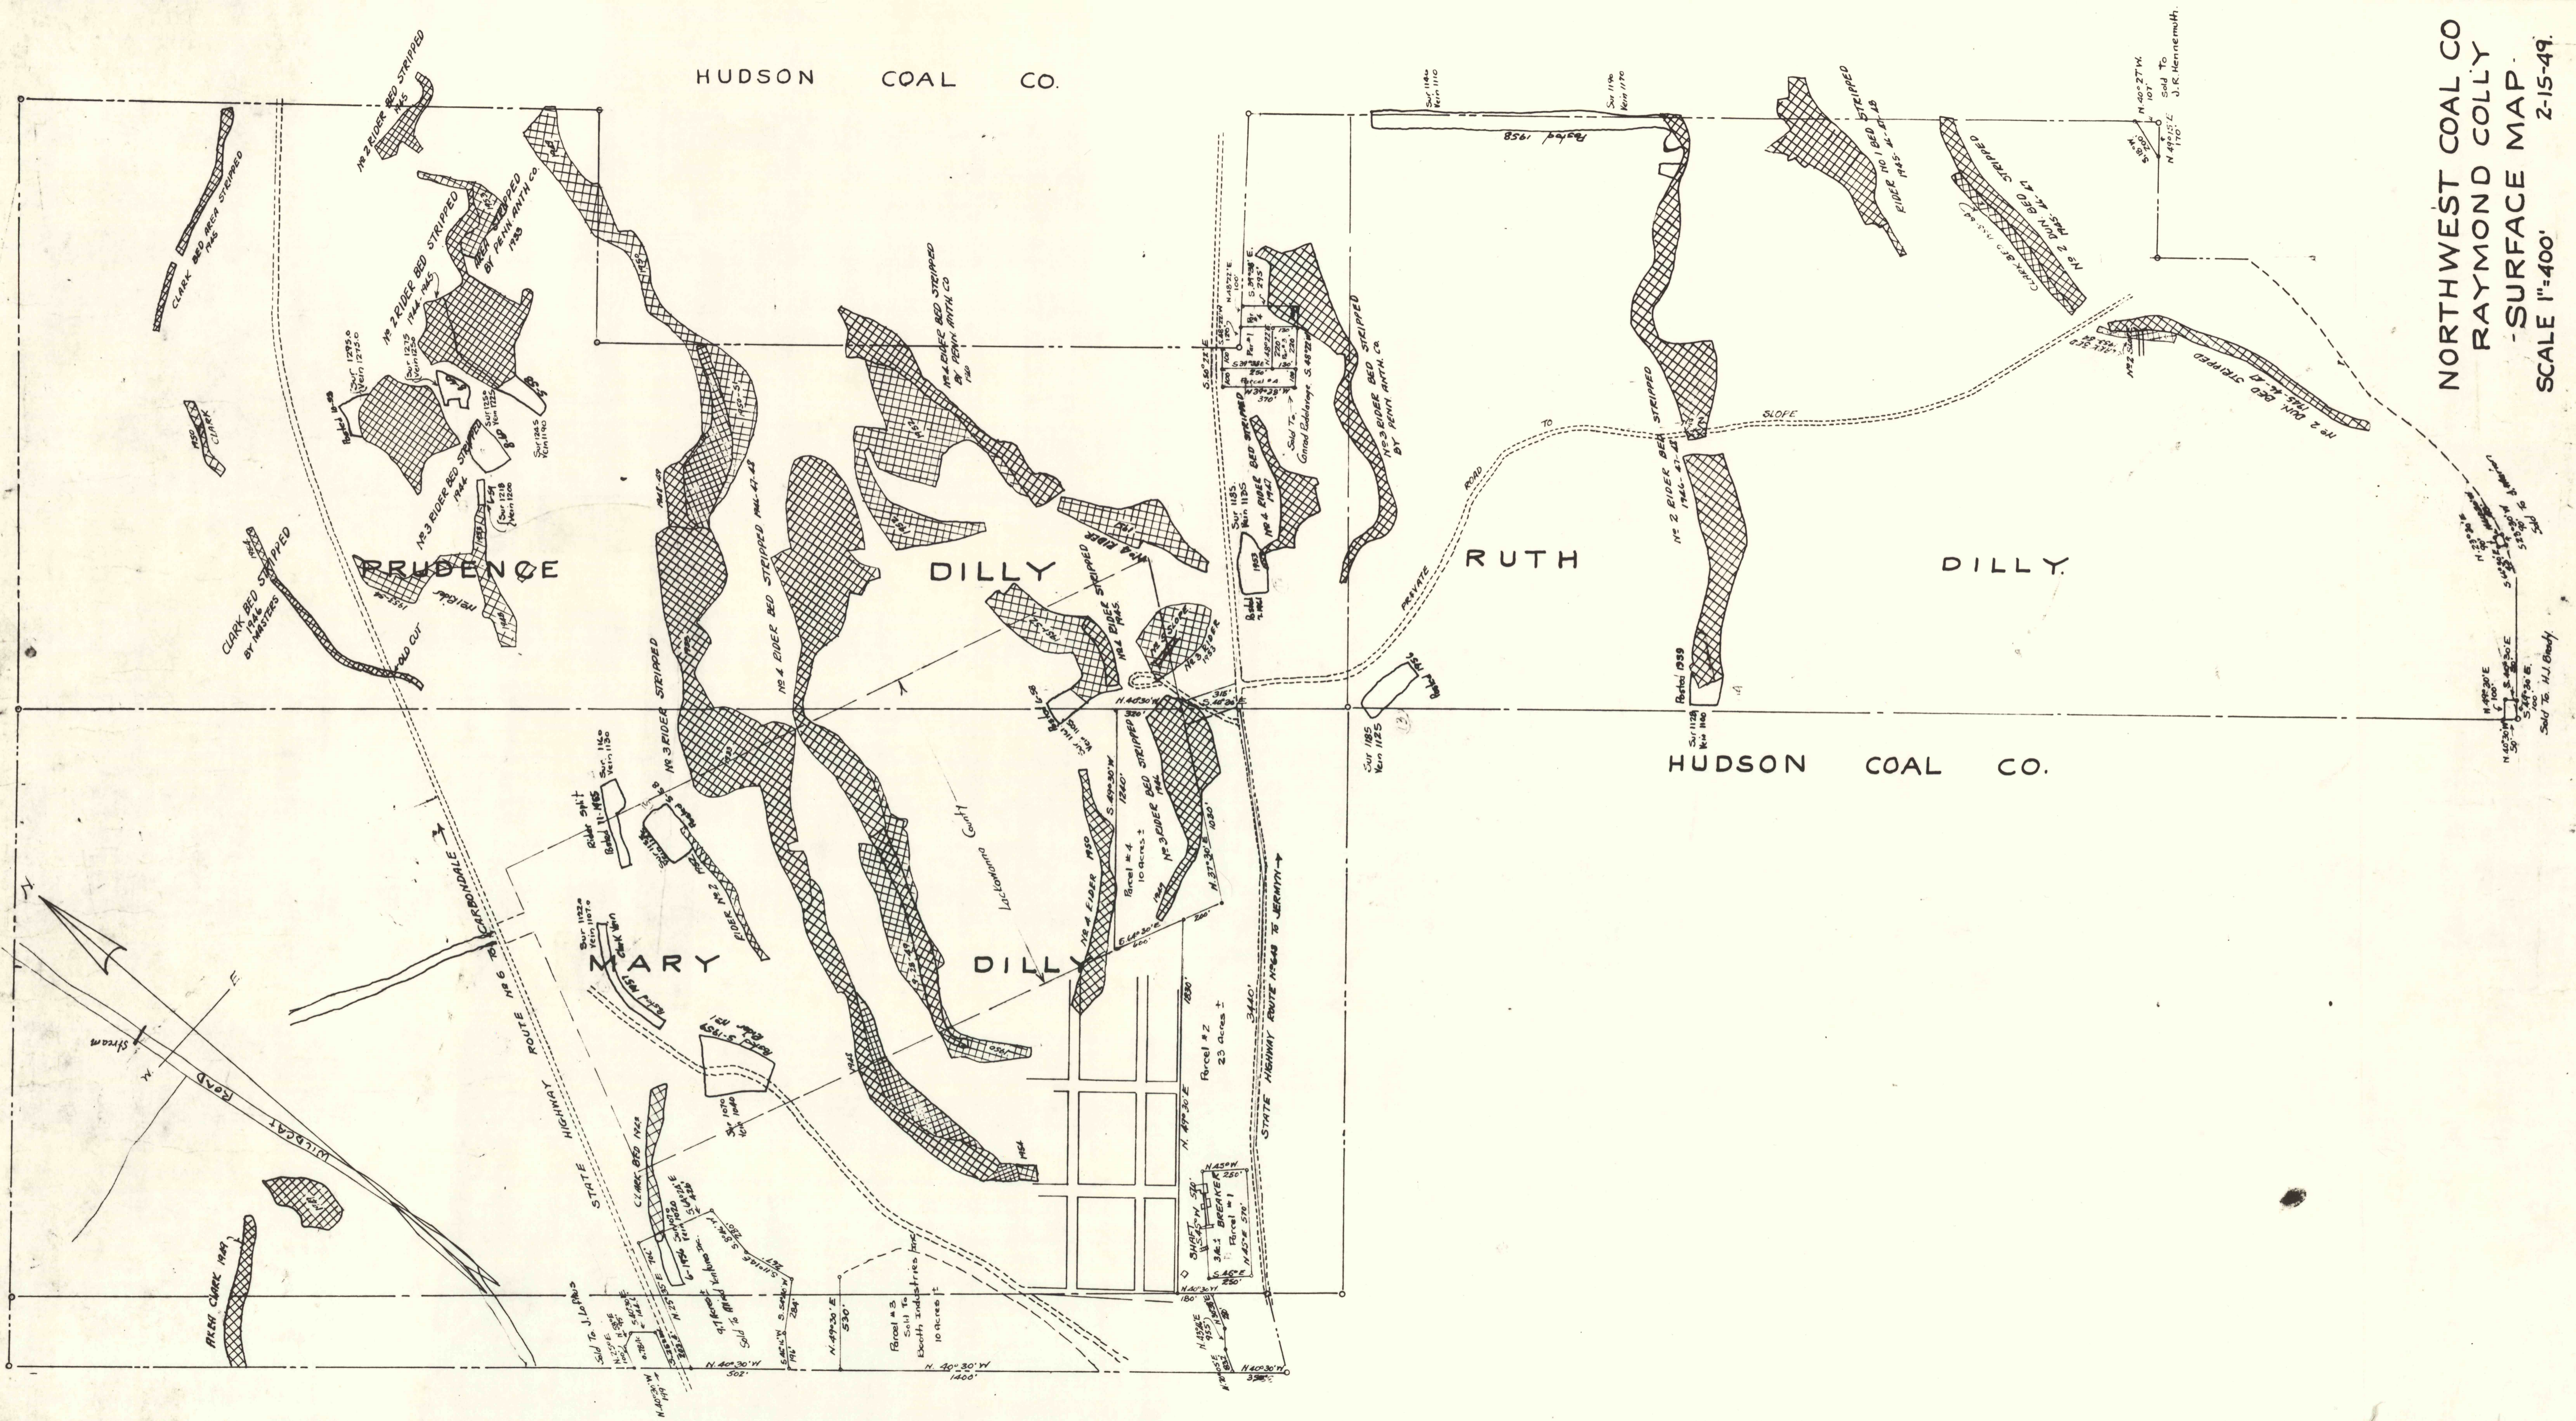

PRUDENCE

DILLY


RUTH

DILLY

HUDSON COAL CO.

MARY

DILLY

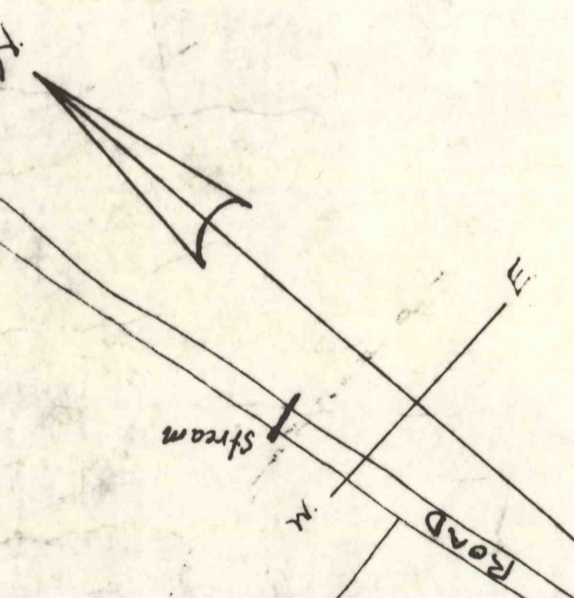

Stream

WILDCAT ROAD

ARKEN CLARK M&A

STATE HIGHWAY ROUTE No 6

STATE HIGHWAY ROUTE No 6

