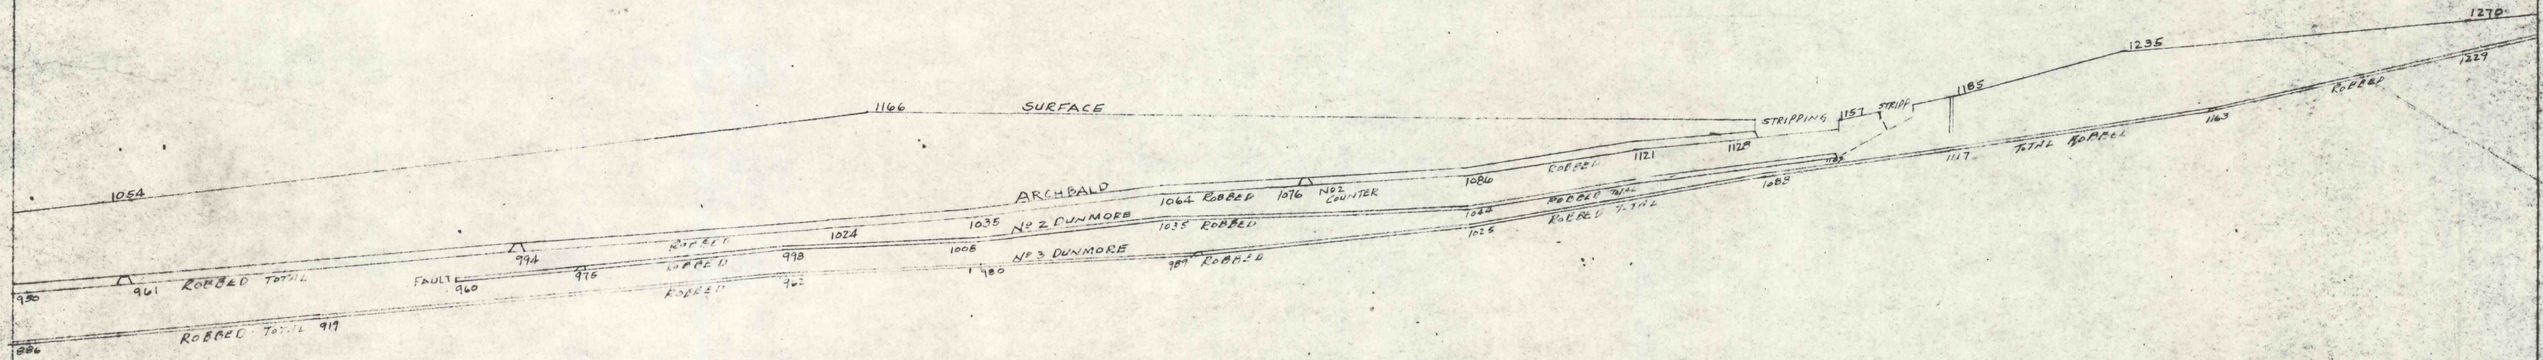

CROSS SECTION FOLIO 11 W
LOOKING UP STREAM
SCALE 1"=100 0 100 200