


Date	By Whom	Date	By Whom
2-11-42	J.R.W.		
12-42	C.W.	12-43	C.W.
12-44	J.B.	12-44	J.B.
12-45	P.L.	12-45	P.L.
12-46	P.L.	12-47	P.L.
12-48	P.L.		
2-49	R.P.	2-50	R.P.
2-51	R.P.		

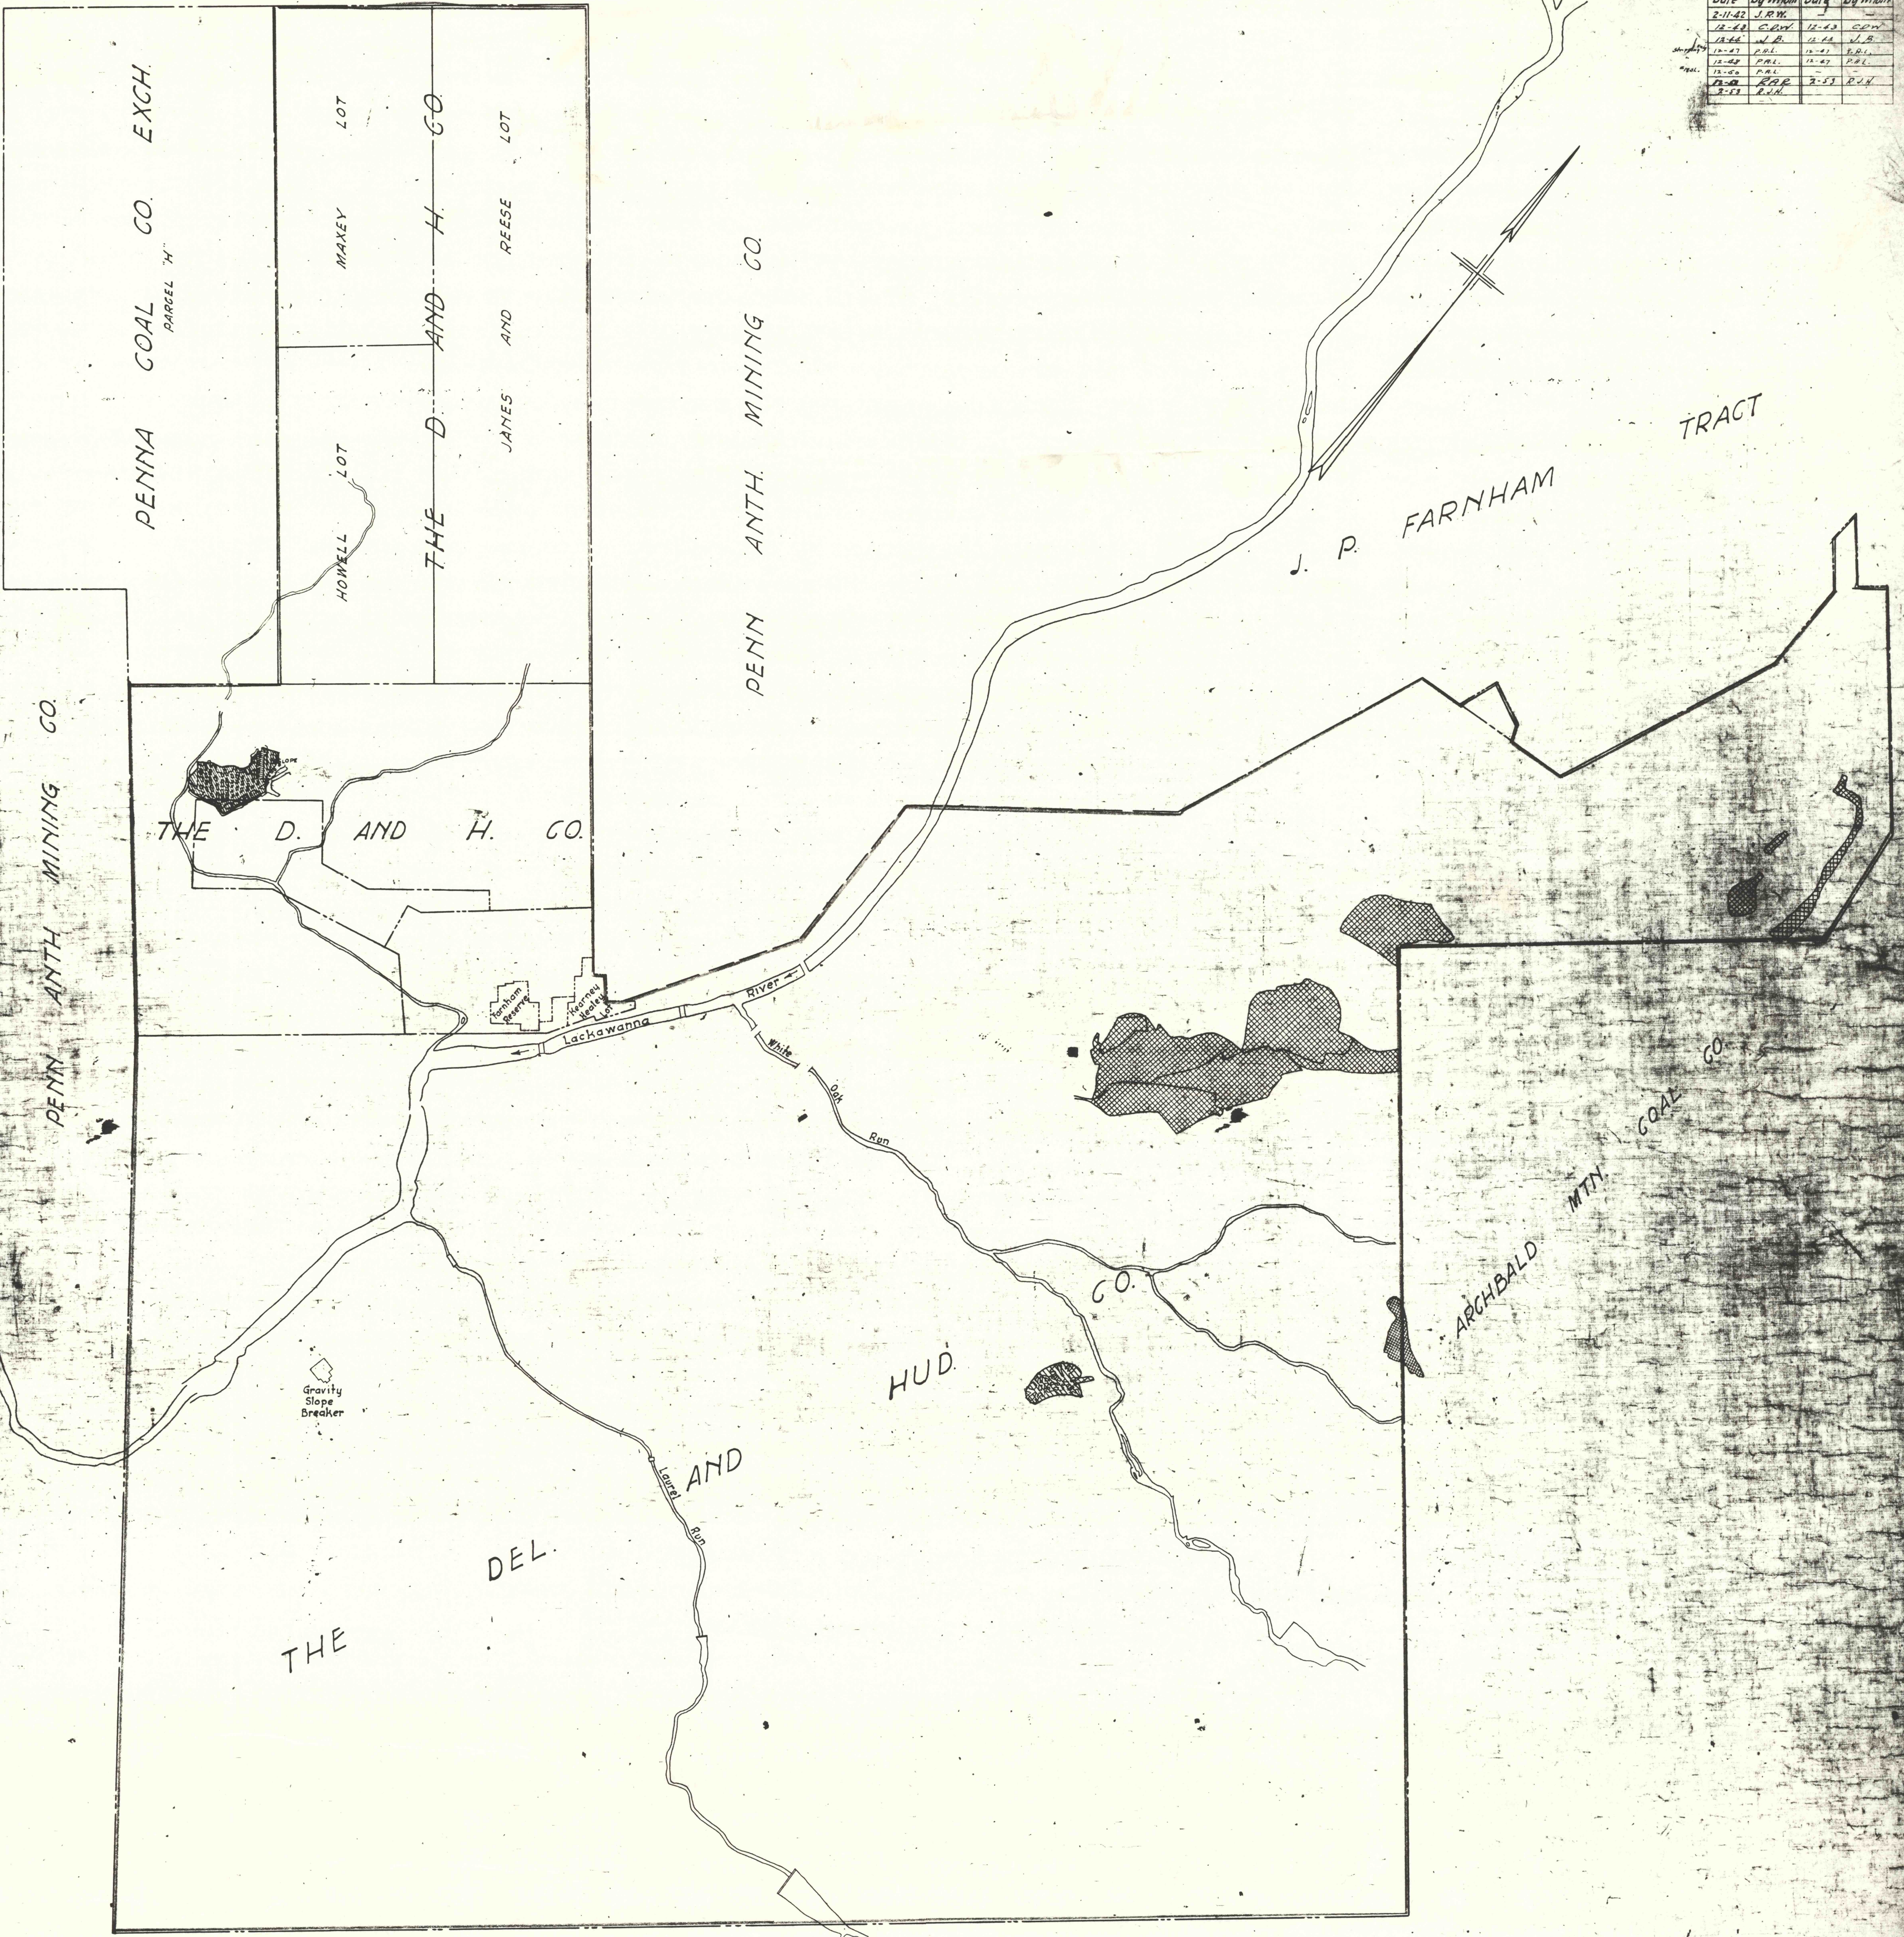

THE HUMBERT COAL CO.

THE HUDSON COAL CO.
 MAP OF THE
 GRASSY BED
 AT
 GRAVITY SLOPE COLLIERY
 Scale: 1"=400'