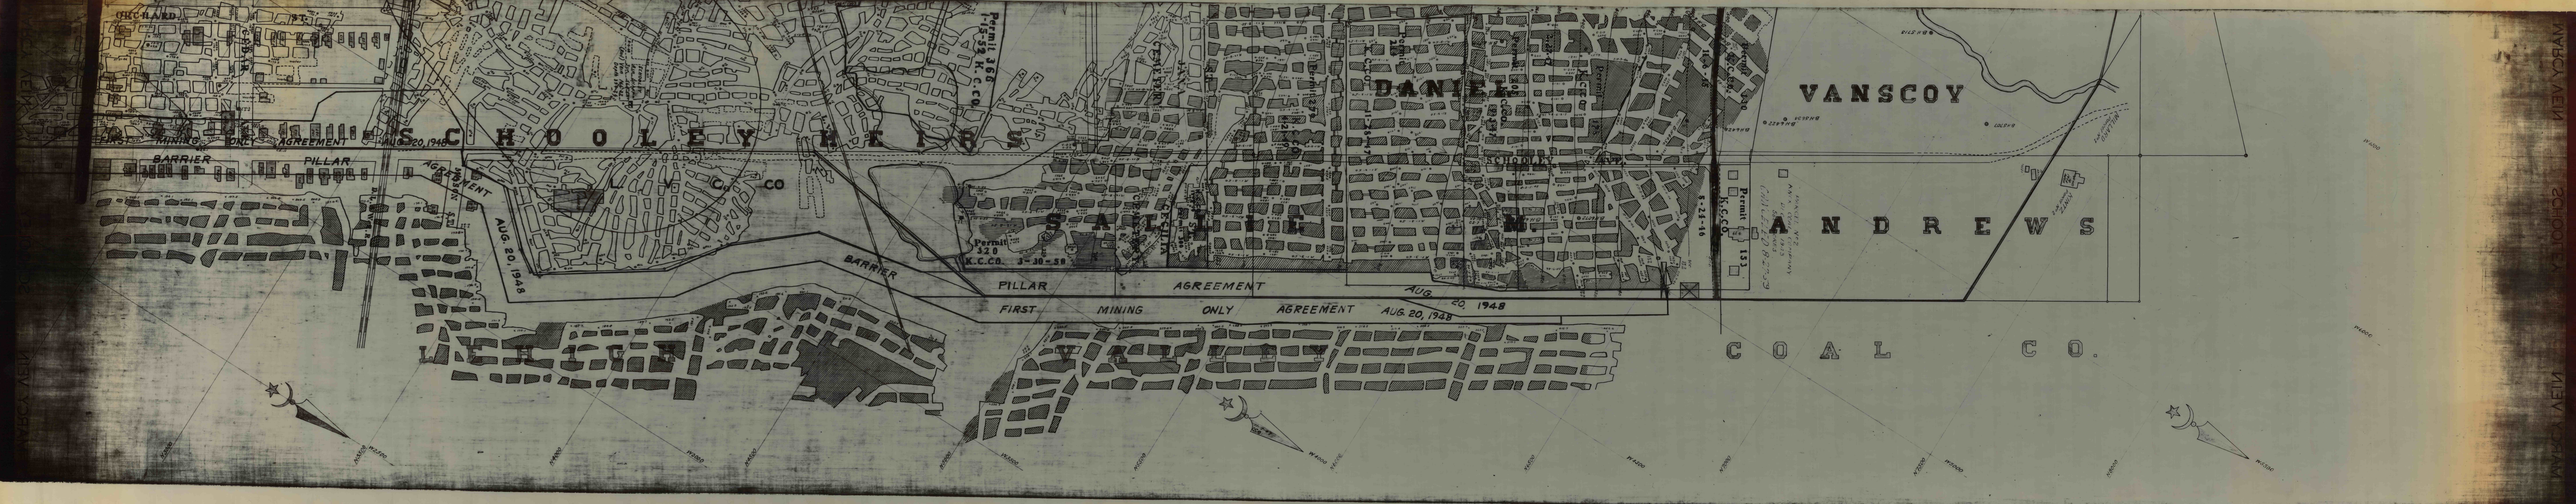

SCHOOLEY HEIRS
DANIEL
VANSCOY
ANDREWS
COAL CO.
SALLIE M.
BARRIER PILLAR AGREEMENT AUG. 20, 1948
FIRST MINING ONLY AGREEMENT AUG. 20, 1948
Permit 366 1-15-52 K.C.CO.
Permit 320 K.C.CO. 3-30-58
Permit 153 K.C.CO.