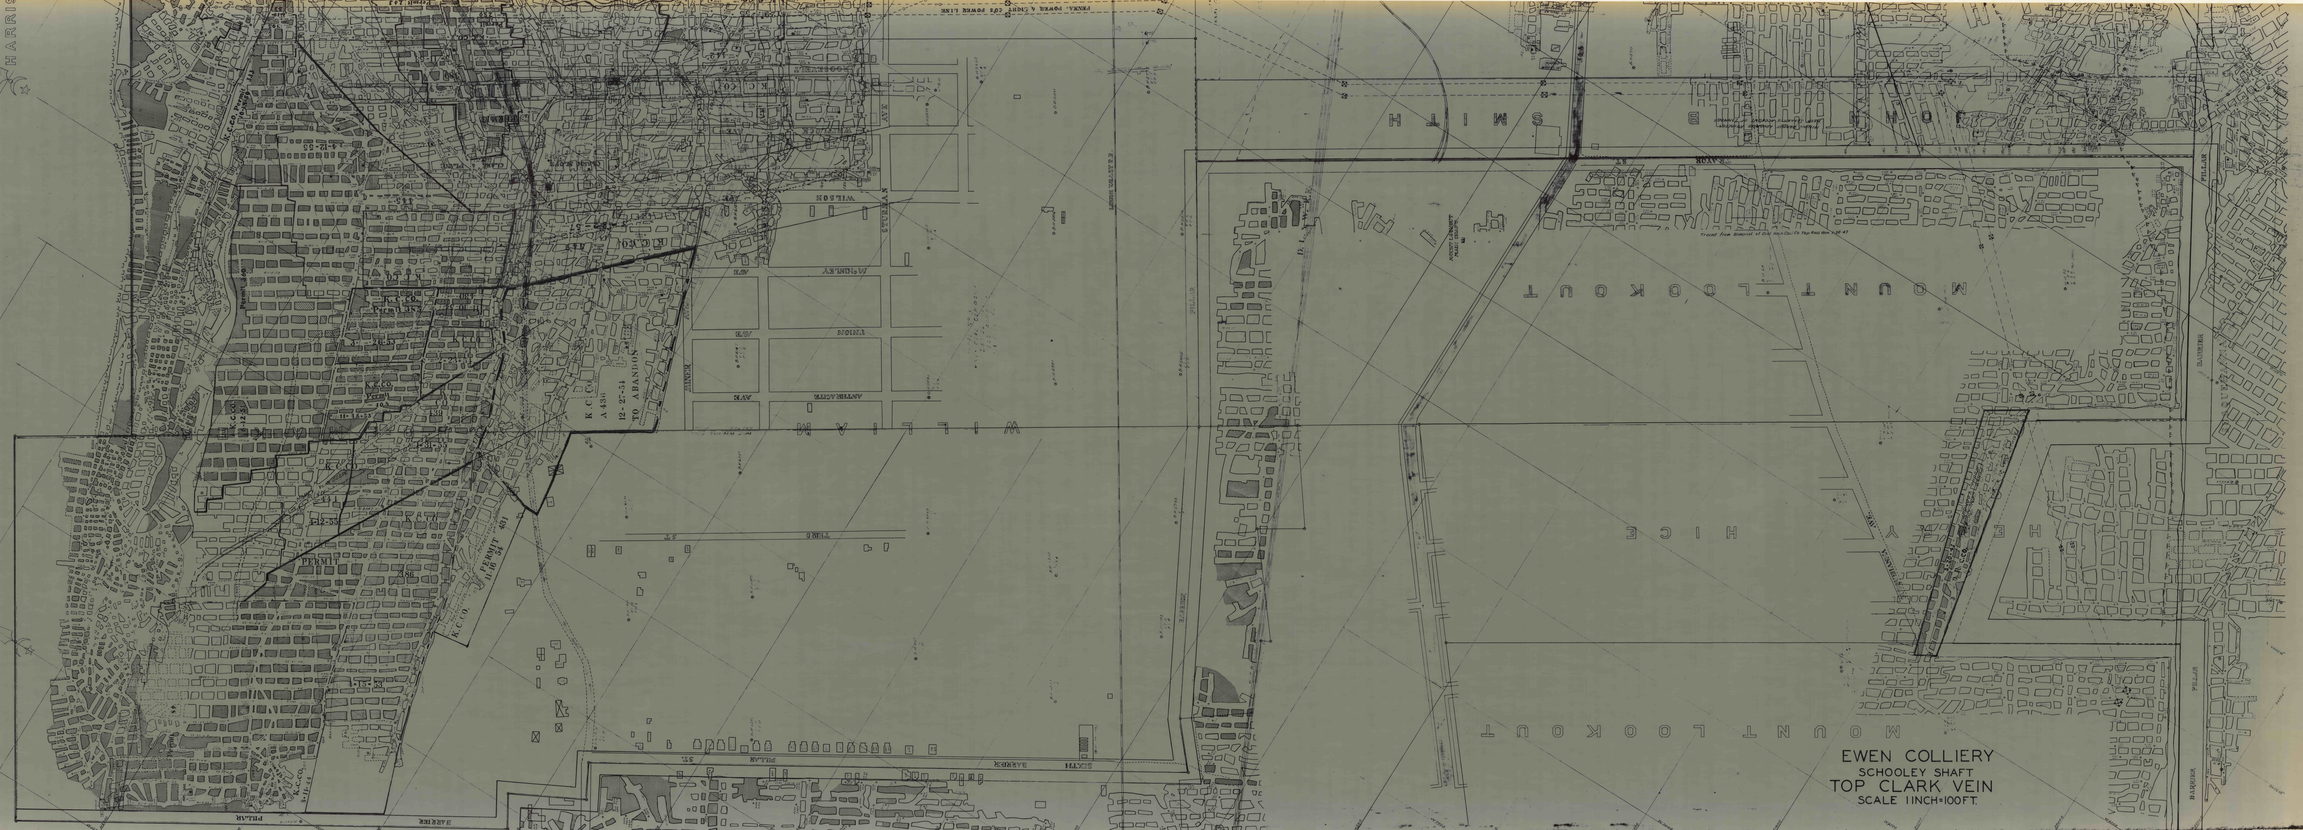
EWEN COLLIERY
SCHOOLEY SHAFT
TOP CLARK VEIN
SCALE 1 INCH = 100 FT.
MOUNT LOOKOUT
HIGH
WILLIAM
SMITH
WILSON
PILLAR
BARRIER
SOUTH BARRIER
PILLAR ST.
TO ABANDON
12-25-51
K.C.C.
A.R.M.
PERMIT
HARRIS