


KINTZ DRIFT TOP SPLIT OF RED ASH VEIN.

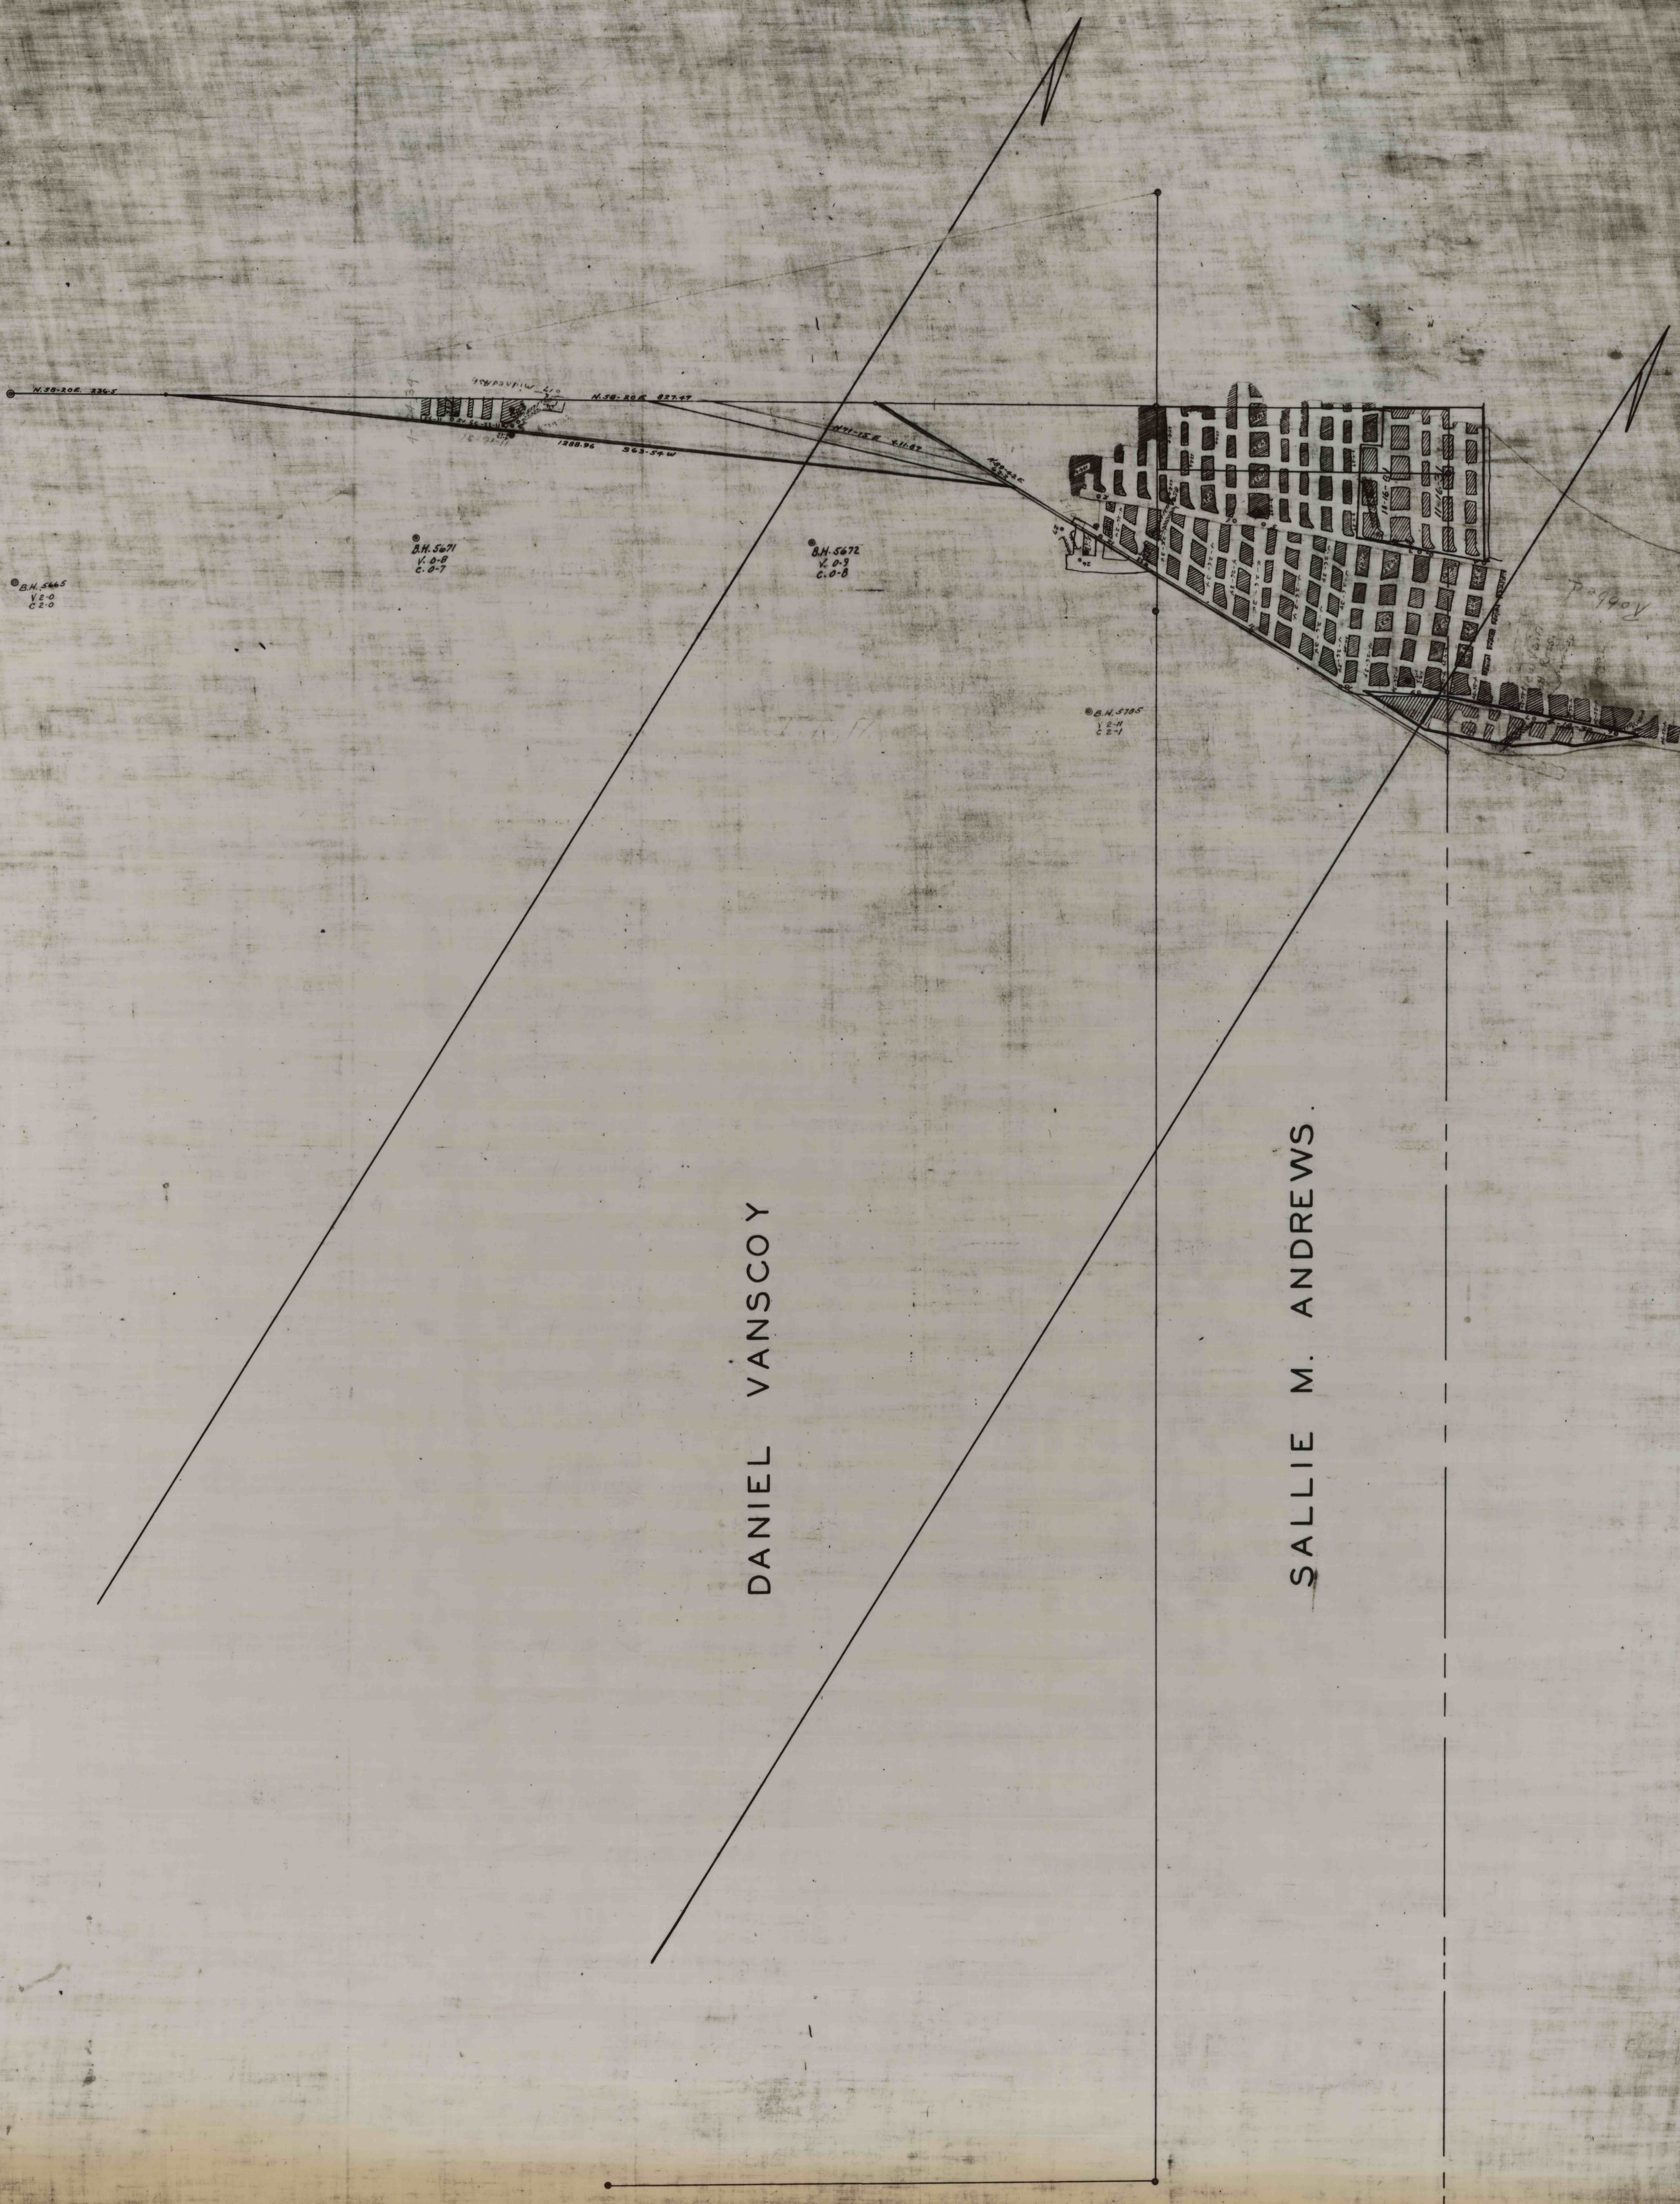

DANIEL VANSKOY

SALLIE M. ANDREWS