


WILLIAM

SHOEMAKER

DANIEL VANSCOY

SALLIE M. ANDREWS

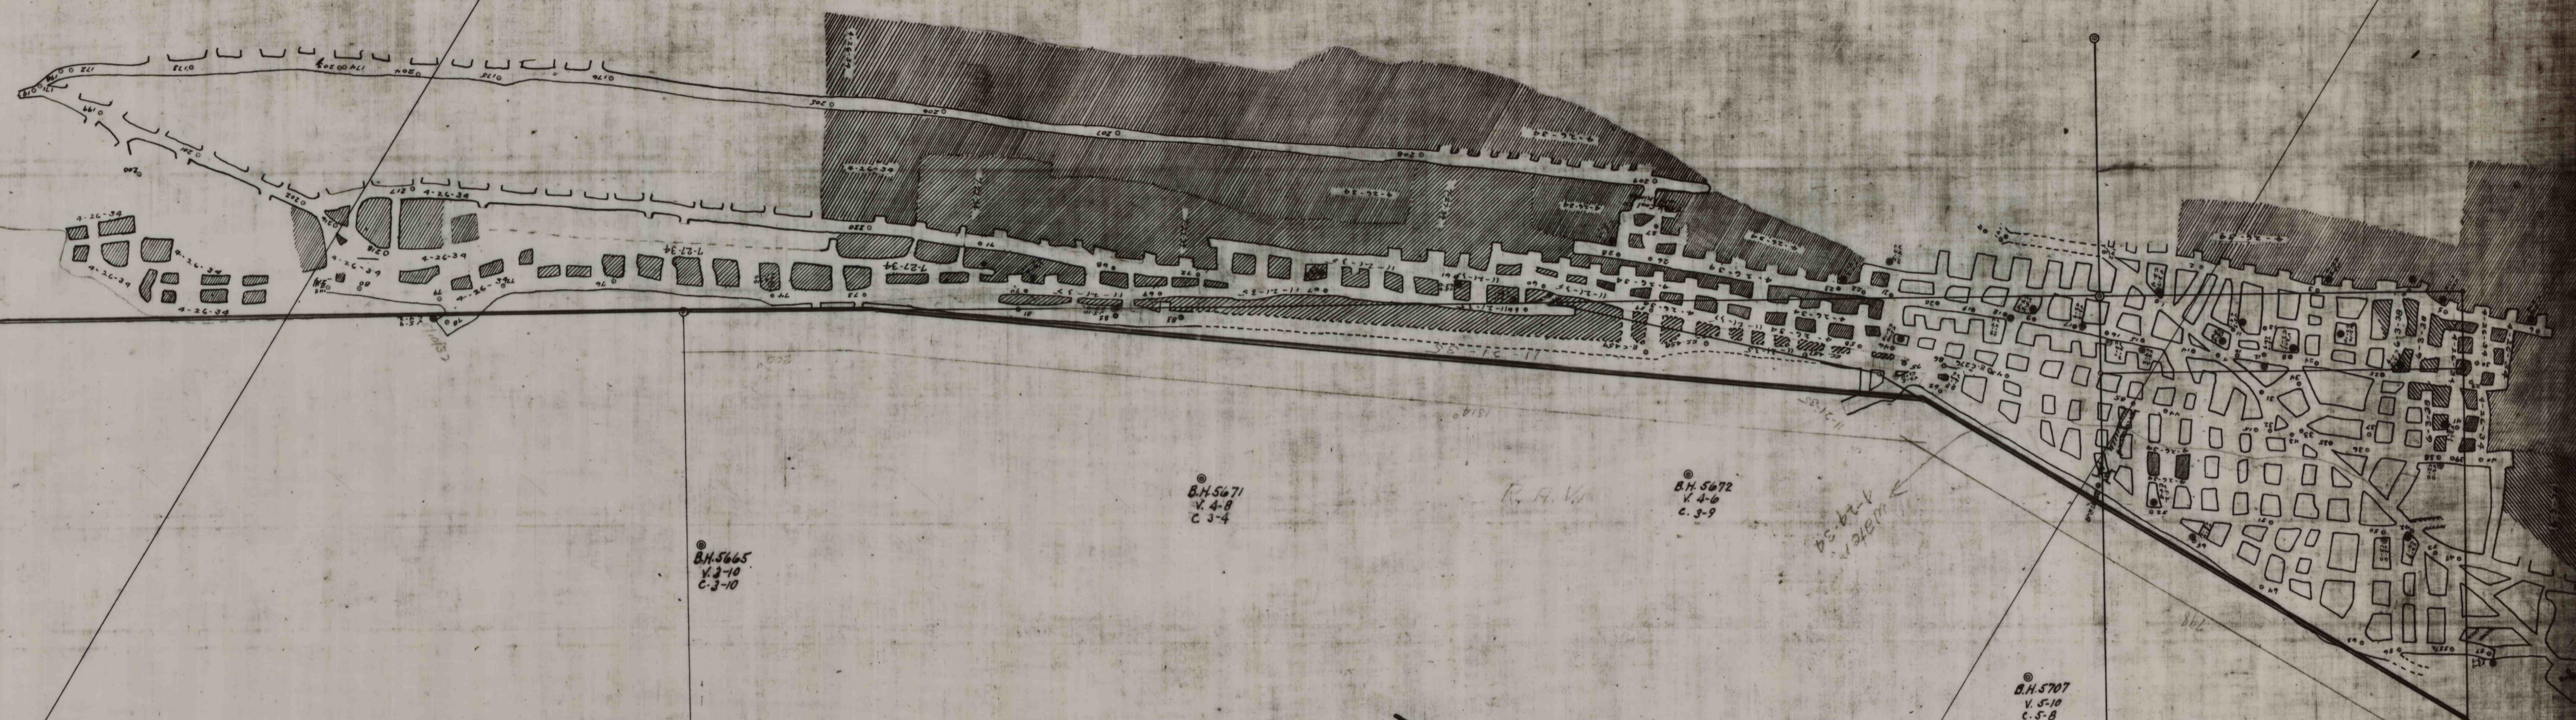

B.H. 5665  
V. 3-10  
C. 3-10

B.H. 5671  
V. 4-8  
C. 3-4

B.H. 5672  
V. 4-8  
C. 3-9

B.H. 5707  
V. 5-10  
C. 5-8

R. H. W.

PS. 124  
V. 125m