


SCHOOLLEY — RED A2H VEIN

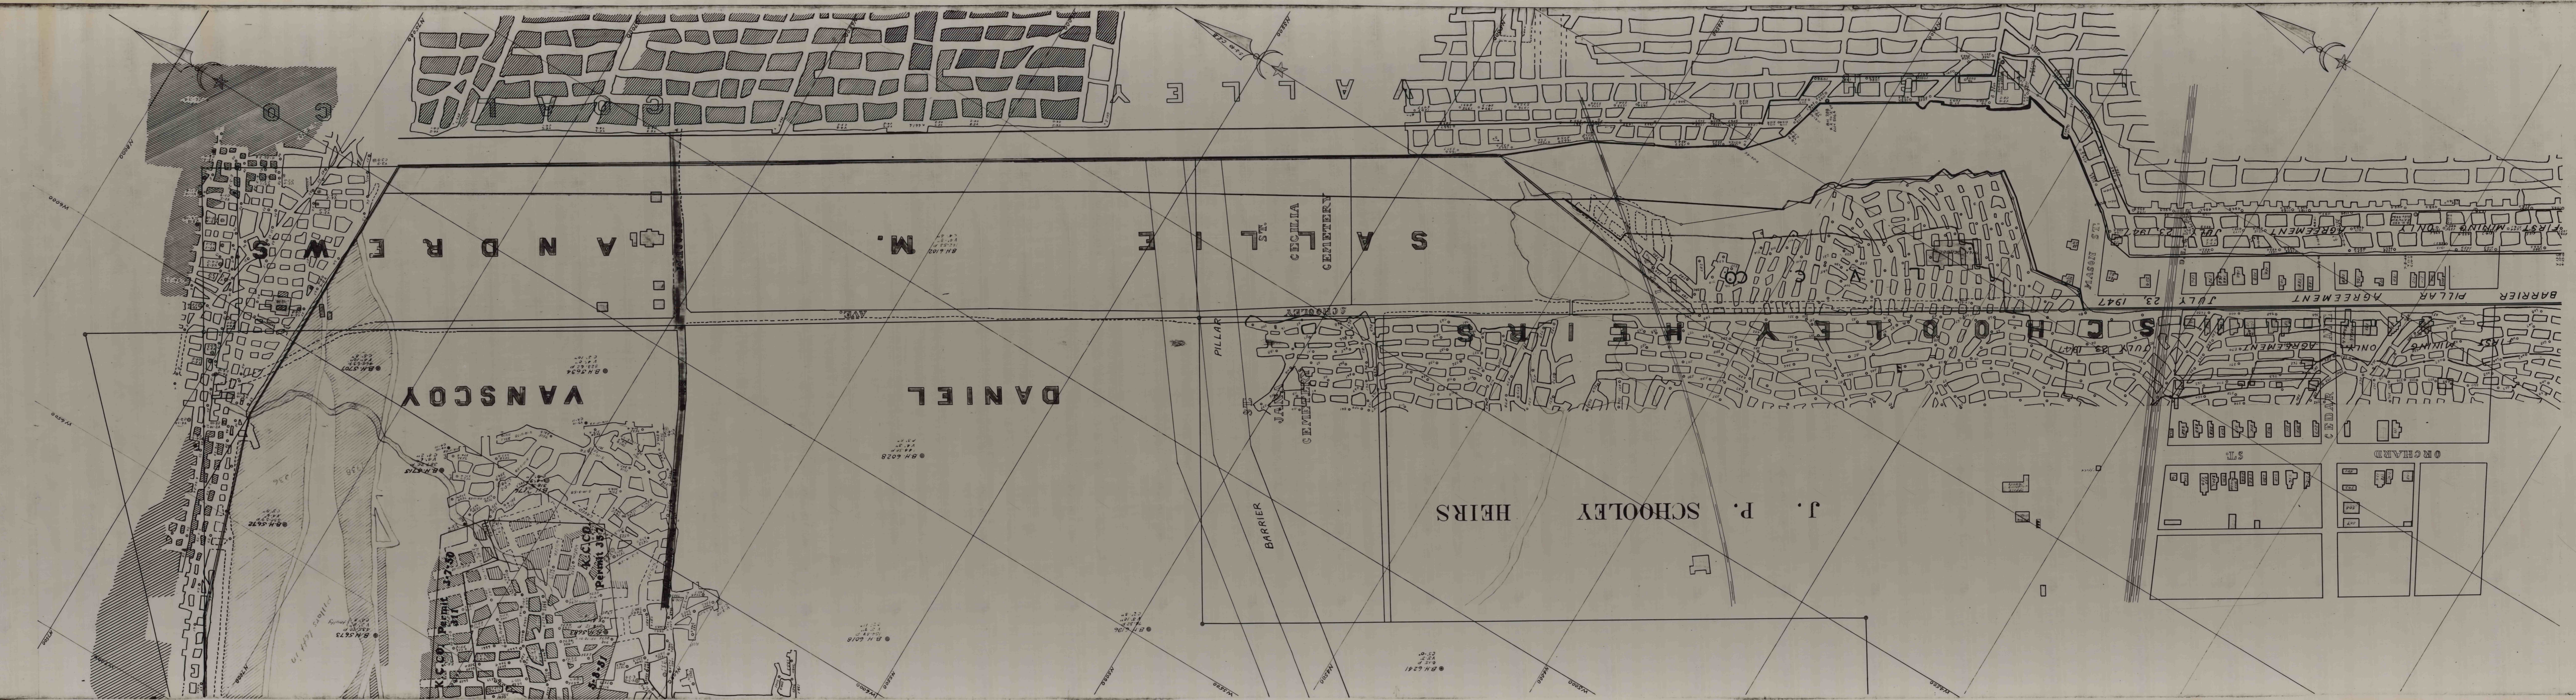

SCHOOLLEY — RED A2H VEIN