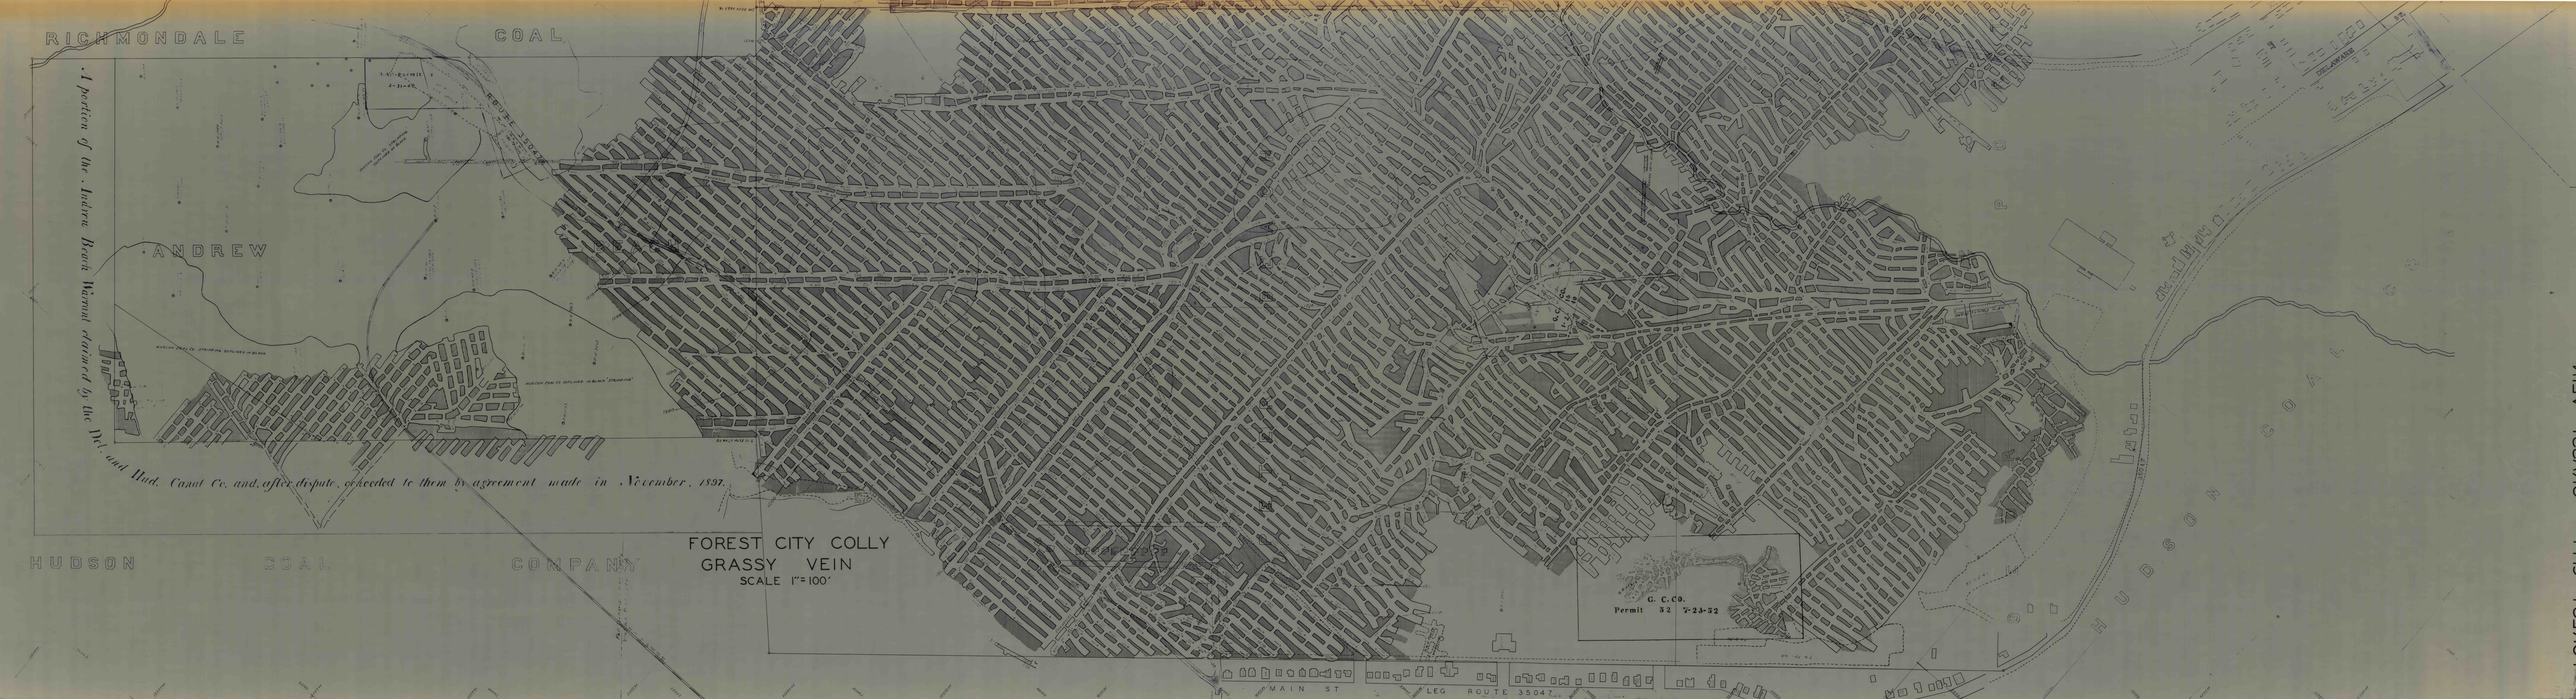
RICHMONDALE
COAL
ANDREW
HUDSON
COAL
COMPANY
A portion of the Andrew Brook Warrant claimed by the Del. and Hud. Canal Co. and, after dispute, conceded to them by agreement made in November, 1897.
FOREST CITY COLLY
GRASSY VEIN
SCALE 1" = 100'
G. C. CO.
Permit 52 7-23-52
MAIN ST
LEG ROUTE 35047
HUDSON COAL CO.