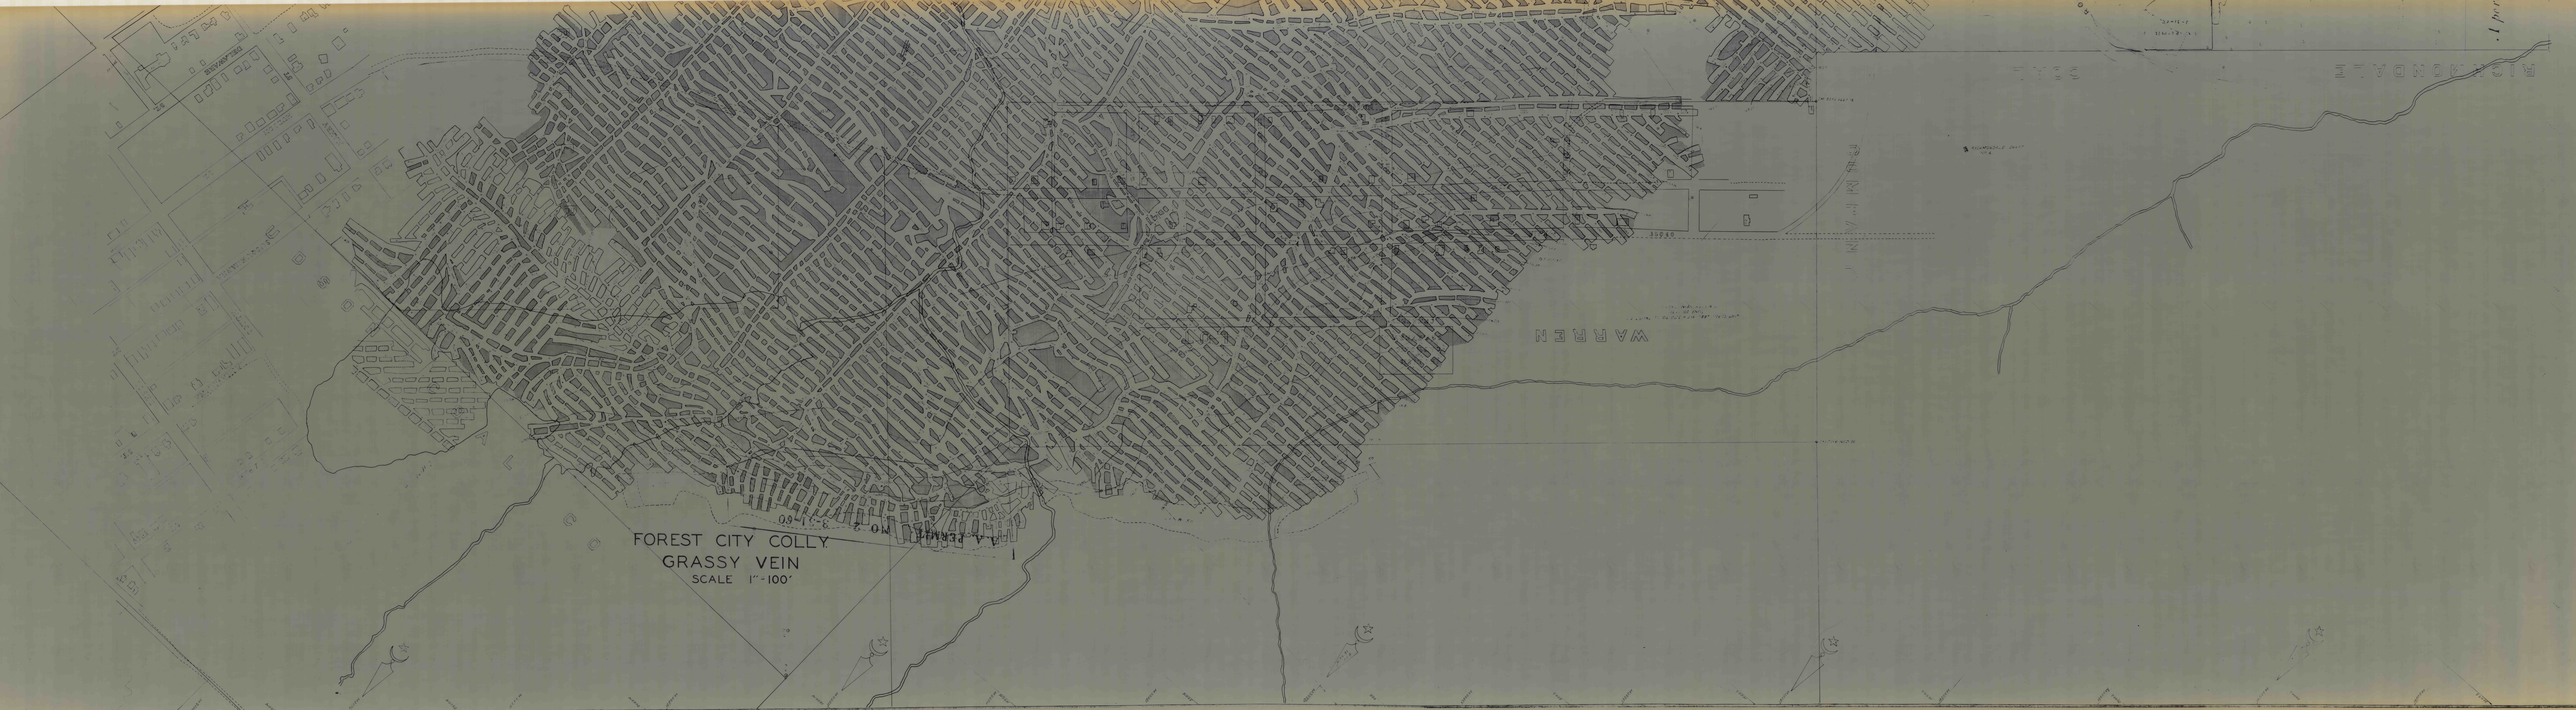
FOREST CITY COLLY.
GRASSY VEIN
SCALE 1" = 100'
WARREN