SANTO VOLPE PERMIT 53
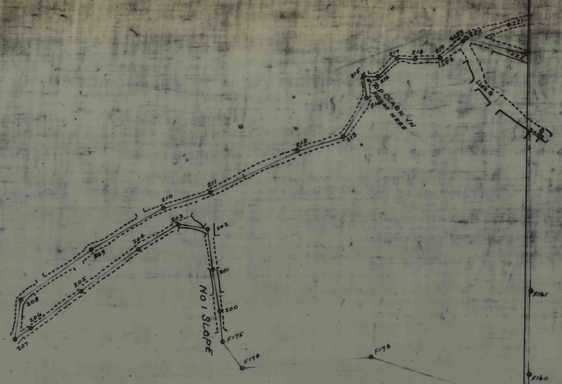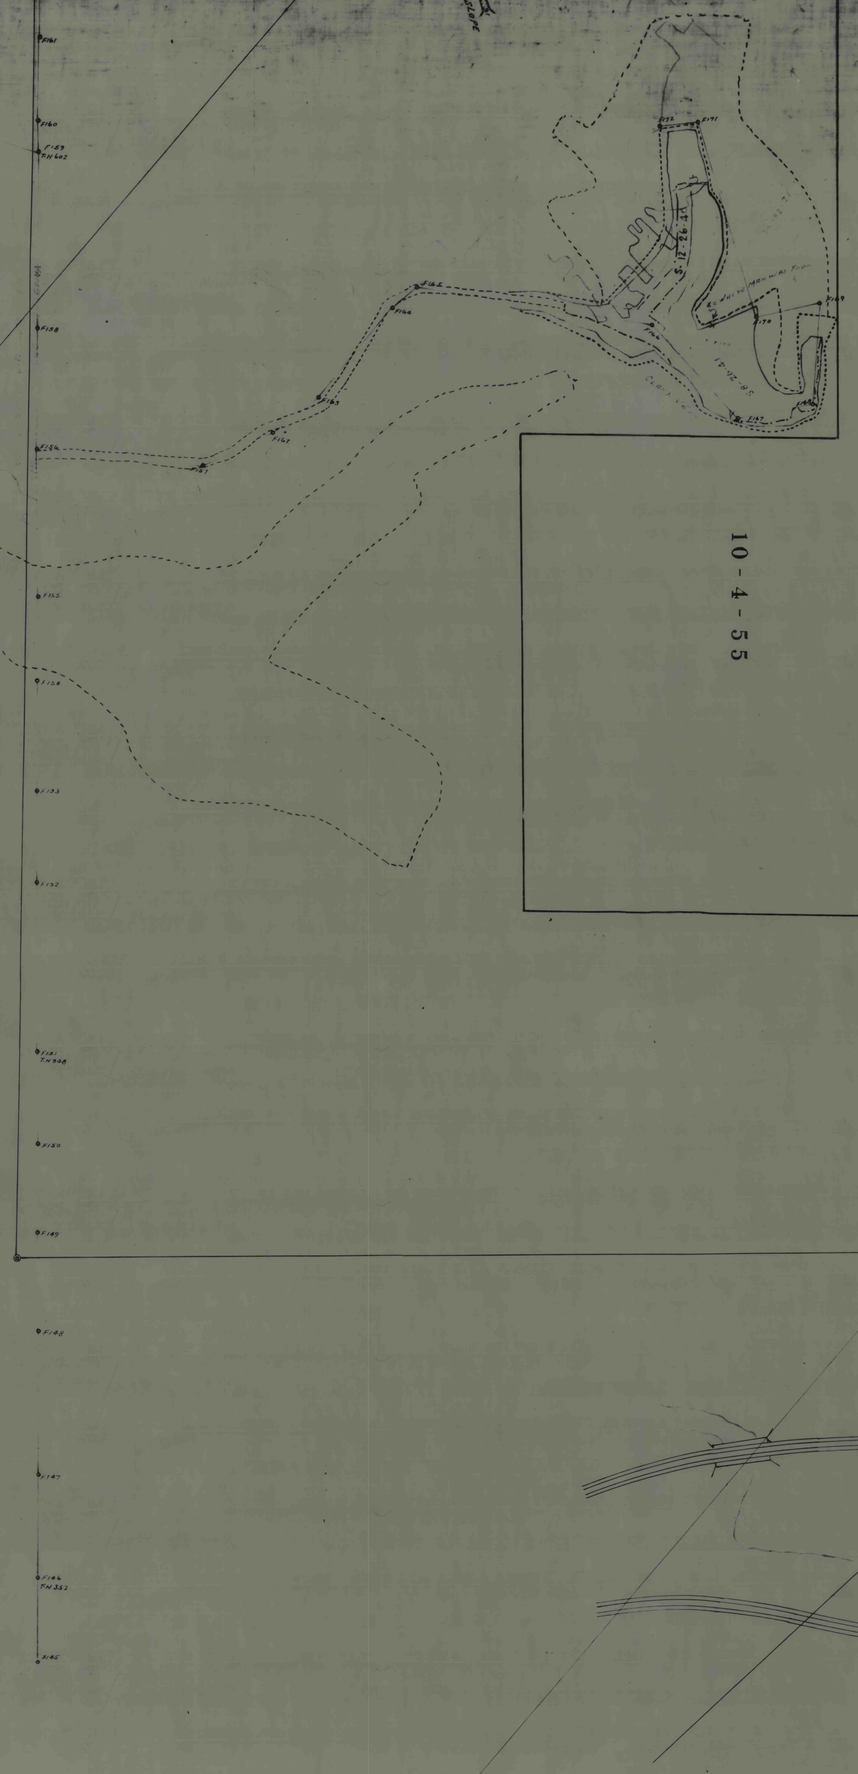
10 - 4 - 55