BOTTOM SPLIT

CLARK VEIN

FOREST CITY No. 2 SHAFT

1910.

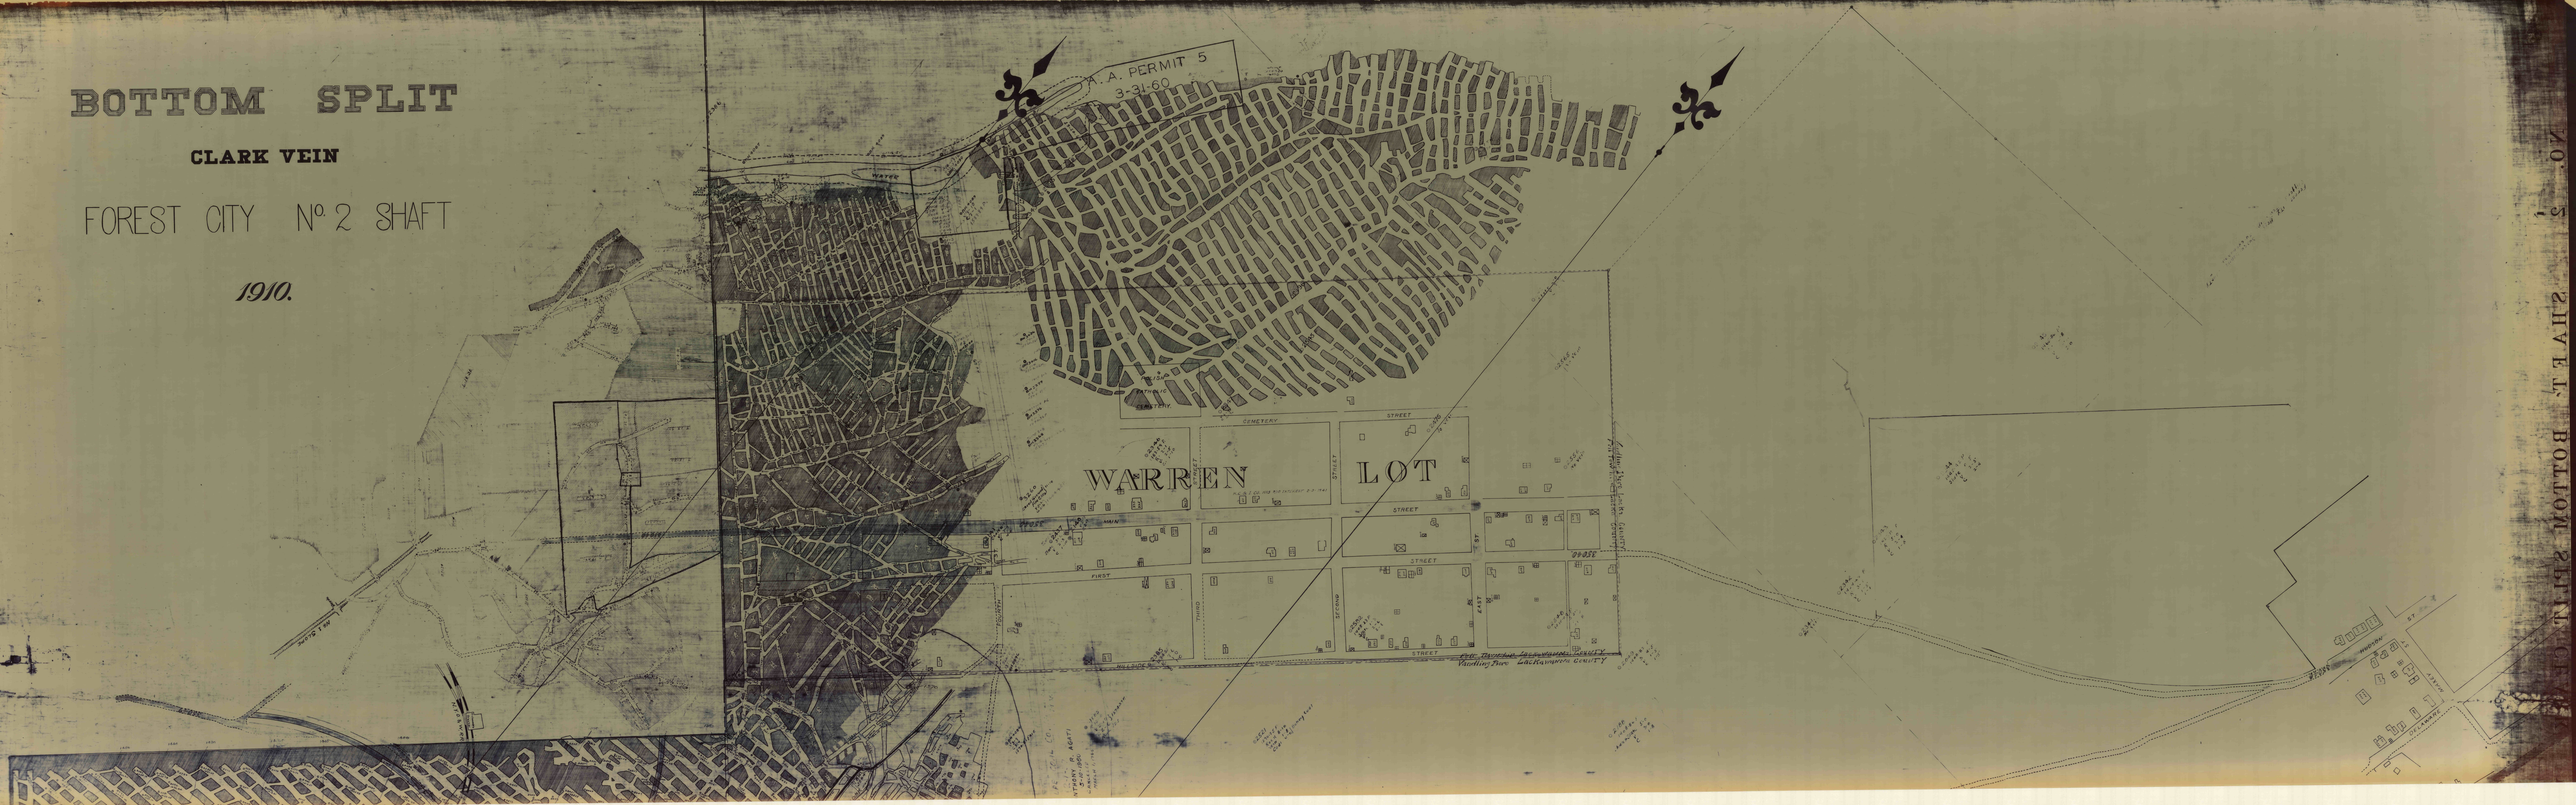

No. 2 SHAFT BOTTOM SPLIT