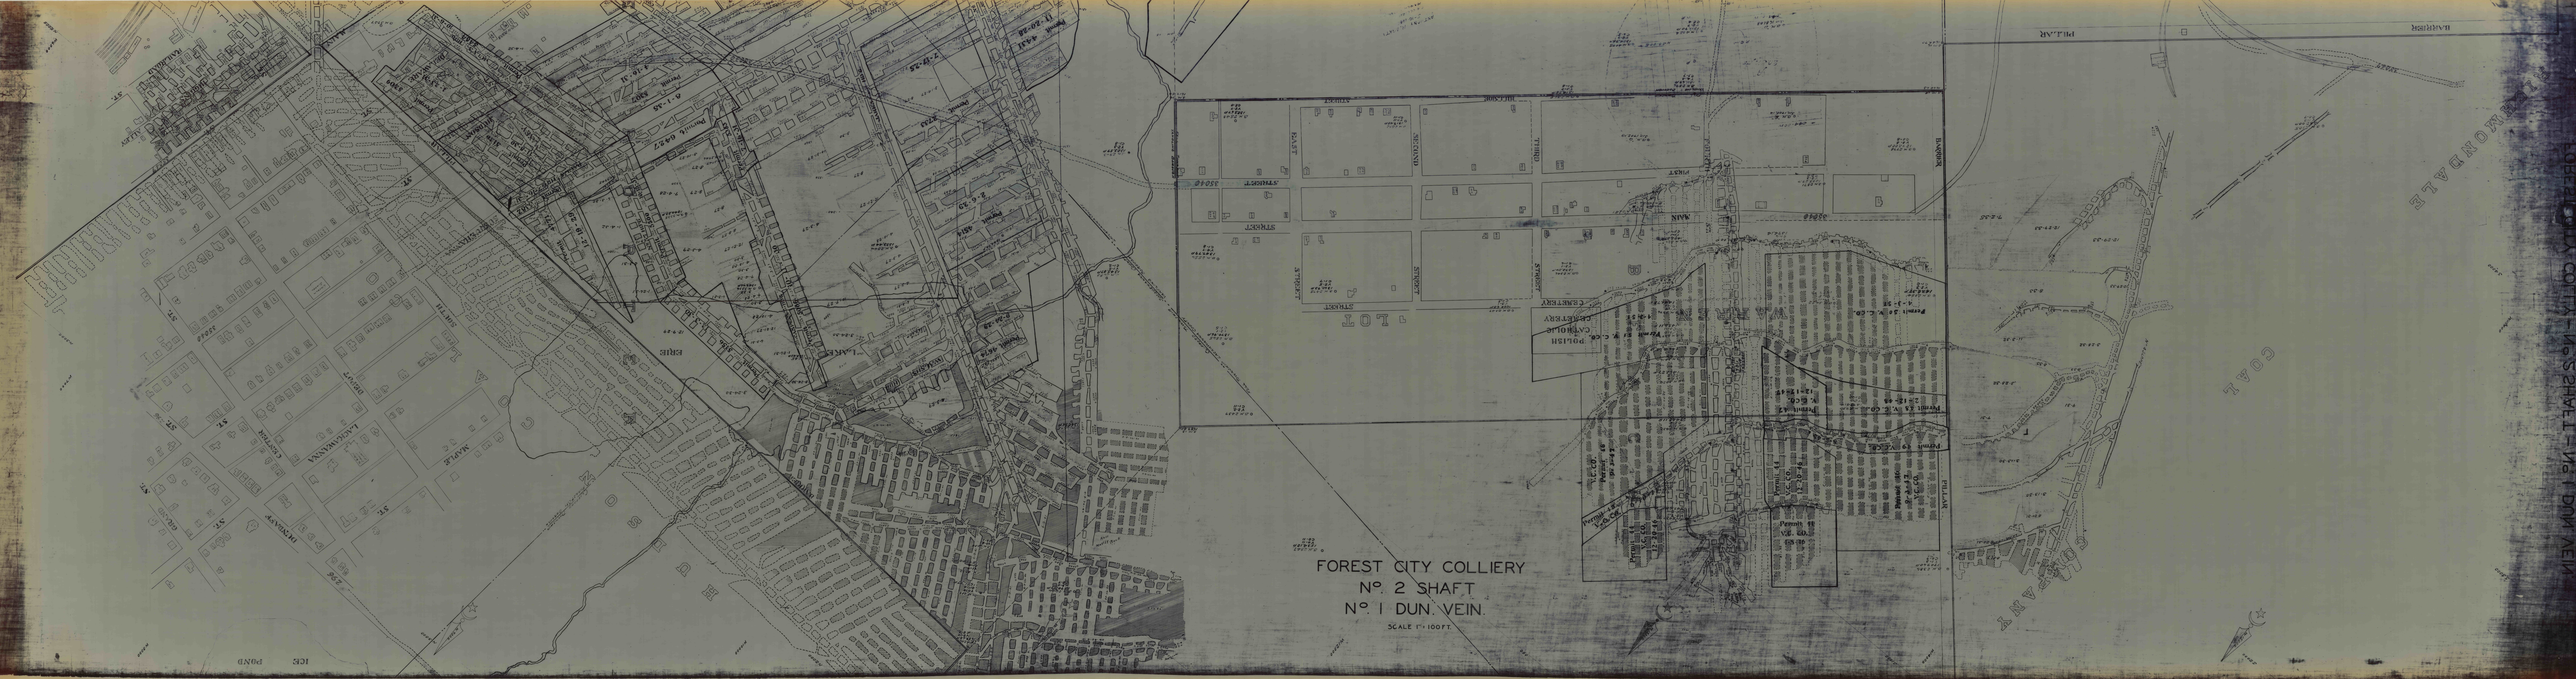
FOREST CITY COLLIERY
Nº. 2 SHAFT
Nº. 1 DUN VEIN.
SCALE 1" = 100 FT.
LACKAWANNA
COAL
COMPANY
MONDALE
MAIN
FIRST
SECOND
THIRD
