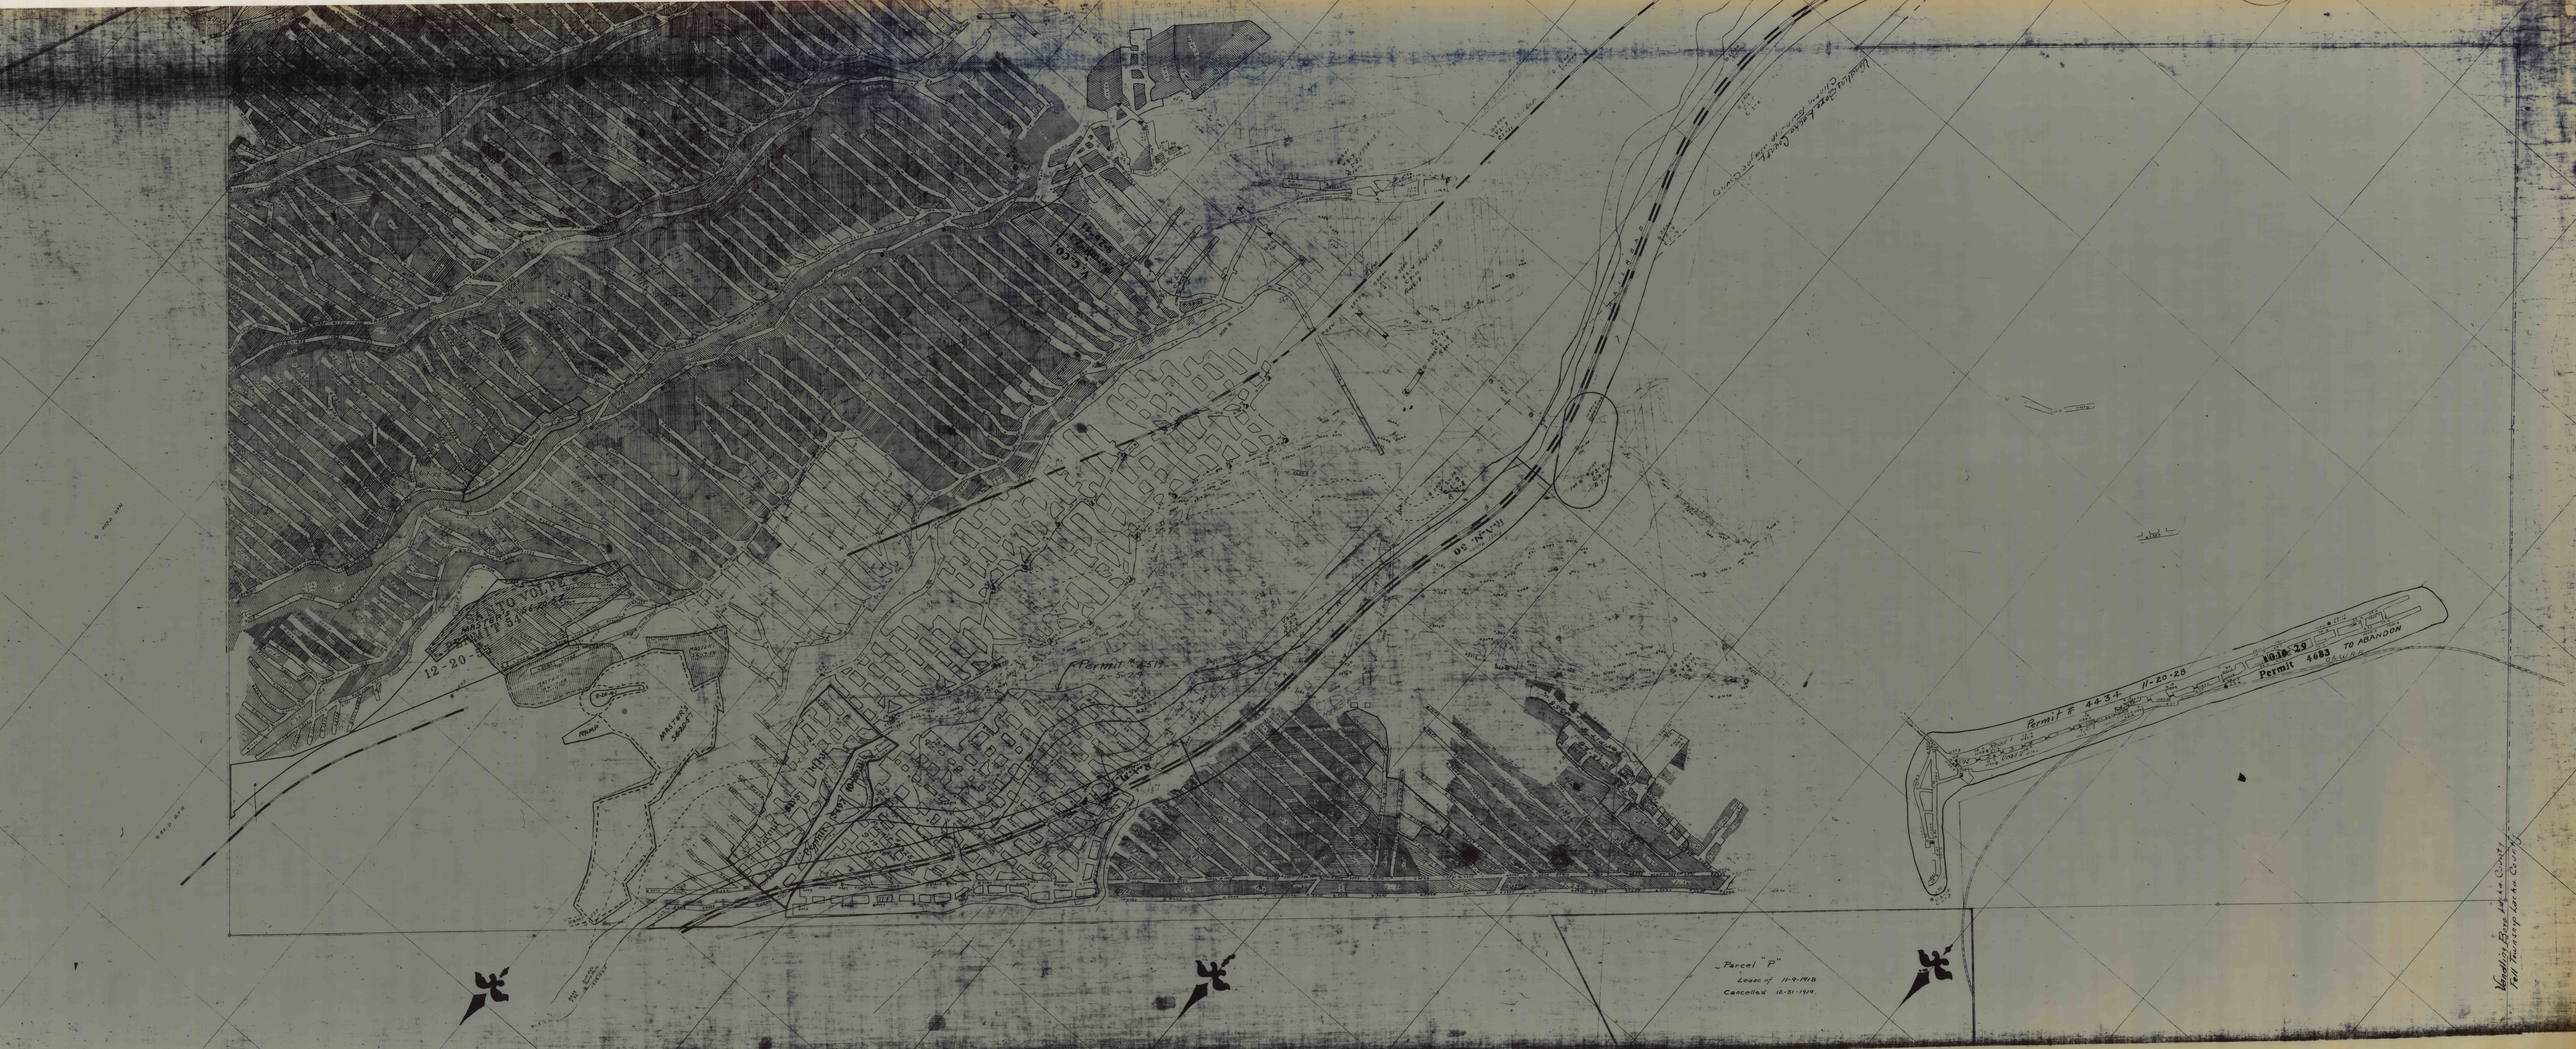
Permit #519
11-5-29
Permit #434 11-20-28
10-10-29
Permit 4683 TO ABANDON
Parcel "P"
Lease of 11-9-1918
Cancelled 12-31-1919.