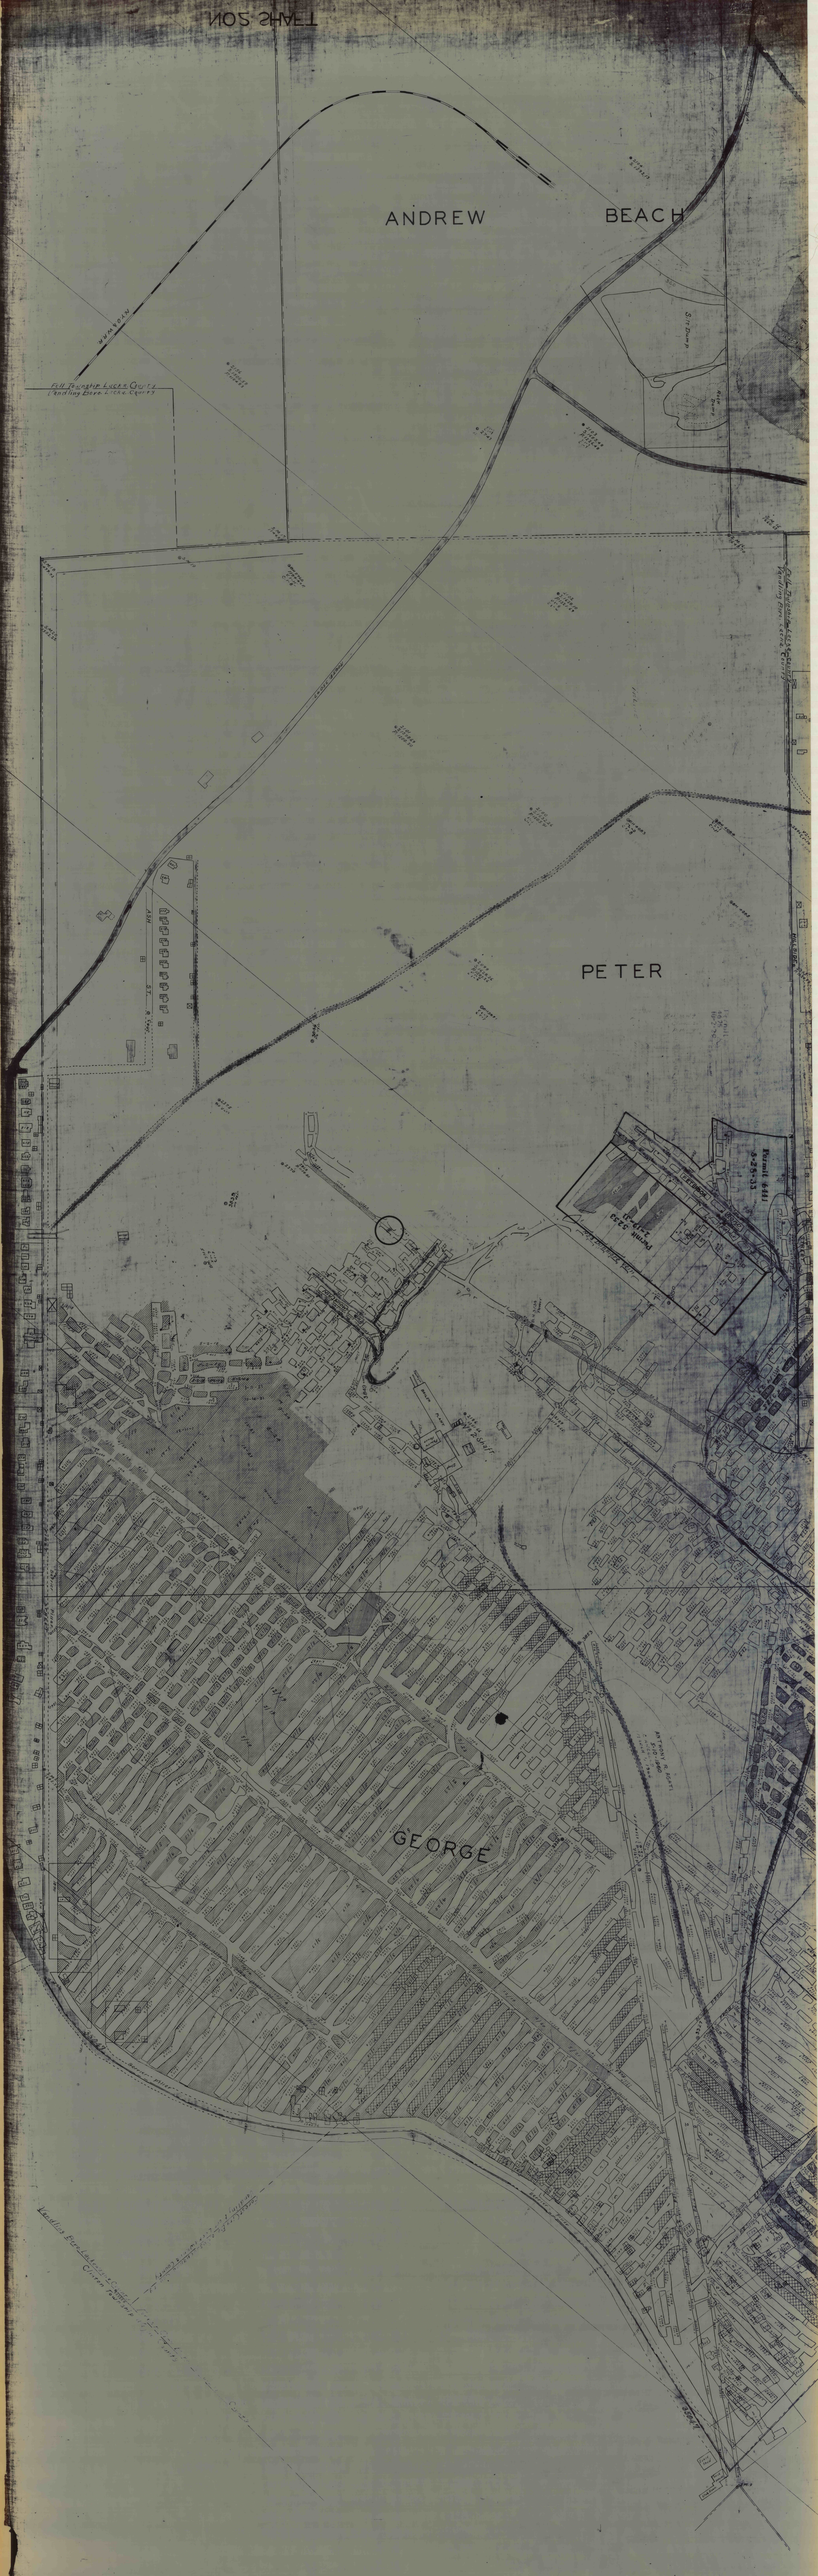
ANDREW
BEACH
PETER
GEORGE