# PETER-REUBEN GRAY
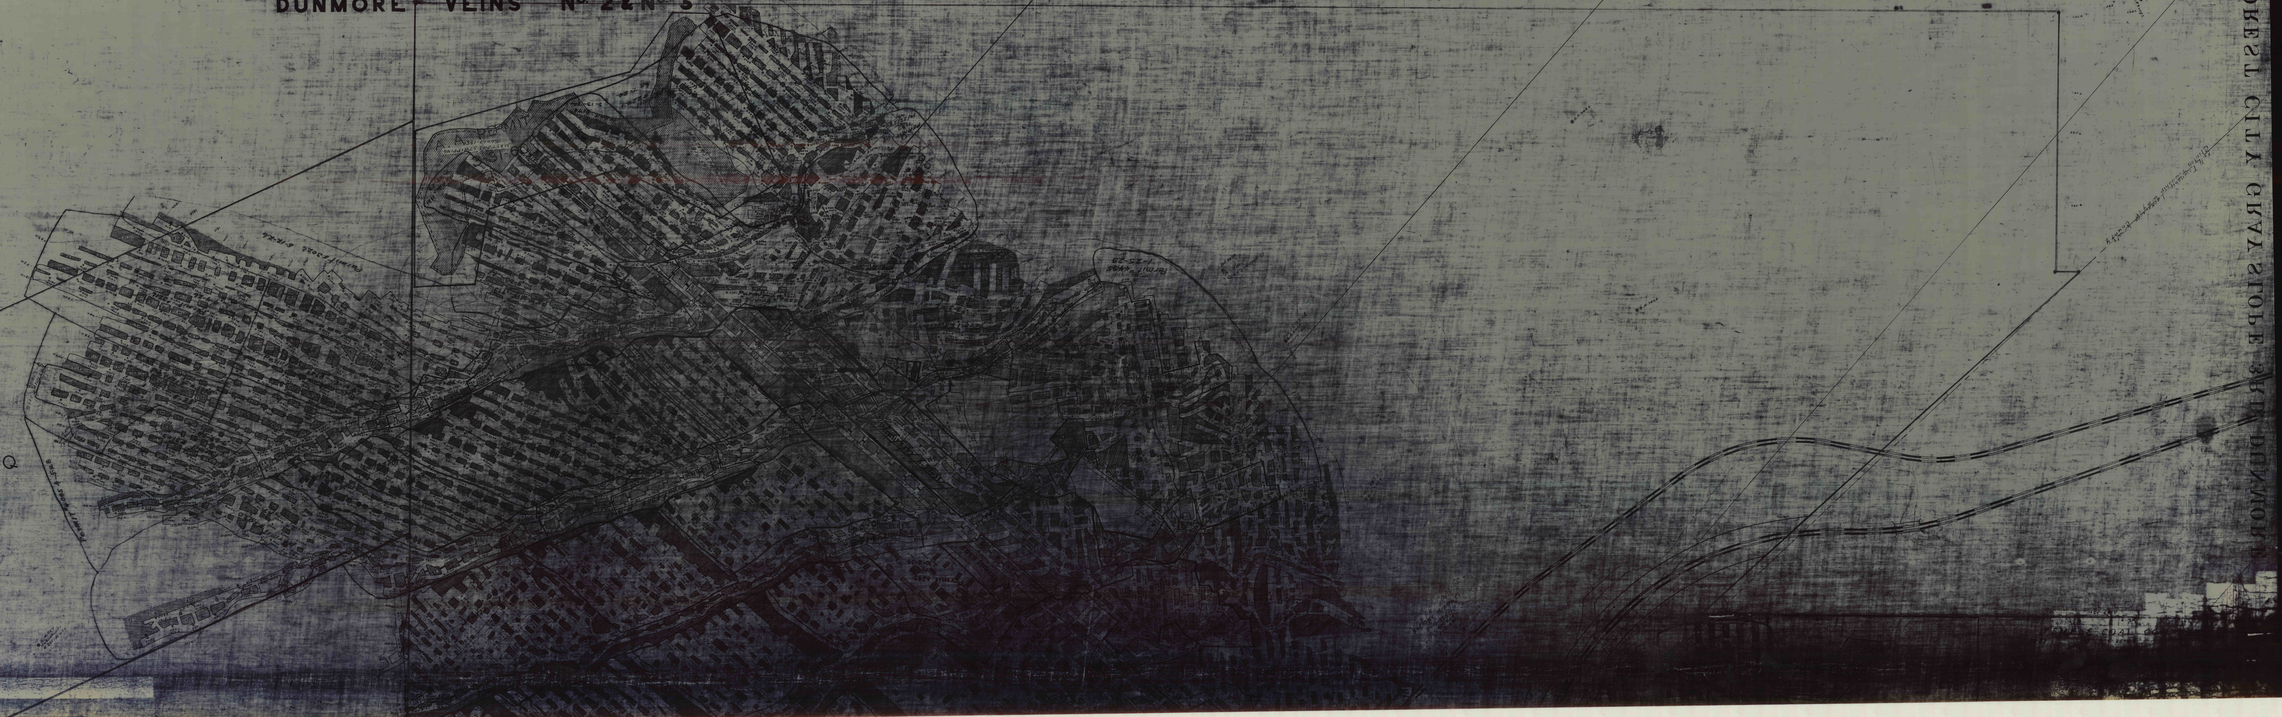
DUNMORE VEINS Nº 2 & Nº 3