


# BAST COLLIERY

SKIDMORE VEIN  
AND  
4<sup>TH</sup> LIFT DEVELOPMENTS.  
Scale 1 inch = 100 feet. Ashland, Pa. Apr. 20-1917.  
Office of Division Engineer.

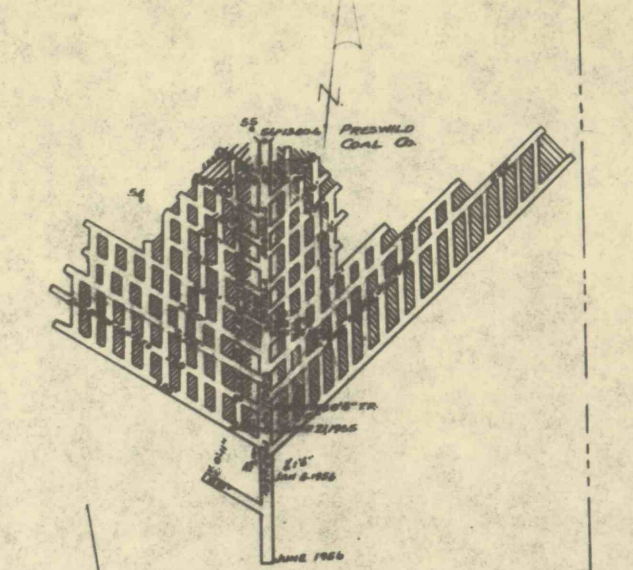







RESERVATION PILLAR

LOCUST MOUNTAIN TRACT.

PRESTON COAL AND IMPROVEMENT COMPANY TRACT.

PRESTON COAL AND IMPROVEMENT COMPANY.

GIHARD EST.

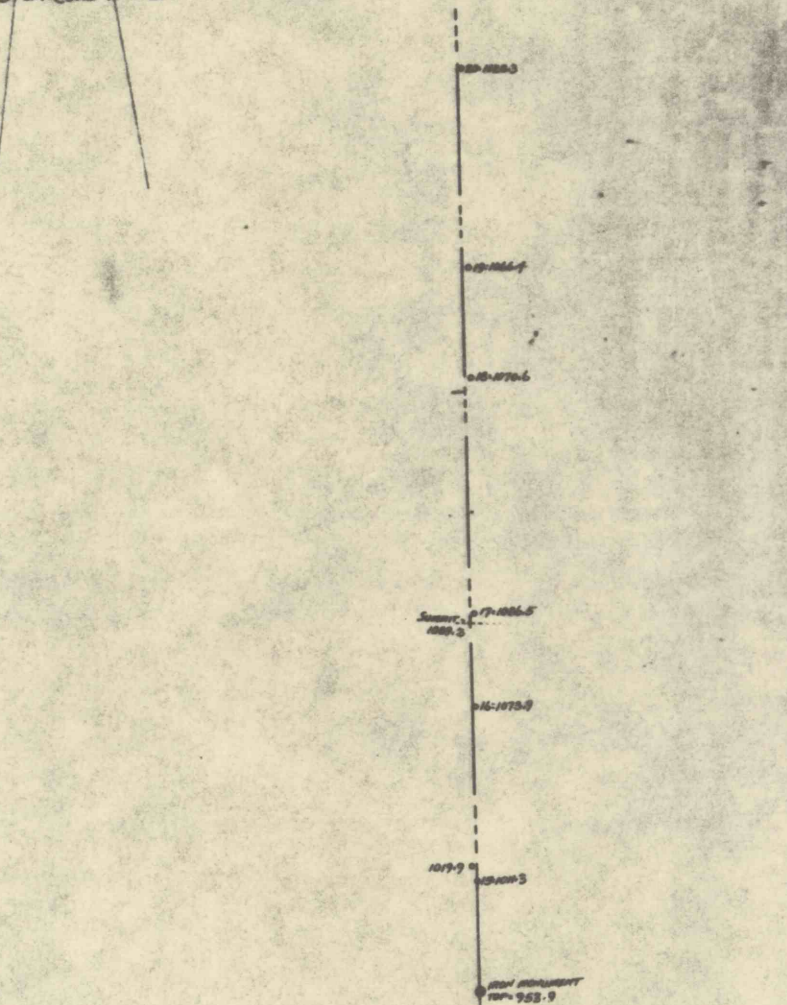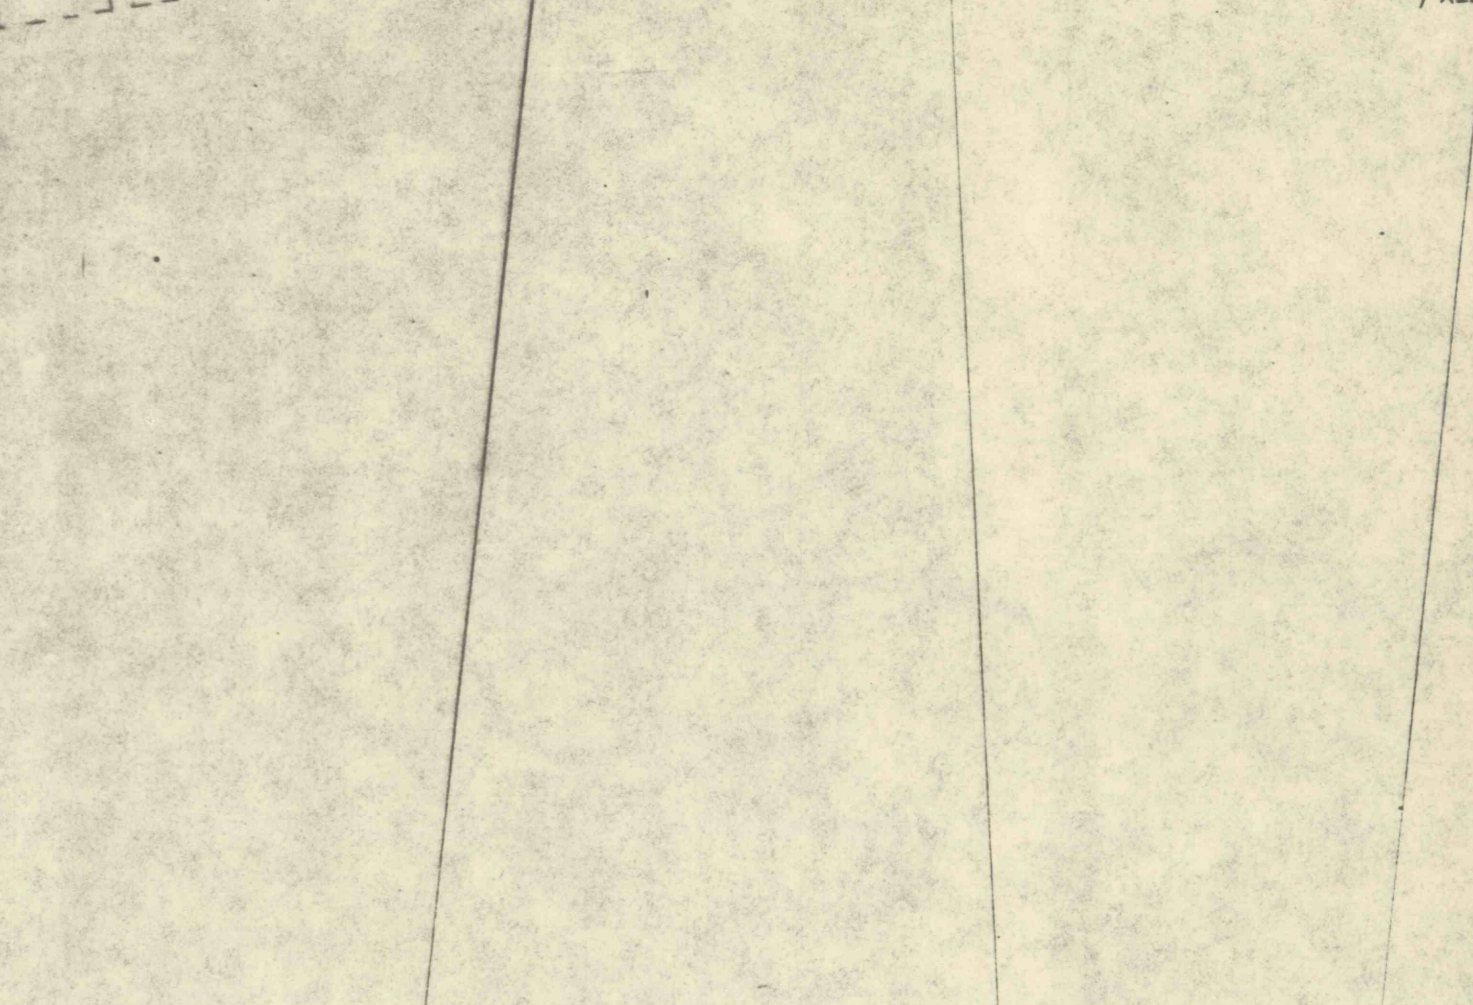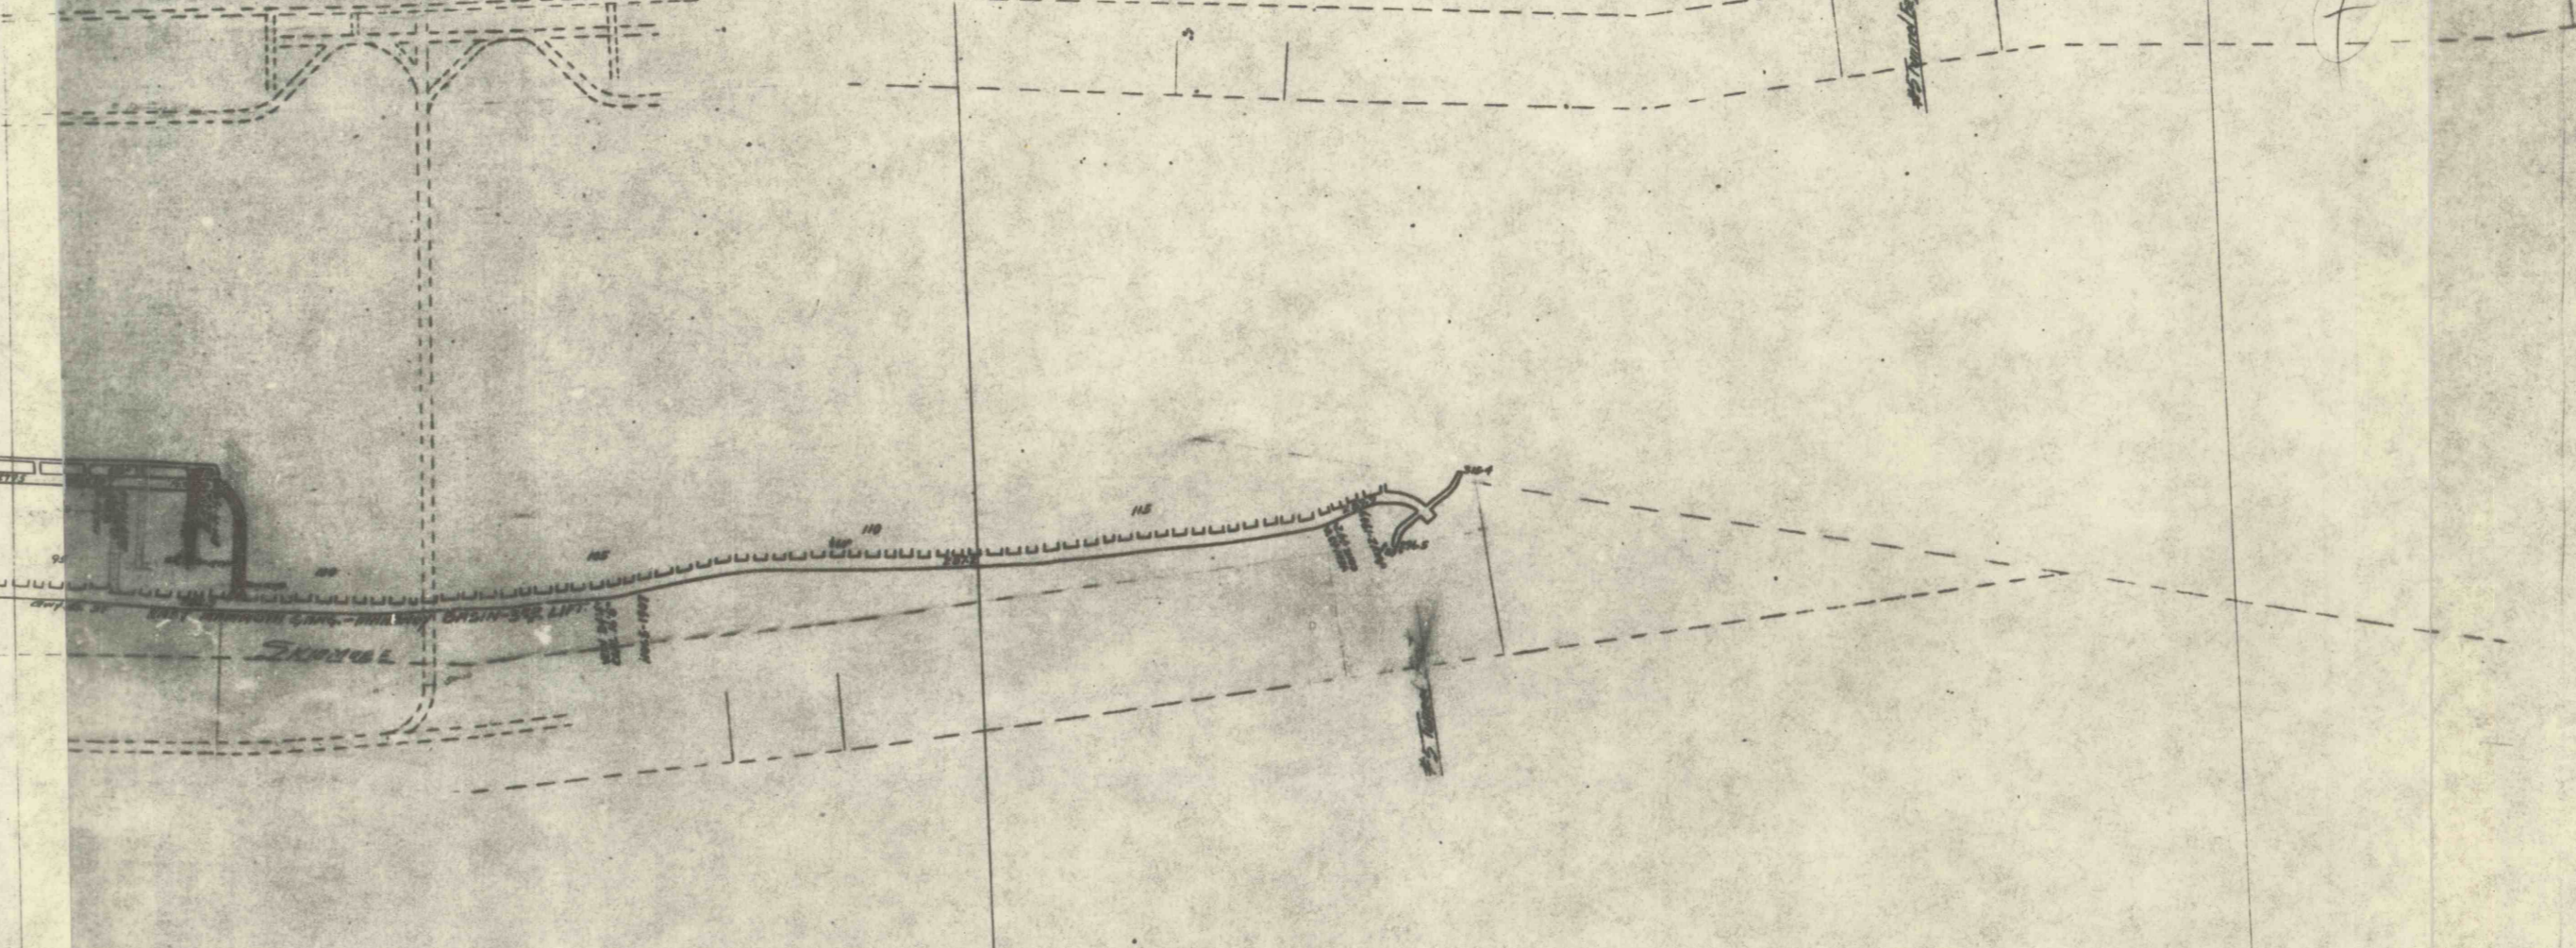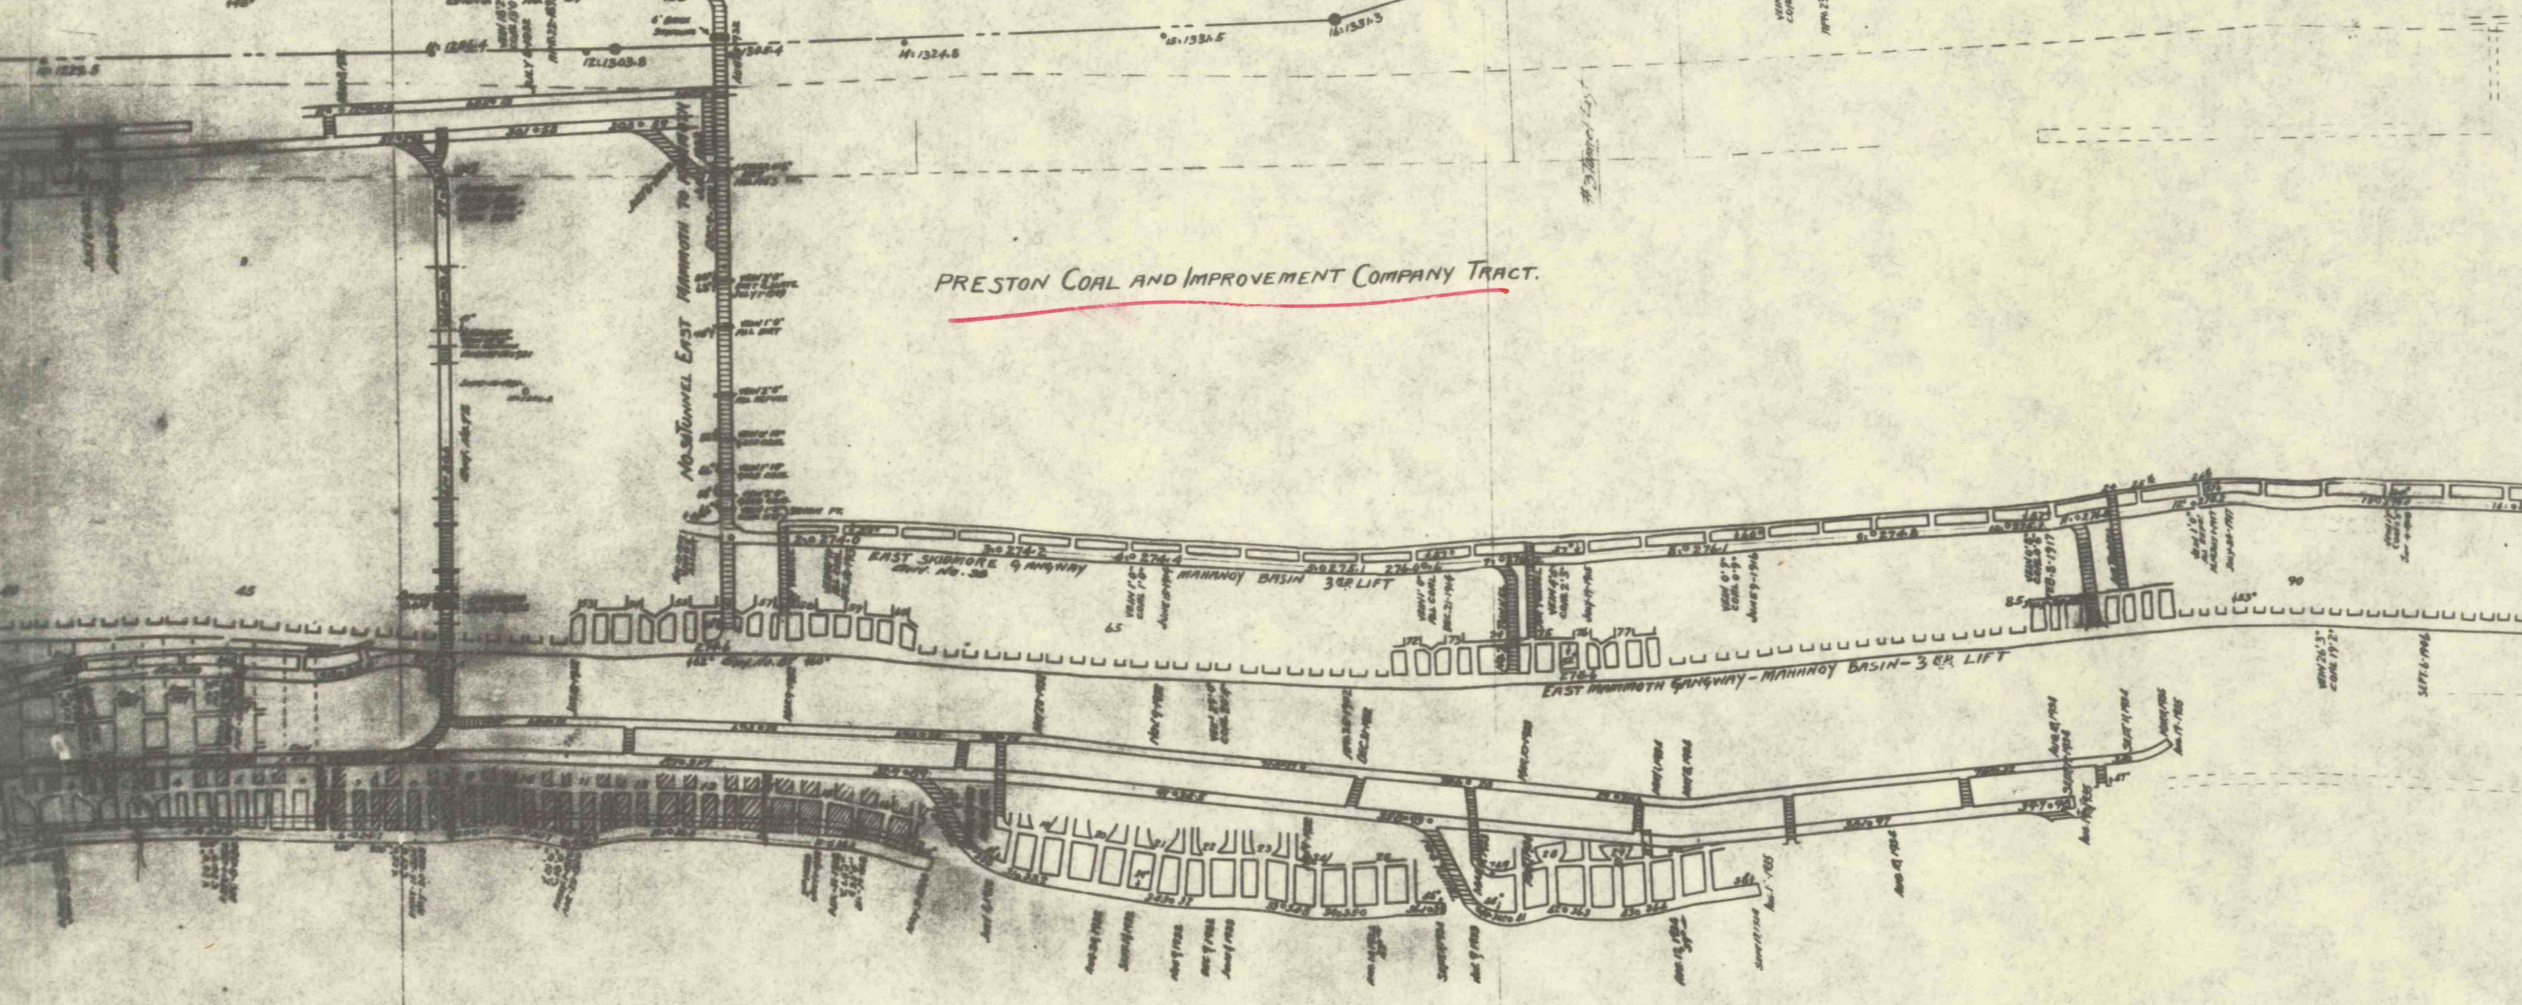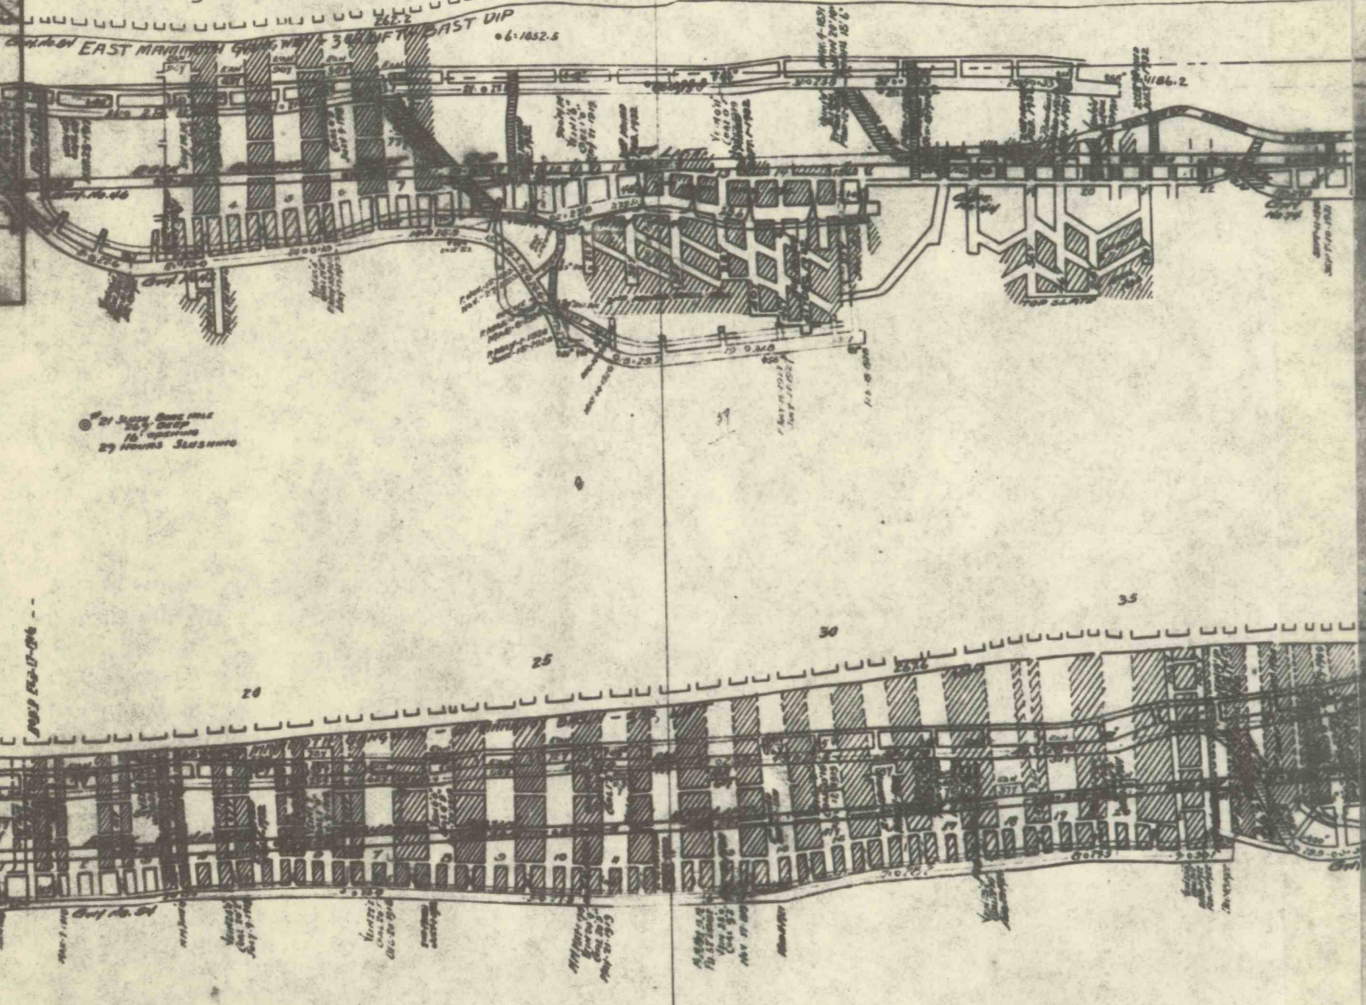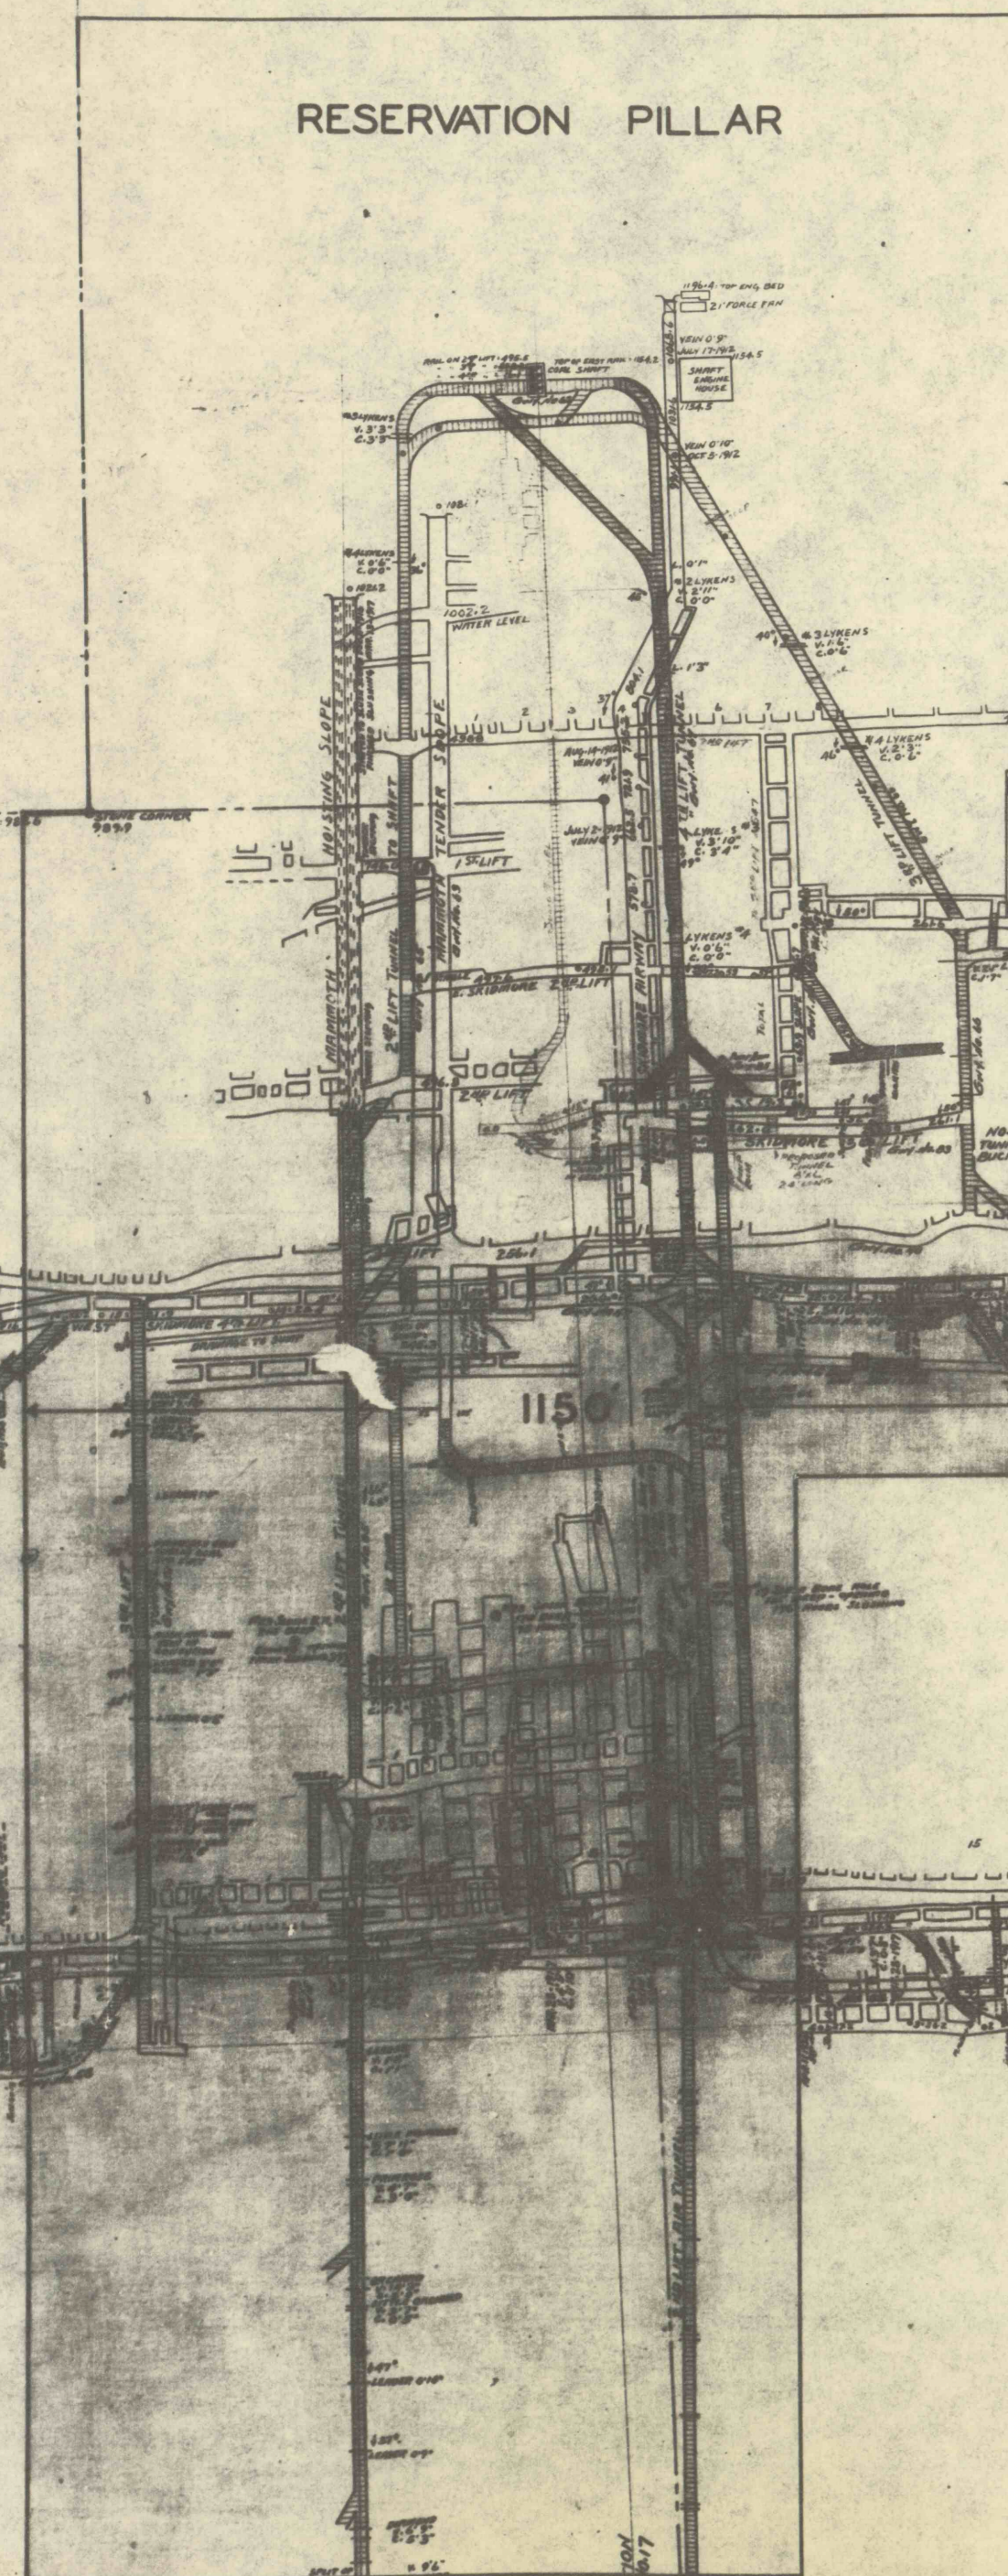

115

CROSS SECTION  
TRACING NO. 85

CROSS SECTION  
TRACING NO. 86

CROSS SECTION  
TRACING NO. 87

CROSS SECTION  
TRACING NO. 88

CROSS SECTION  
TRACING NO. 89

CROSS SECTION  
TRACING NO. 90

CROSS SECTION  
TRACING NO. 91

CROSS SECTION  
TRACING NO. 92