BAST COLLIERY

CROSS SECTION THROUGH MAHANOY BASIN ON LINE OF TUNNEL TO HOLMES VEIN FROM BUCK MOUNTAIN VEIN 2ND LIFT AT BREAST NO 102.

SCALE-100 FEET PER INCH

W. A. SEITZINGER. DIV. ENG'R.

99
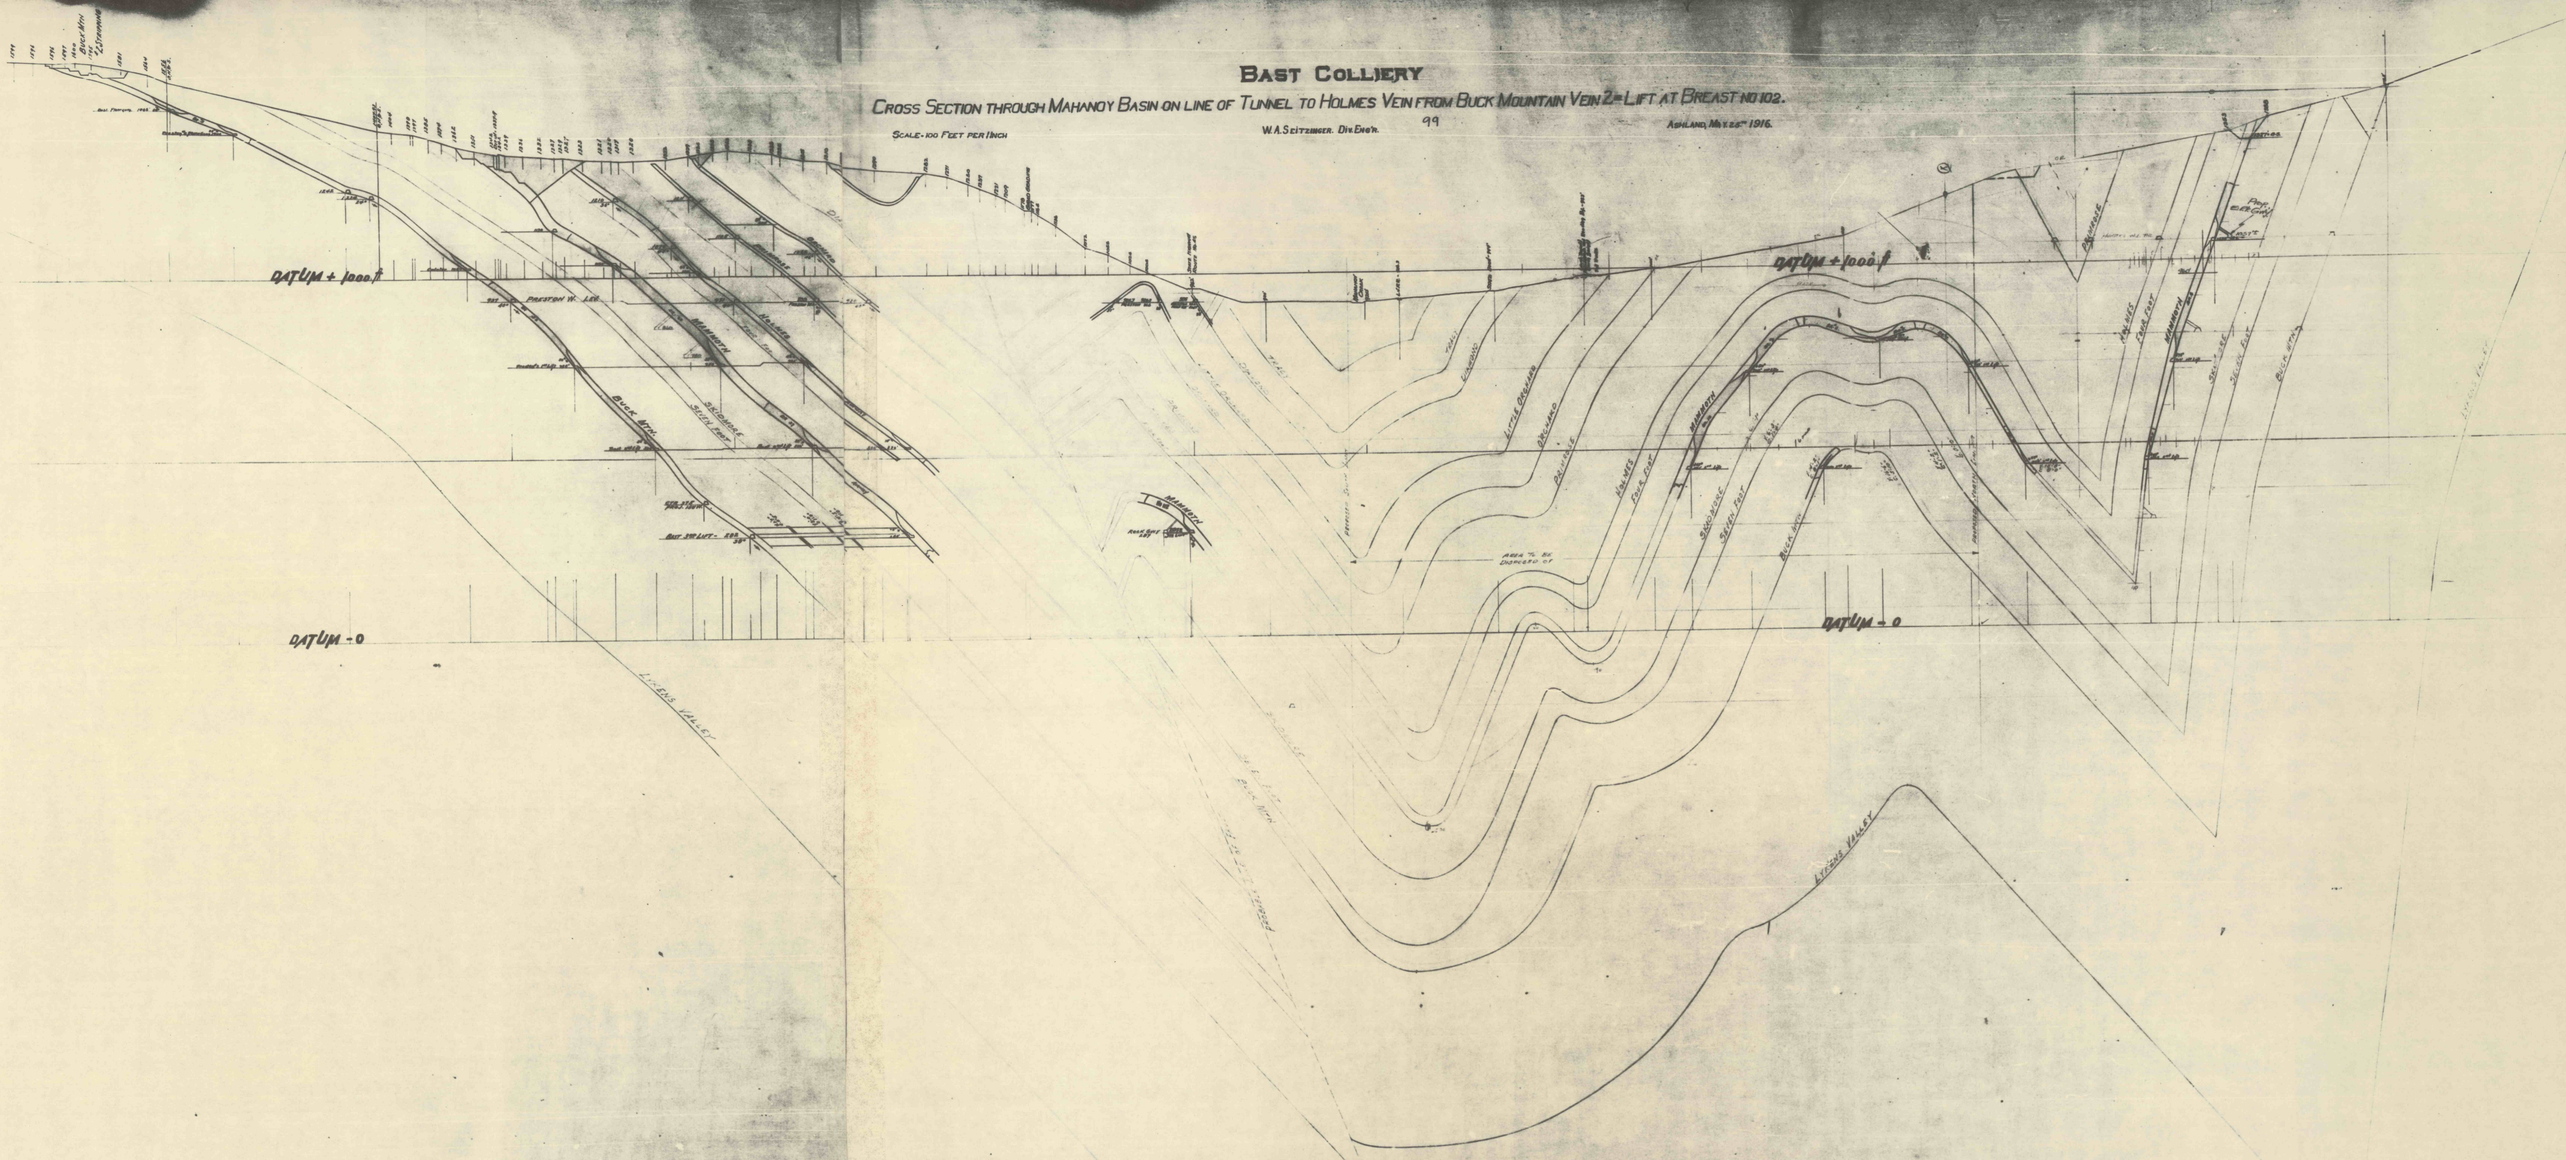
ASHLAND, MAY 22ND 1916.